


21/10/83
20/11/83

S. S. Australia Glasgow Report No. 6559.

Steel Boiler No 308
for Engines No 288, 89.
Working press. = 80 lbs



Total Heating surface = 1581 sq'
" Grate " = 50 sq'

Scale: 1" = 1 foot.

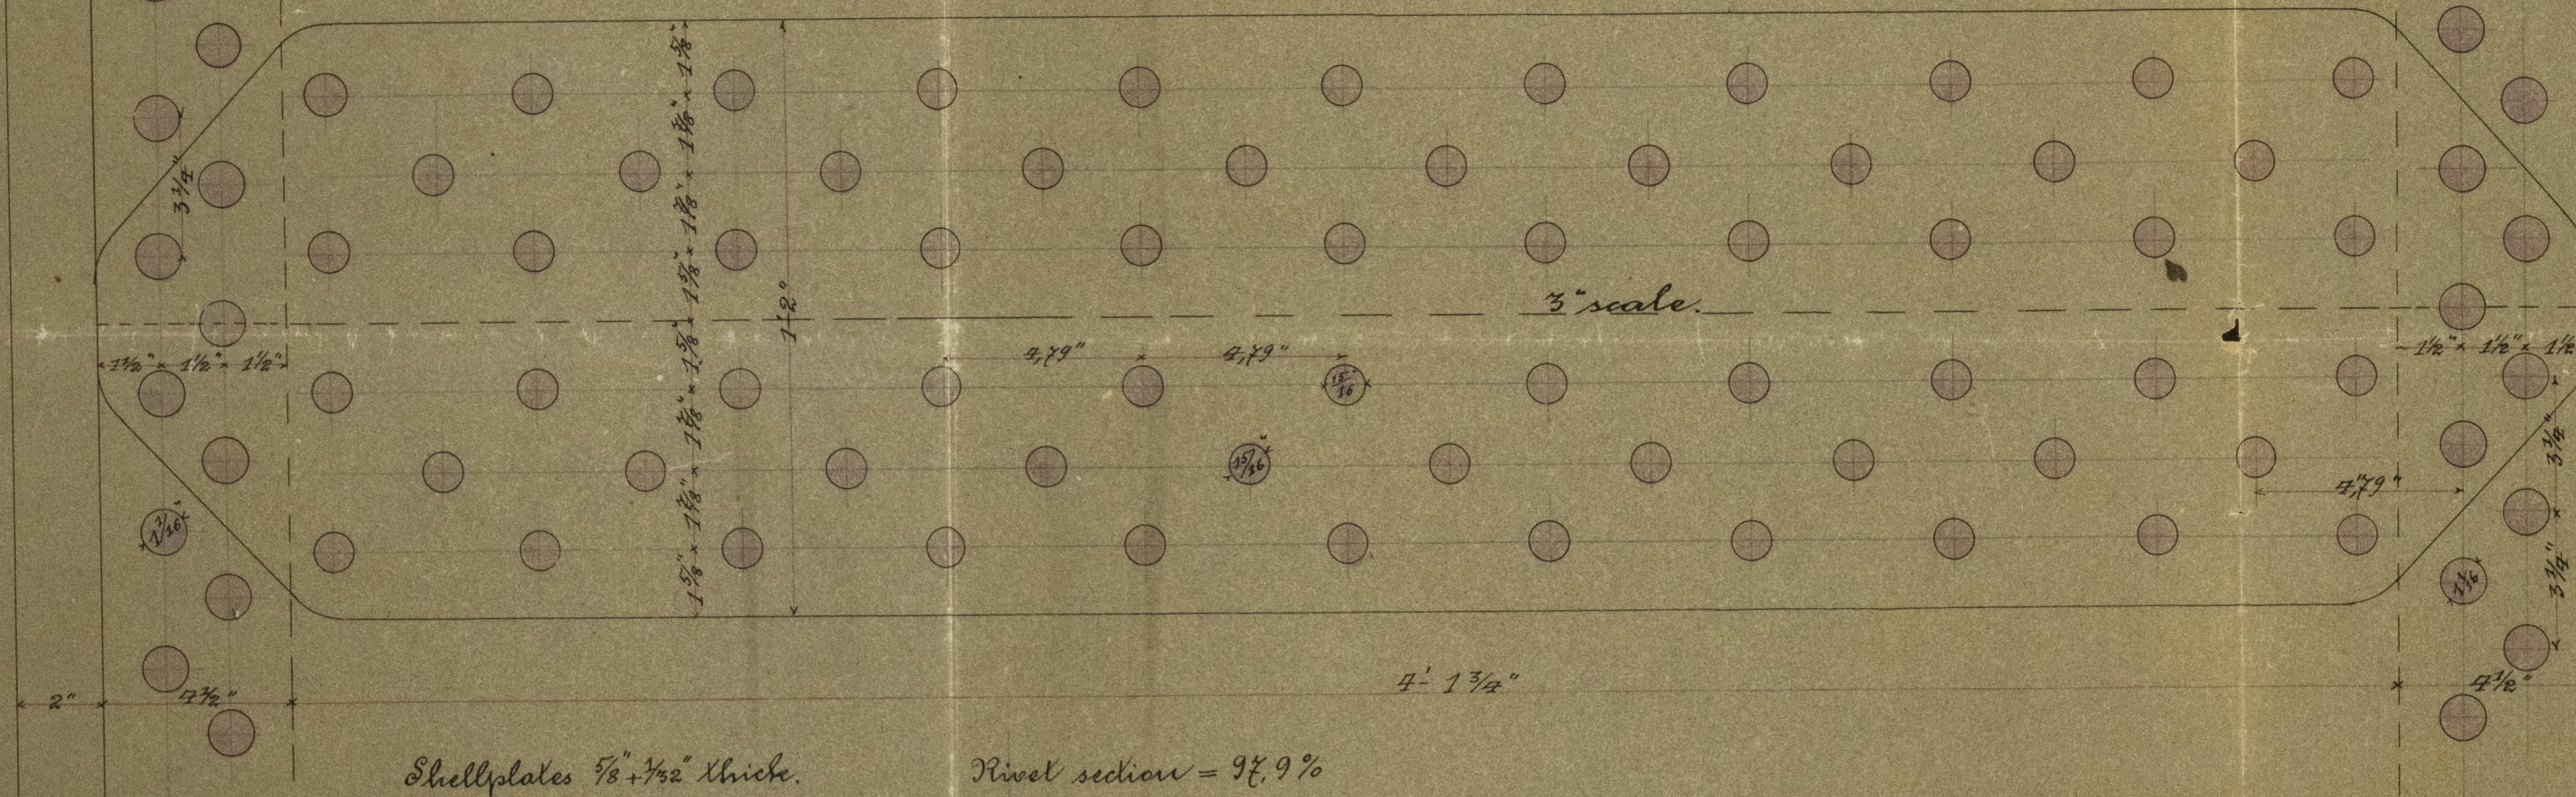


Double butt straps $\frac{1}{2}$ " each.

Plate = 80.4 %

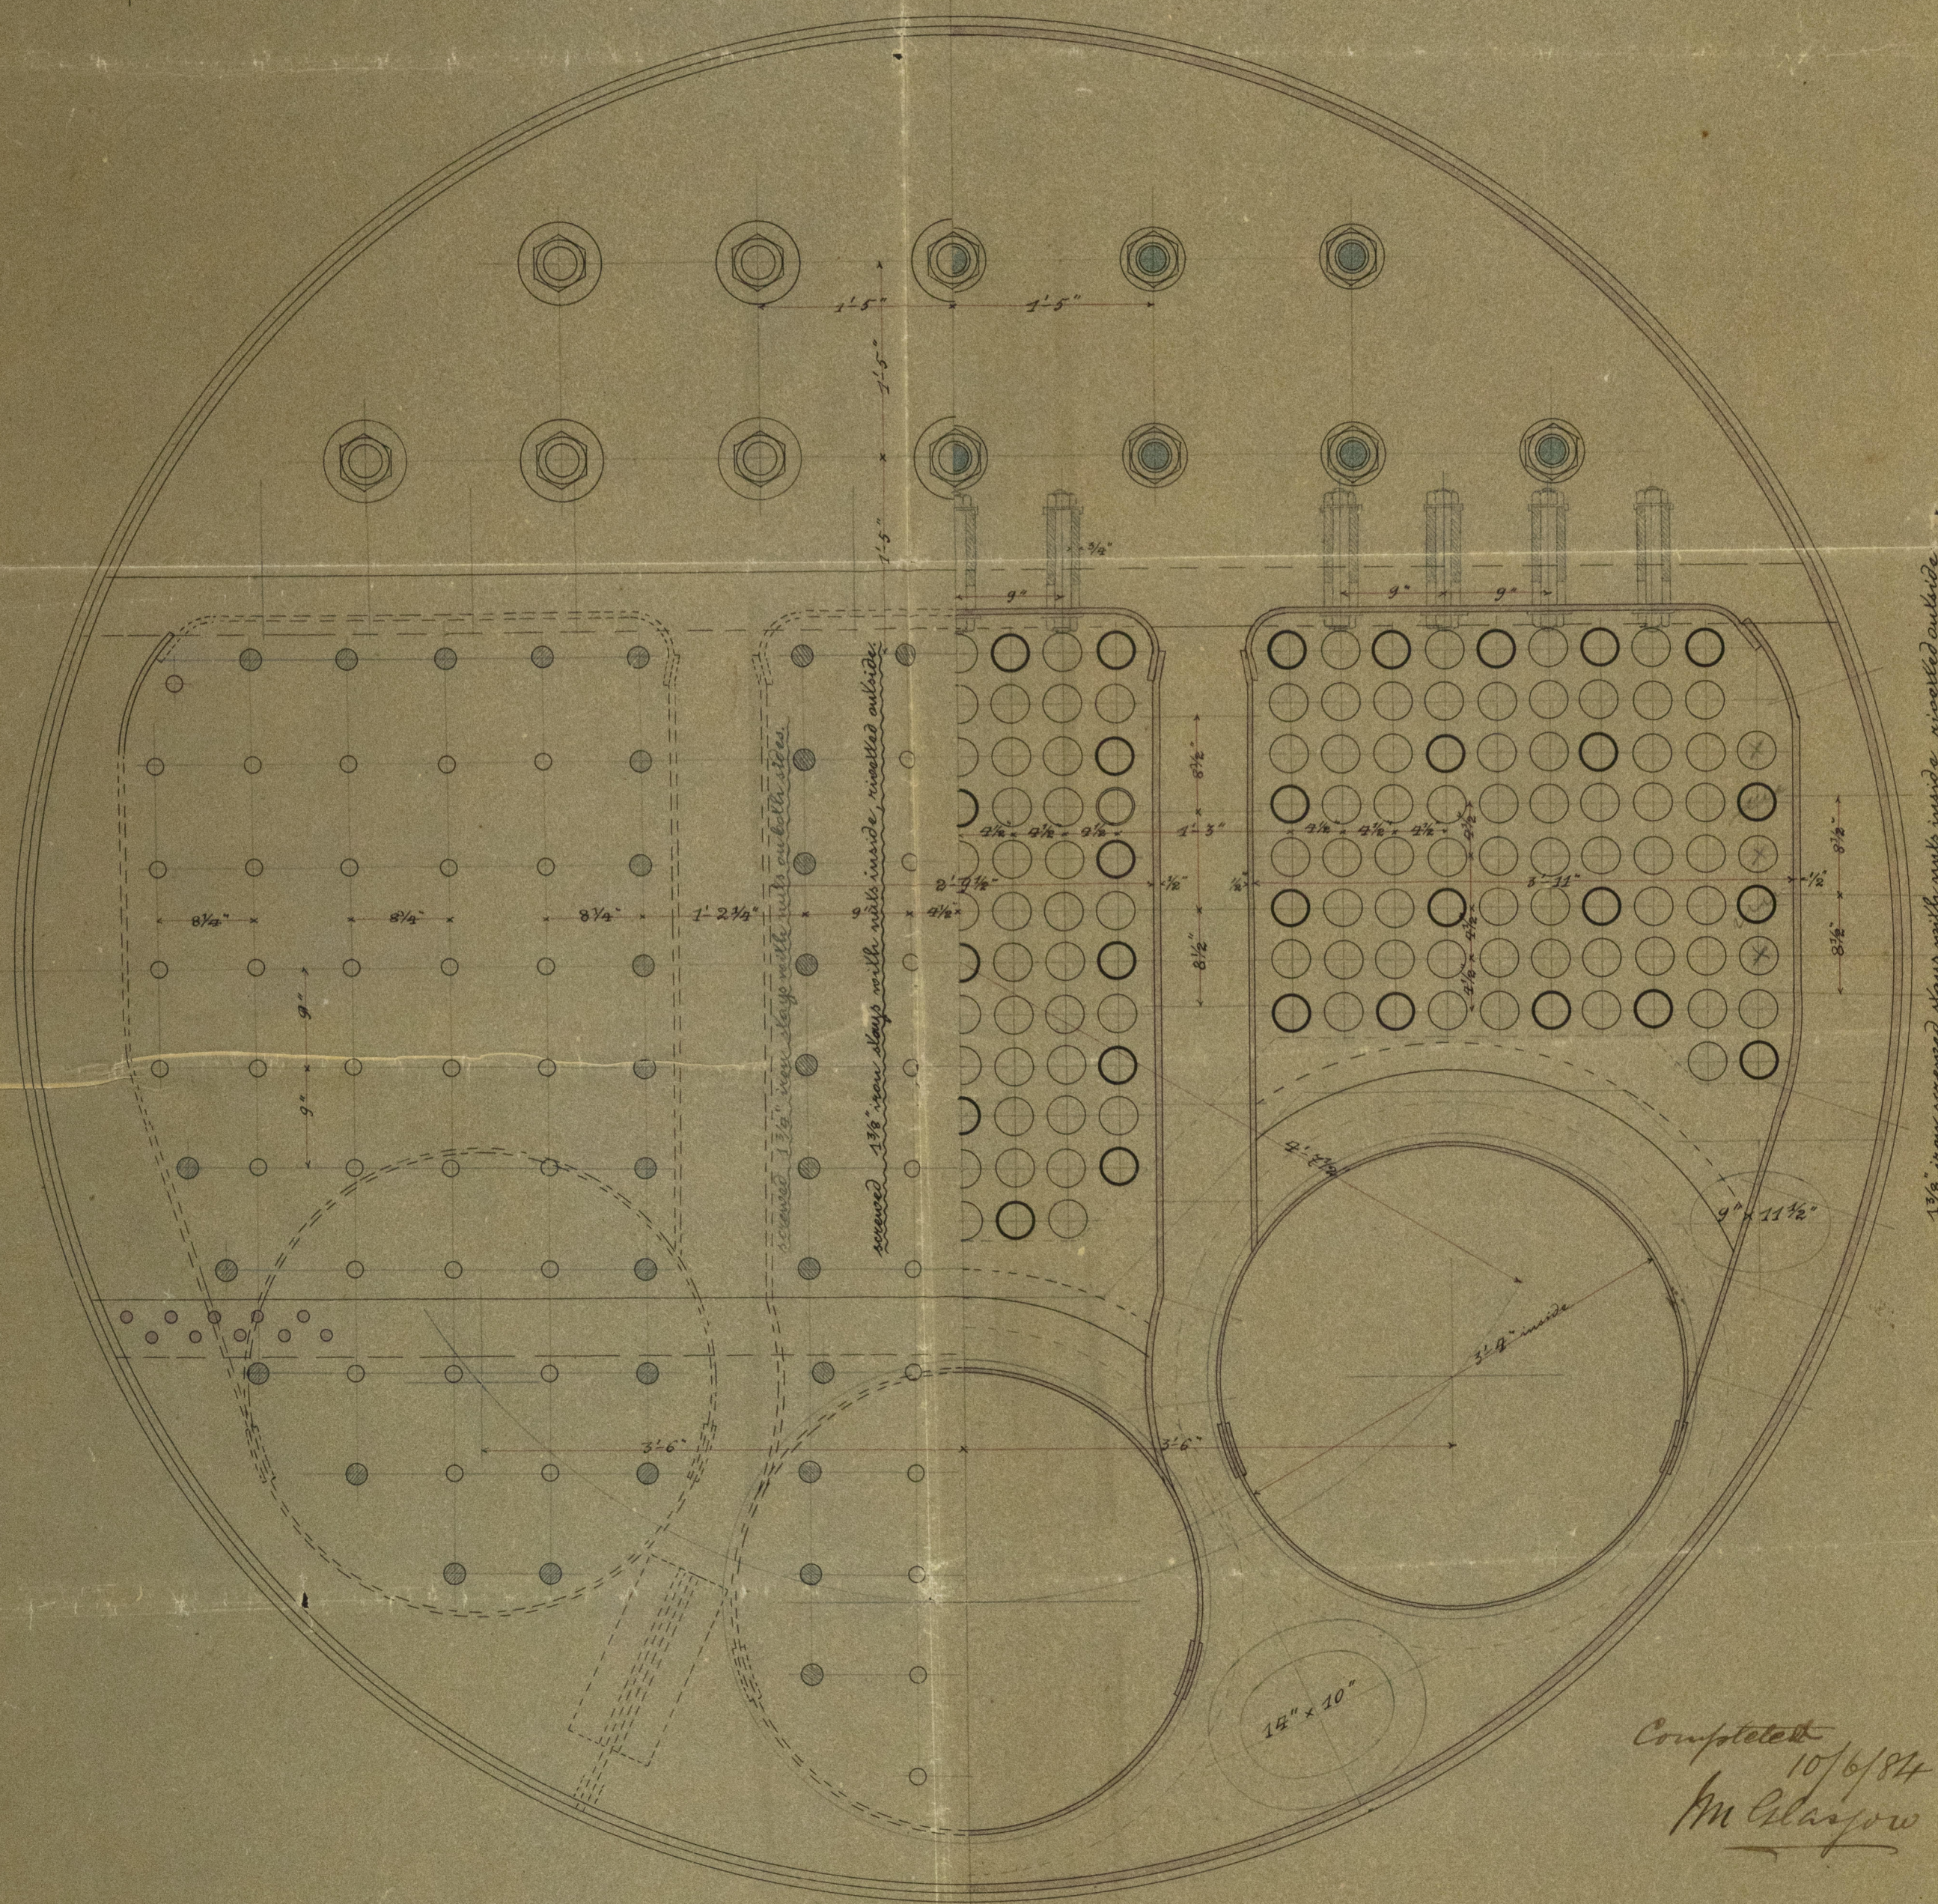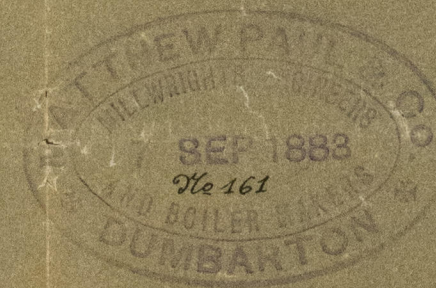

Completed
10/6/84
Am Glasgow J.M.G.
12/4/83
Clyde Desmet

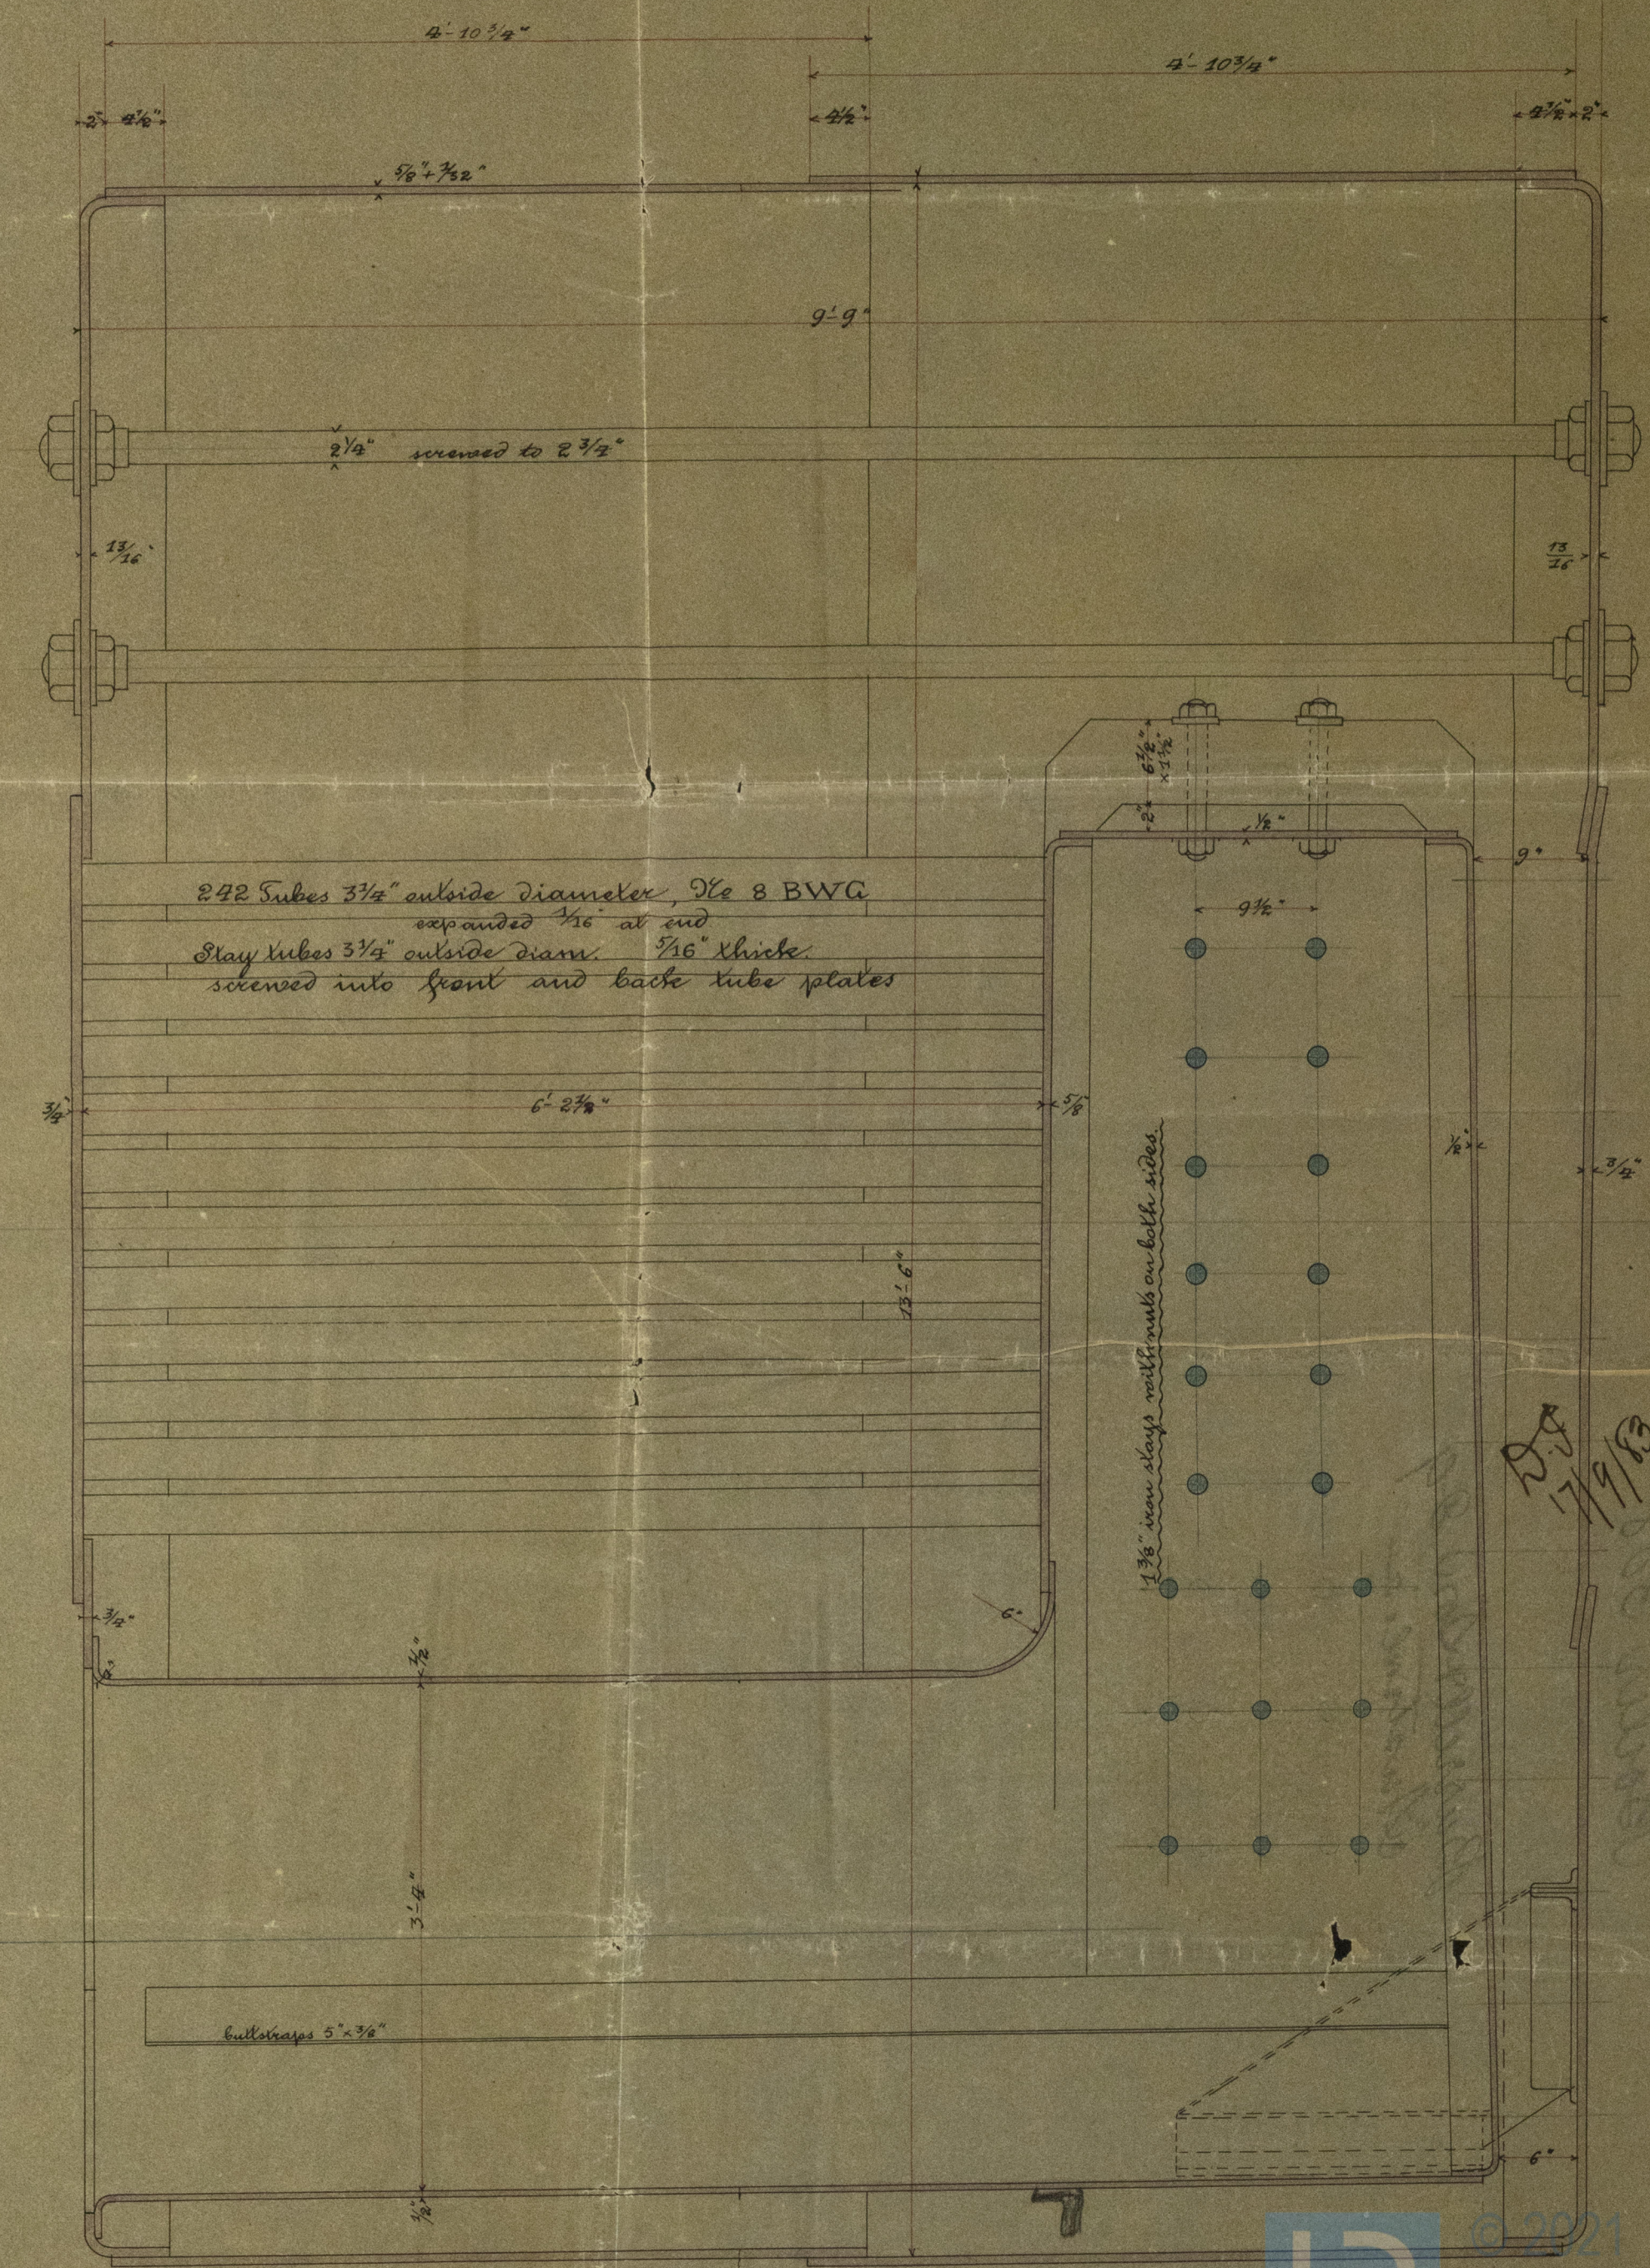

Matthew Paul
 Boiler 308-13

Burrell & Son 29
 Australia

Boiler 308-13

Boiler 308-13
 8 BMC



© 2021
 Lloyd's Register
 Foundation