



Let. to Gls.
12/7/83.

S. S. Australia

Glasgow Report

No. 6559.

(Note) Bulk Plate to be fitted on frames
at each side of Gangway $6 \times \frac{10}{32}$

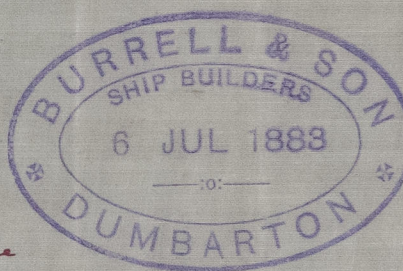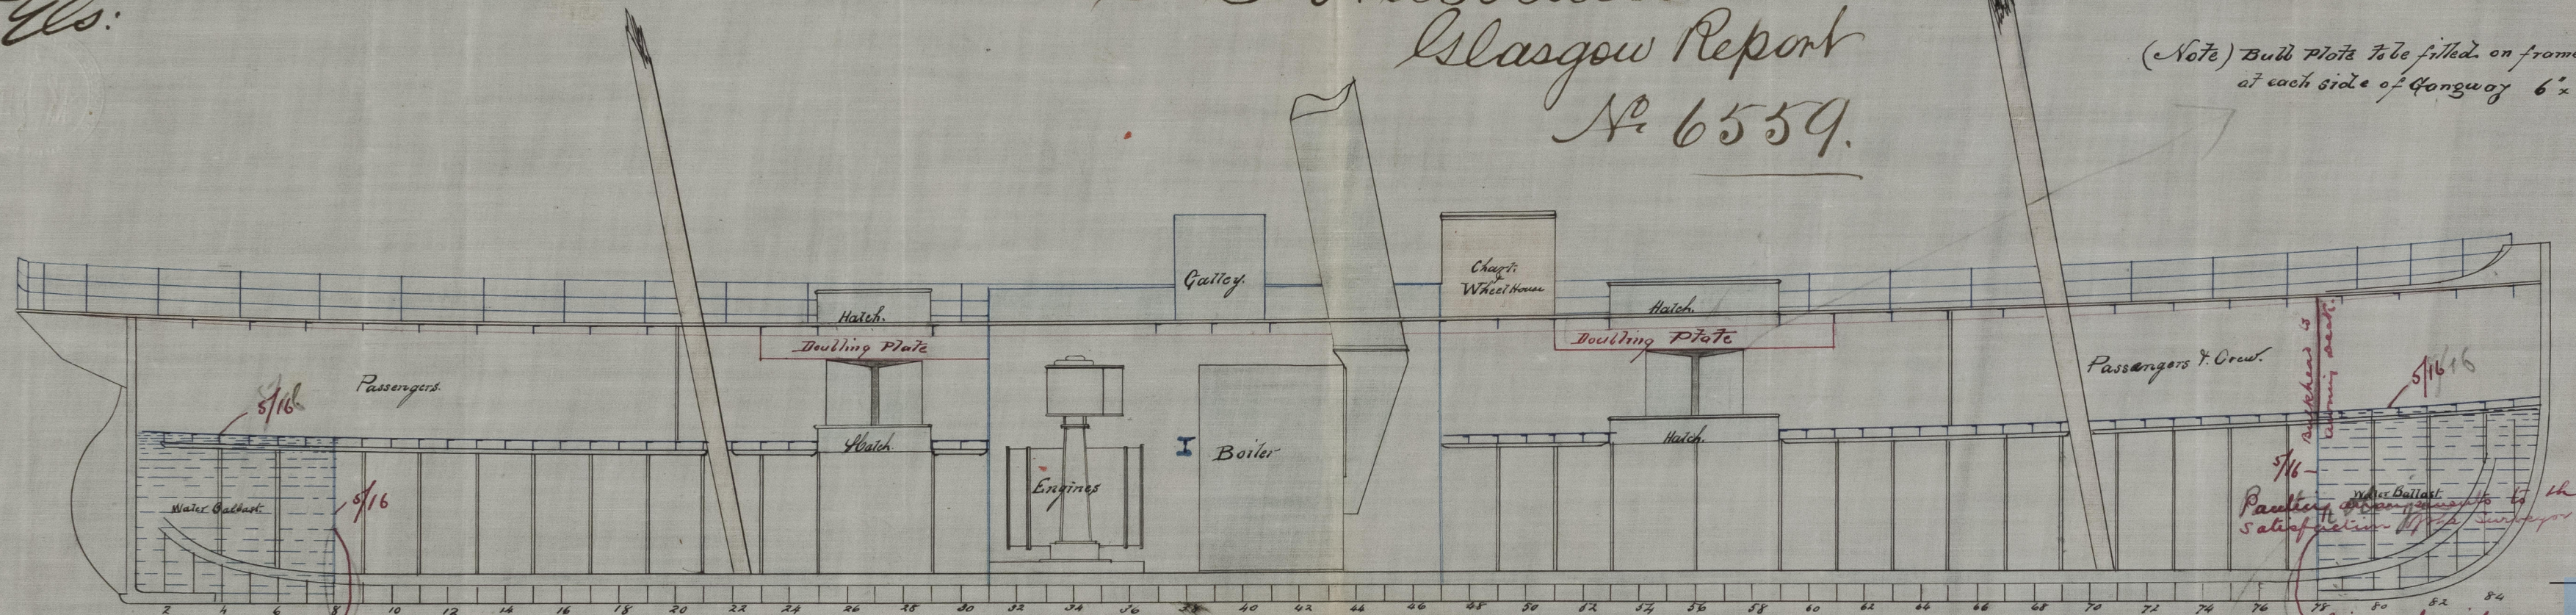

Longitudinal Plan.
of
Twin S.S. No. 29.
Scale 1/8" = One Foot.

12/7/83