

Glasgow Report No. 6559
Lloyd's Register of British and Foreign Shipping.

(Received in the London Office,)

F.

No. *546*

REPORT ON SHIP FORGINGS.

Sir,

I beg leave to report that the undermentioned Forgings, manufactured by *Wm. Rutherford & Co* of *Stynton* for the Vessel No. *29*, being built by *Wm. R. Russell & Sons* of *Dumbarton* have been inspected by me in course of being forged and smithed, and found to be, so far as can be seen, *sound and efficient.*

Mark on Forging.

Lloyd's
 No. *546*
N.C.

I am, Sir,

Your Obedient Servant,


A. Cameron

The Secretary,
 London.

Sunderland

	STERN FRAME.	RUDDER FRAME.	STEM.
Material*	<i>Scrap Iron</i>	<i>Scrap Iron</i>	<i>Scrap Iron</i>
How made	<i>Forged</i>	<i>Forged</i>	<i>Forged</i>
Dimensions	<i>6 1/4" x 1 5/8"</i>	<i>3 3/4" x 2 1/4"</i>	<i>6 1/4" x 1 5/8"</i>
Progress on Inspection	<i>Forging Smithing</i>	<i>Forging Smithing</i>	<i>Forging Smithing</i>
Dates when Inspected	<i>Oct 4-12-29 Nov 7/83</i>	<i>Nov 7-16-22-29 Dec 8 13-19/83 Jan 3/84</i>	<i>Oct 4-12-29 Nov 7/83</i>

SKETCHES OF FRAMES SHEWING POSITION AND DESCRIPTION OF WELDS.

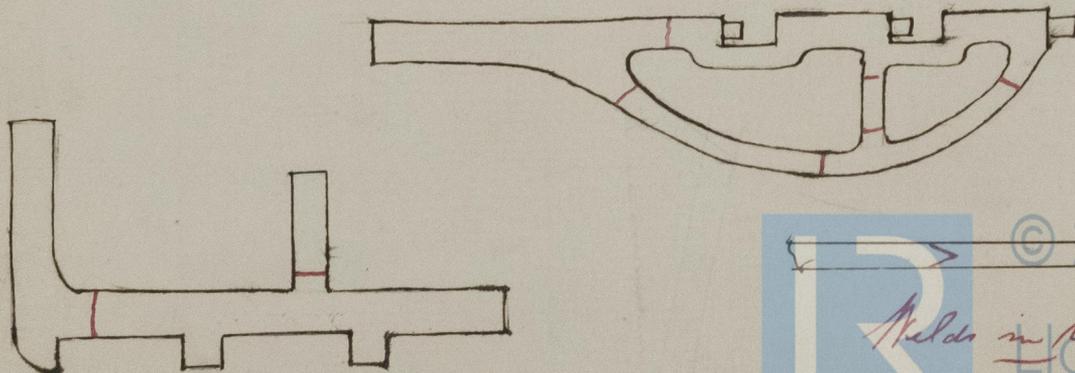

* If of iron, state whether scrap or puddled iron.

