


RECEIVED
JUN 24 1884

S. S. "Gran Chaco" Argentino

Scale $\frac{1}{2}$ " = 1 Foot

Glasgow Report
No 6594.

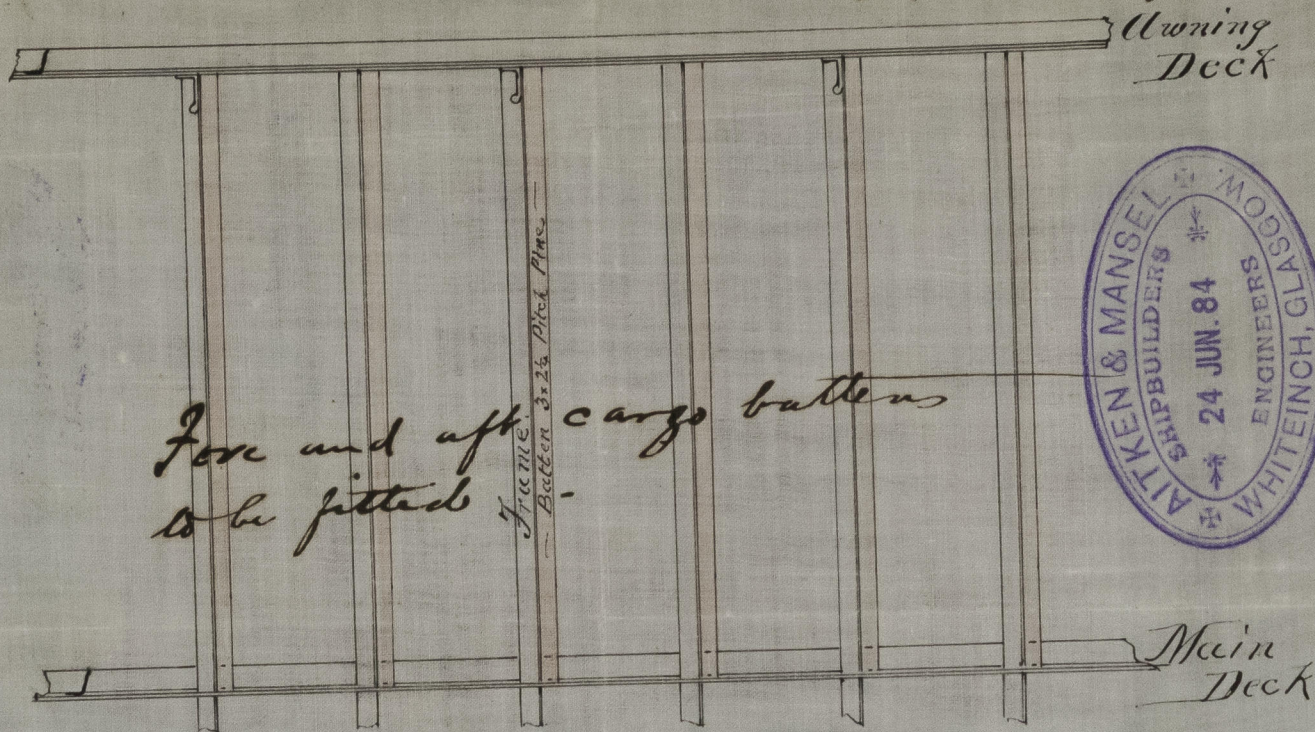

See letter to
Glasgow 27/6/84
C.B.



© 2021

Lloyd's Register
Foundation