



S. S. N° 129.

S. S. Gran Chaco Argentino
Glasgow Report
N° 6594.

Amended.
SCALE $\frac{1}{2}$ INCH TO A FOOT.

DIMENSIONS:- 200' x 28' x 11' 0" HOLD.

CLASS:- "100A AWNING DECK STEEL"

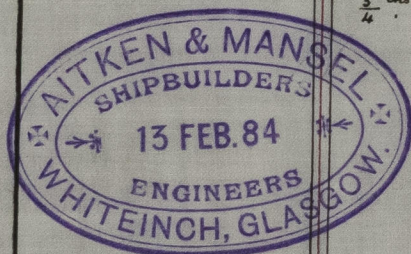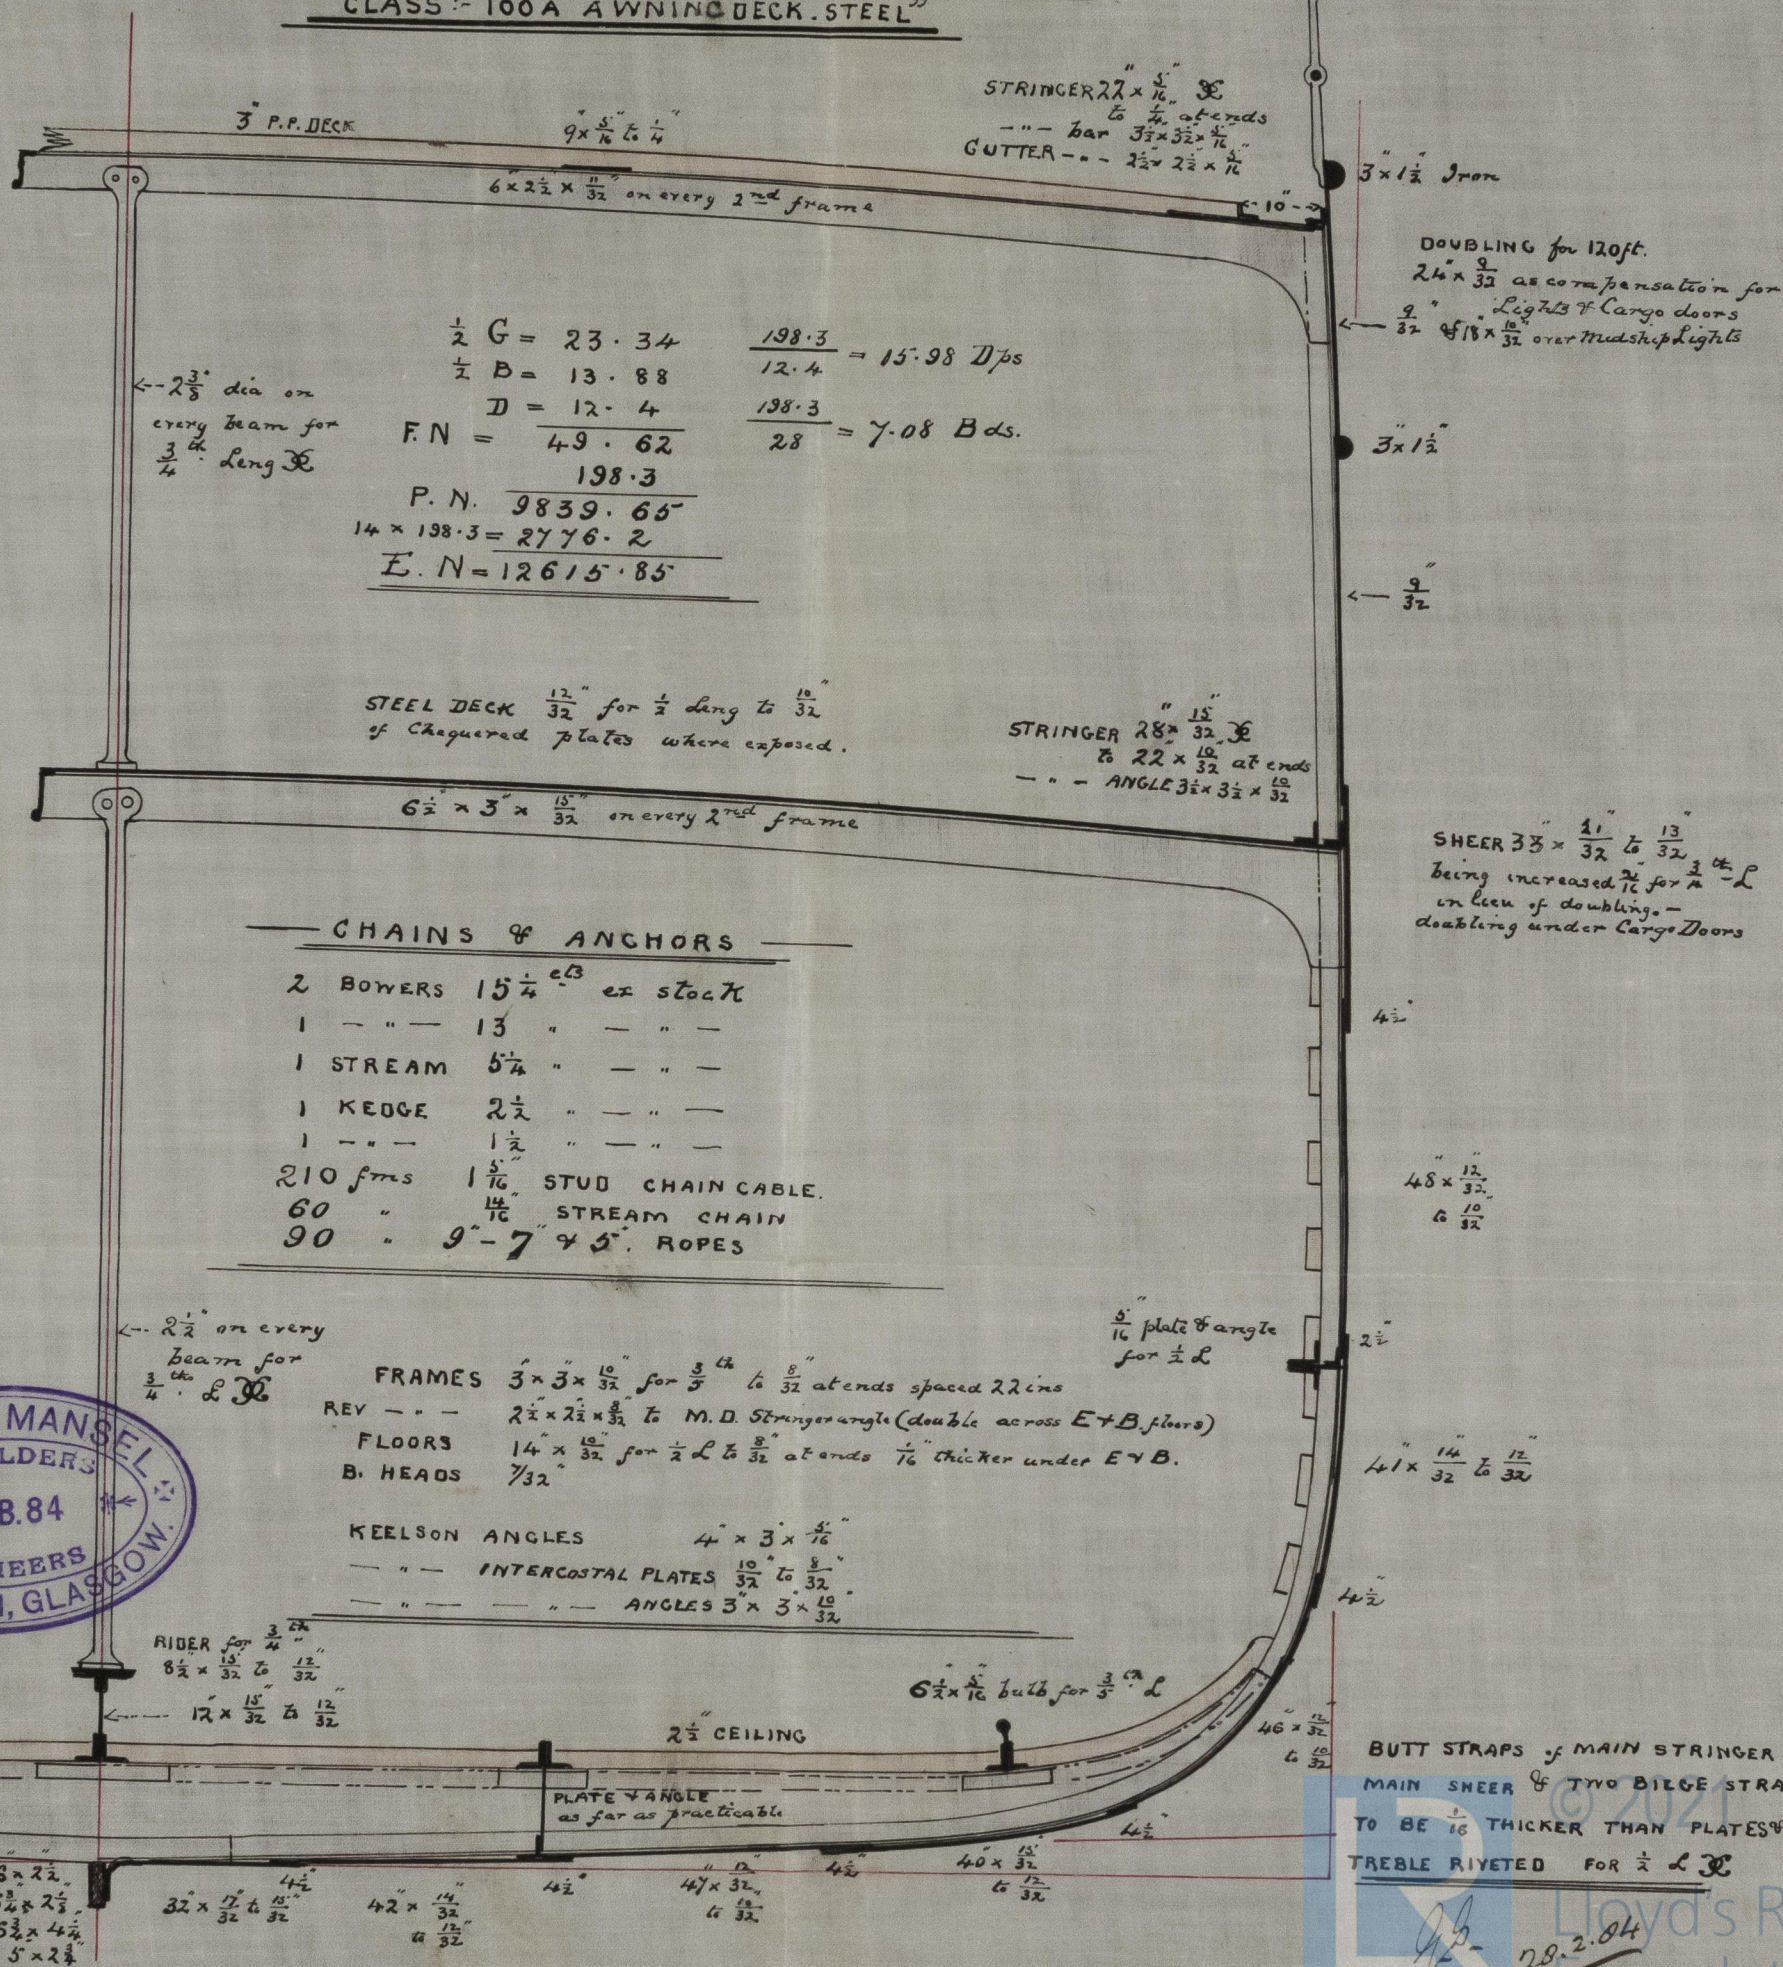

Lloyd's Register
Foundation