

Lloyd's Register of British and Foreign Shipping.

(Report on Vessel No. 6594 Port Glasgow)

No. 445

SHIP FORGINGS OR CASTINGS.

I have to report that the undermentioned Iron ~~or Steel~~ Forgings ~~or Castings~~, manufactured by The Lancefield Forge Co of Glasgow for the Vessel No. 129, being built by Messrs. Arthur & Mansel of Glasgow have been inspected by me as set forth below, and found to be, so far as can be seen, sound and efficient

Mark on Forgings.

Lloyd's
No. 445
G. N.


George Newcomb

Glasgow

15/4/84.

	STERN FRAME.	RUDDER FRAME.	STEM.
Material*	/	Scrap iron	/
How made	/	Forged	/
Dimensions	/	5" to 3"	/
Progress on Inspection	/	Forged and milled	/
Dates when Inspected	/	3.11.14.26.31/3/84. 7/4/84.	/

SKETCHES OF FRAMES SHEWING POSITION AND DESCRIPTION OF WELDS OF FORGINGS, OR PARTICULARS OF TESTS APPLIED TO CASTINGS.

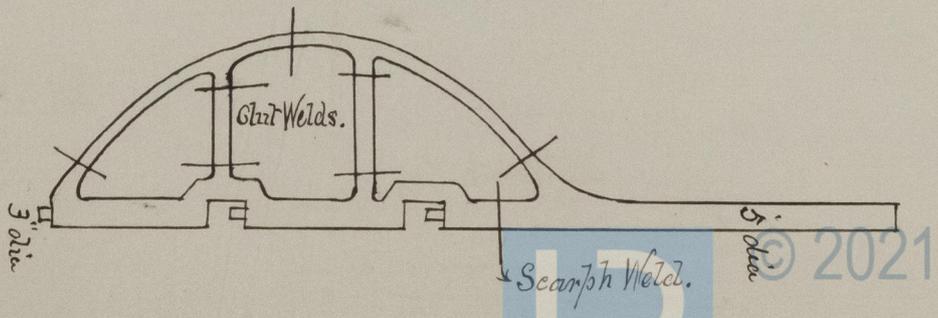

* If of Iron, state whether scrap or puddled iron.

The words FORGINGS or CASTINGS, IRON or STEEL, should be struck out as may be required.