

Dr. to Els.
 13/9/83
 5/11/83

S.S. "Atlantis" Glasgow Report No. 66314



Scale 1/2 inch = One Foot. Steel
 L_{ee} 9 x 9/16 Dimensions - 281 x 33 x 20.6 moulded

Numeral	Proportions
Half girth 33.25	Breadths 8.4
Breadth 16.5	Depth 13.2
Depth 21.16	
70.91	
279.6 Length	
19.826.4	

To be of Steel with the following
 Exceptions. Bulkheads, Tunnel, Tankers,
 Pillars, &c. and all sections above upper
 deck by Carings hatch crammings &c.

Main Deck plated whole length 10/32 (see plan)

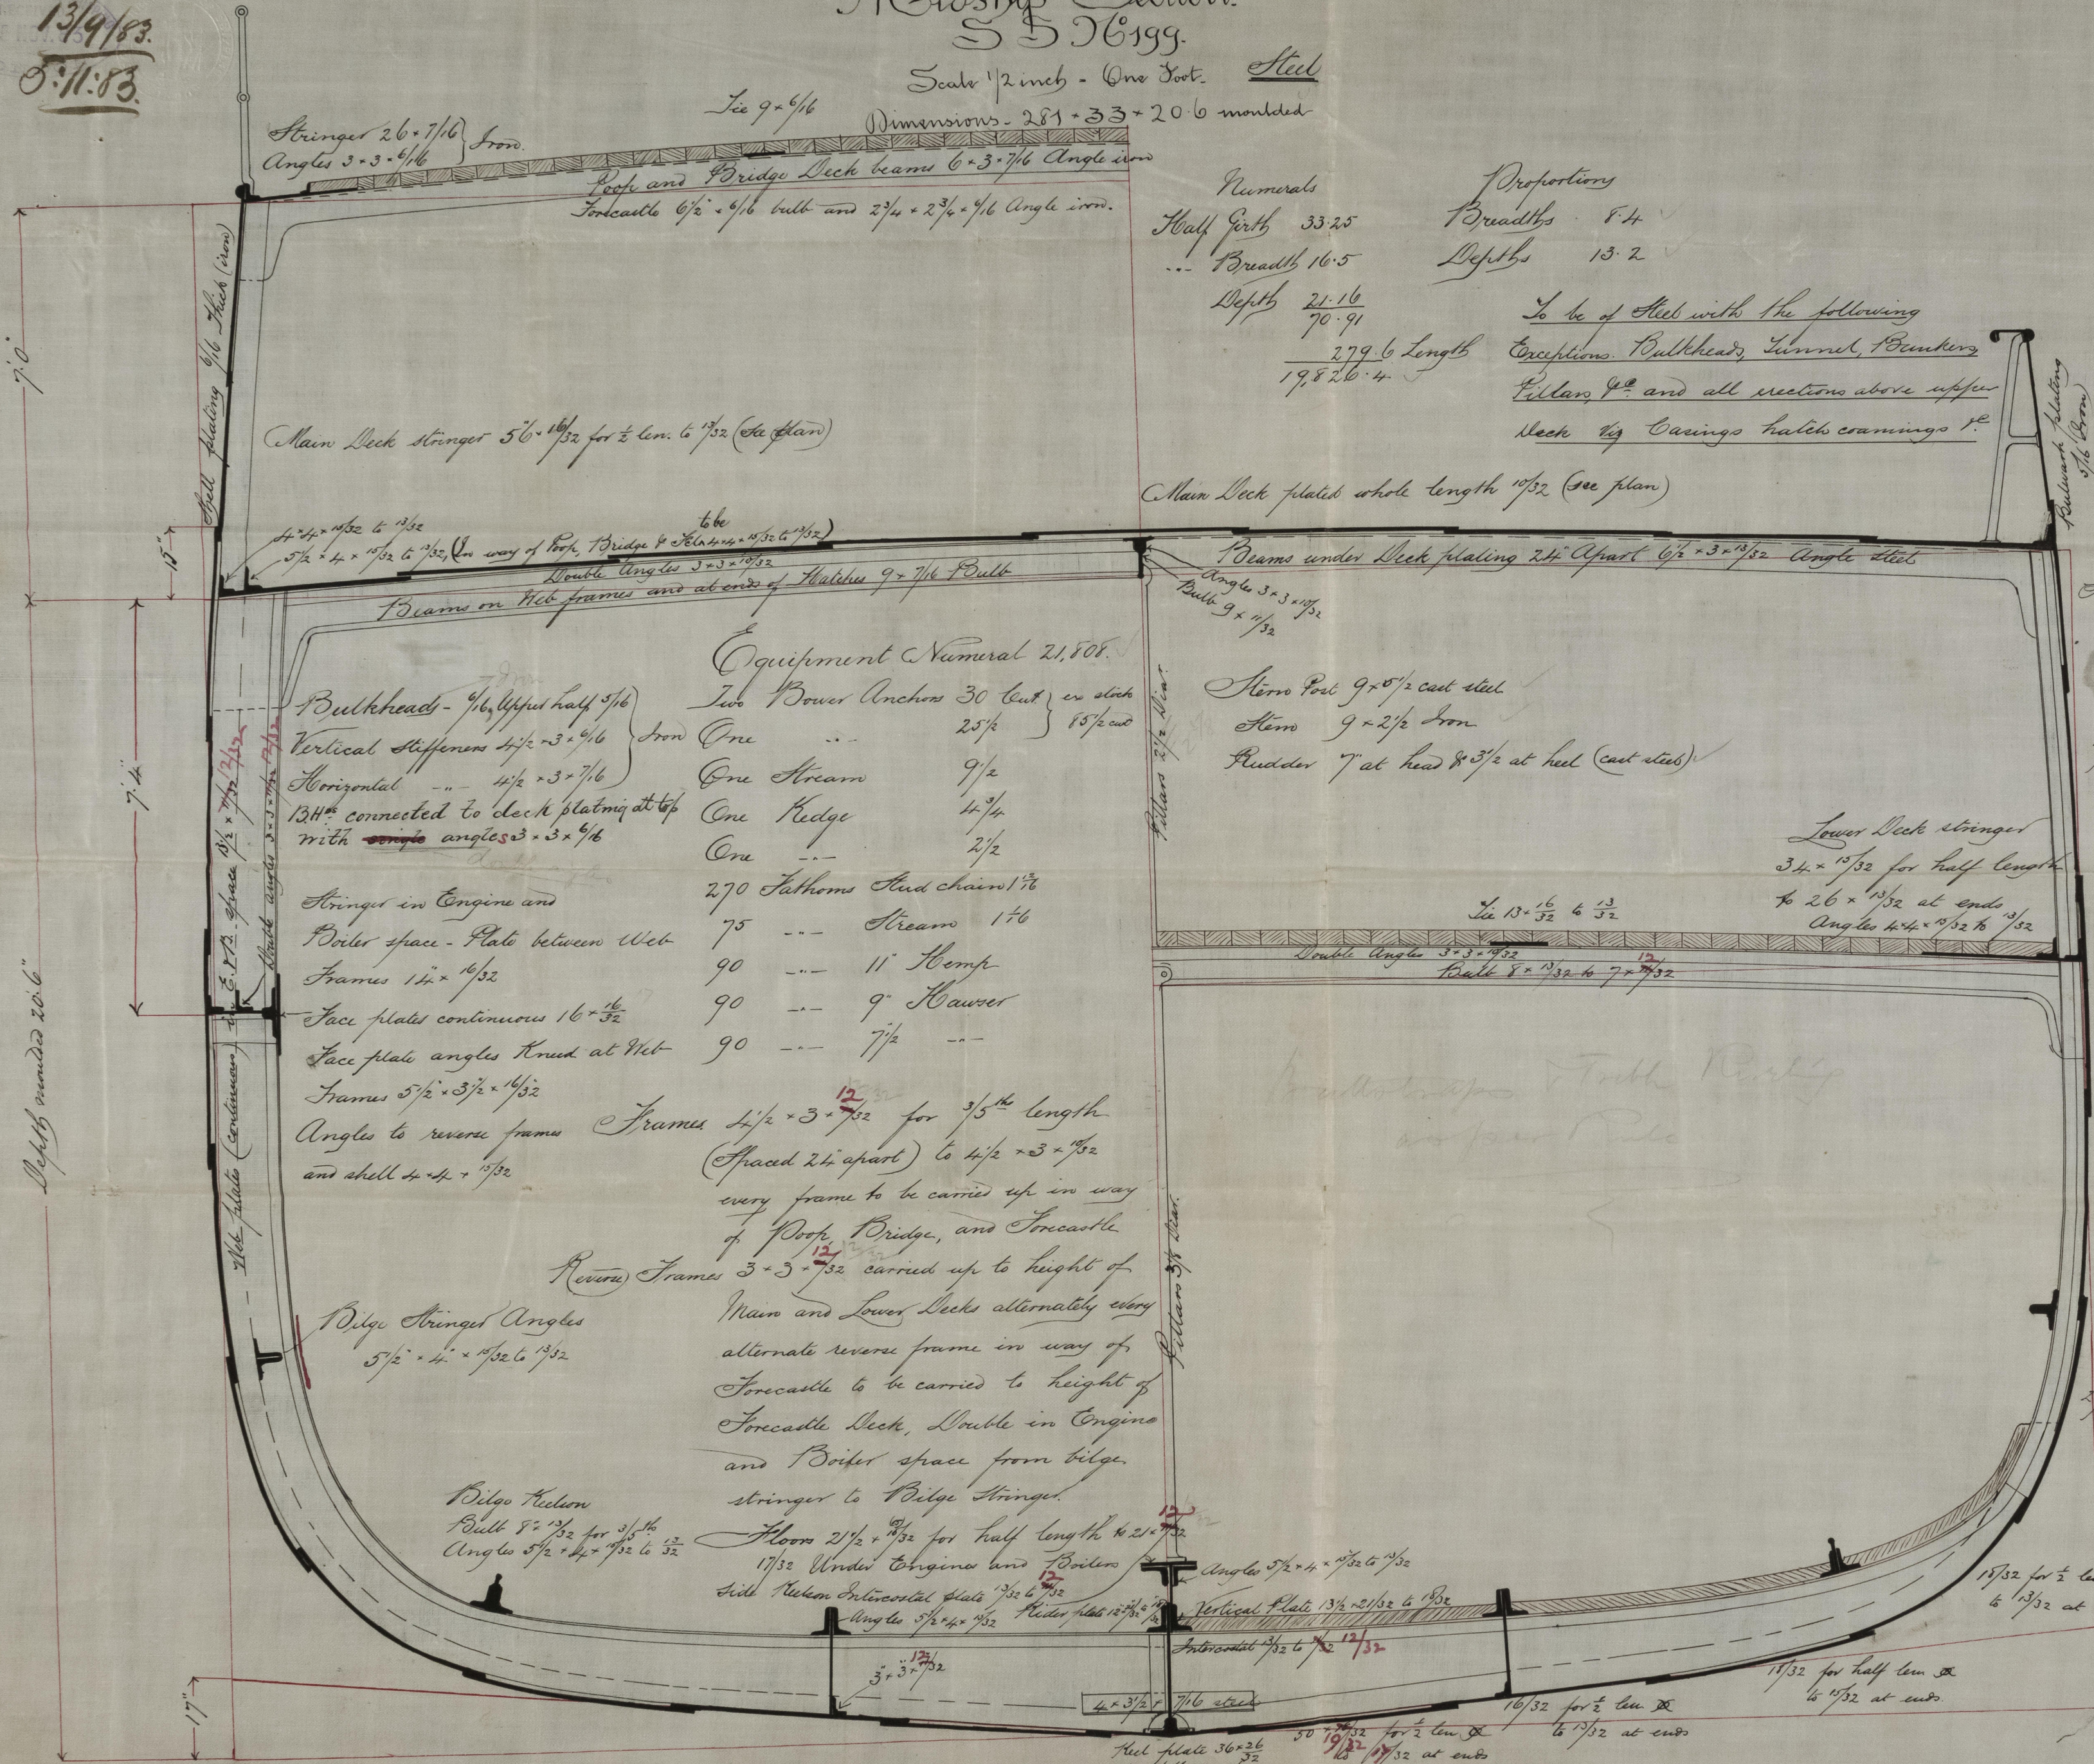

Shear strake 46 x 24/32 or 21 doubled 20 x 16/32 for 3/5 length
 for 1/2 len. & 6 10/32 at ends.

16/32 for 1/2 len. &
 6 10/32 at ends.

18/32 for 1/2 len. &
 6 10/32 at ends

15/32 for 1/2 len. &
 6 10/32 at ends

20/32 for 1/2 len. &
 6 10/32 at ends

15/32 for 1/2 len. &
 6 10/32 at ends

15/32 for half len. &
 6 10/32 at ends.

16/32 for 1/2 len. &
 6 10/32 at ends

50 10/32 for 1/2 len. &
 6 10/32 at ends

Bulb 36 x 26
 for 1/4\"/>

