

Lloyd's Register of British and Foreign Shipping.

(Report on Vessel No. 6639 Port Glasgow)

No. _____ SHIP FORGINGS OR CASTINGS.

I have to report that the undermentioned Iron ~~or Steel~~ Forgings ~~or Castings~~, manufactured by

The Govan Forge Co of Glasgow

for the Vessel No. _____, being built by J. S. "Queen"

of _____ have been inspected by me as set forth below, and found

to be, so far as can be seen, sound and efficient

This stern frame was repaired, by welding a new piece to the bottom of the part and part of the keel piece.

Mark on Forgings.

Lloyd's
No. _____


George Newcomb

Glasgow

5/7/84.

	STERN FRAME.	RUDDER FRAME.	STEM.
Material* - - - -	<u>Scrap iron</u>	/	/
How made - - - -	<u>Forged</u>	/	/
Dimensions - - - -	<u>10 1/2 x 4 & 7 x 3</u>	/	/
Progress on Inspection -	<u>Smoothed & completed</u>	/	/
Dates when Inspected	<u>29.28/6/84. 1.2/7/84.</u>	/	/

SKETCHES OF FRAMES SHEWING POSITION AND DESCRIPTION OF WELDS OF FORGINGS, OR PARTICULARS OF TESTS APPLIED TO CASTINGS.

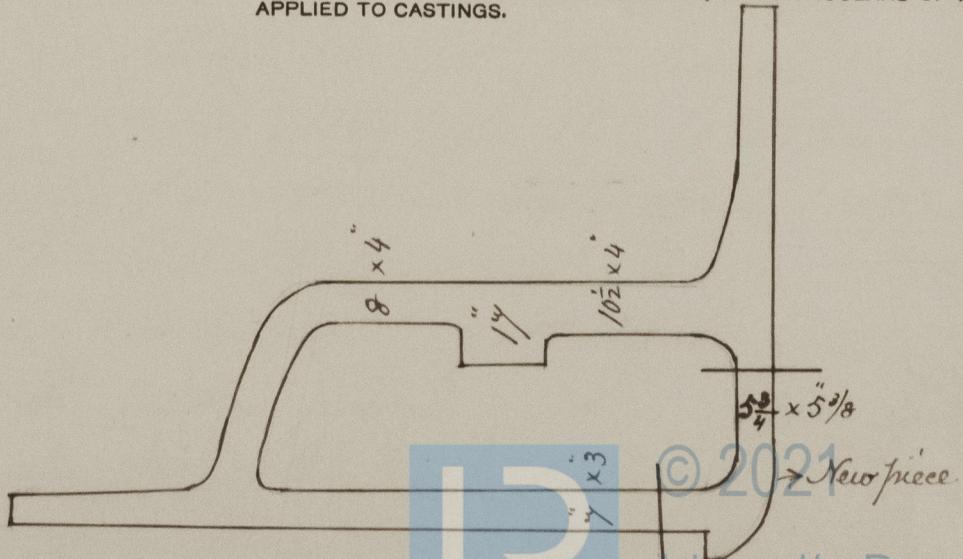

* If of Iron, state whether scrap or puddled iron.