


Ltr. D. G. S.
 16/10/83.

— S. S. N^o 242

SCALE $\frac{1}{4}$ INCH

ELEVATION, BALLAST TANK TOPS, AND SECTIONS.

SCANTLING ALL AS PER MIDSHIP SECTION
APPROVED 13.9.83.

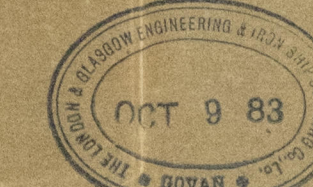

Register No 610

S. S. "Kii Maru"	Glasgow Report. N ^o 6595
S. S. "Higo Maru"	— do — 6666

16/10/83