


V. 6 lbs  
25/2/84

N<sup>os</sup> 242 & 243 S.S.

PUMP, BALLAST TANK and DRAINING ARRANGEMENTS

Scale 1/4 in. = 1 ft.

S.S. "Kii Maru" Glasgow Report No 6595.  
S.S. "Higo Maru" do do 6660

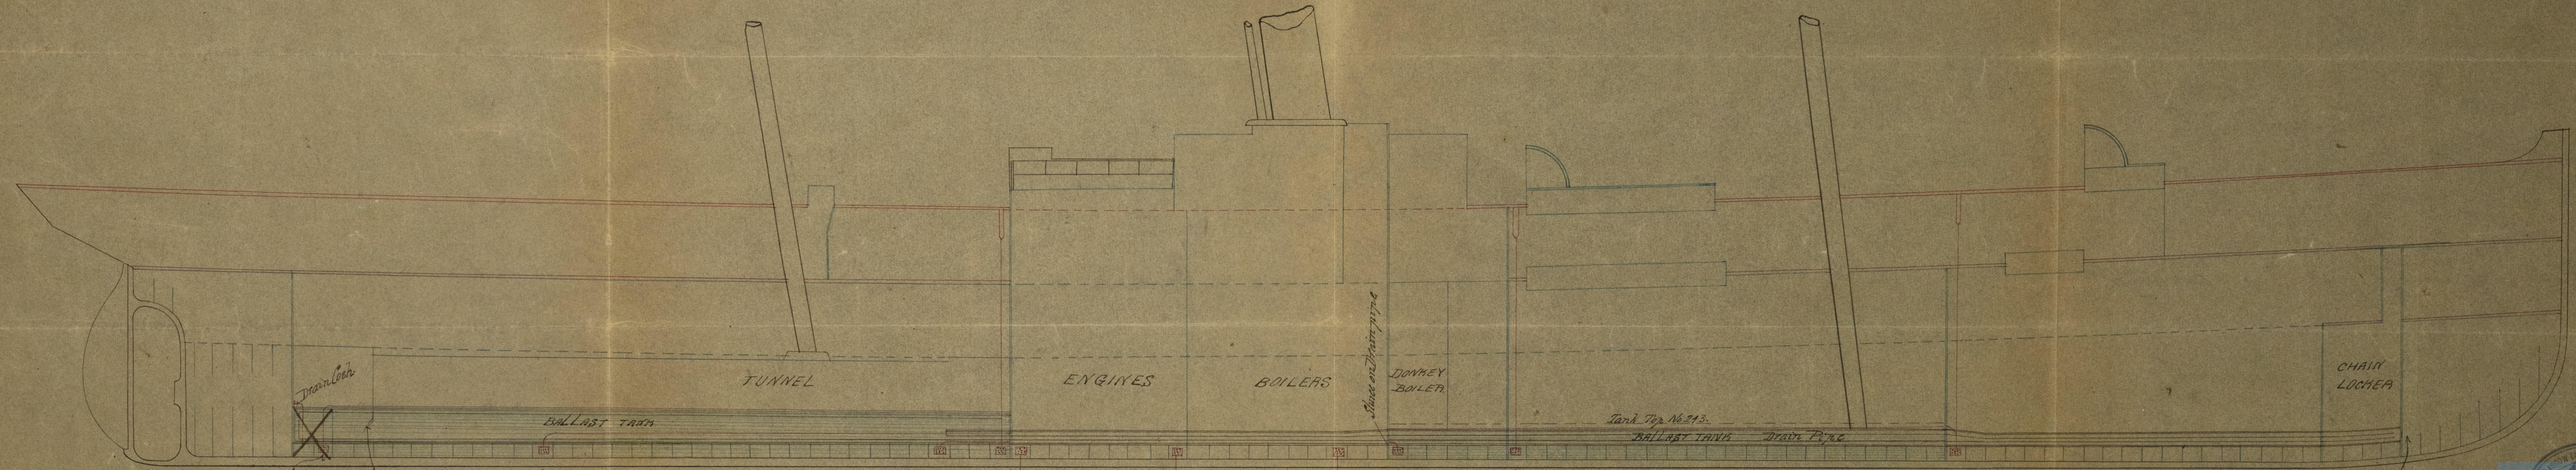

2 1/2" Engine Section Non return Valve to each Cutter  
4" Engine filling and emptying


2 1/2" Engine Section Slice in each wing to each Gudge  
3/4" Deck pump in one wing and 1/2" Engine Section in other wing  
2 1/2" Engine Section Port wing  
2 1/2" Engine Section can't Port Starboard wing

Drain Hole in each Gutter Sluice Valve in each wing  
4" Engine filling & emptying in Centre and one 1/2" and 2 1/2" Engine Section in other wing  
each Gudge  
2 1/2" Engine Section Port  
2 1/2" Starboard wings

3/4" Deck Pump  
2 1/2" Engine Section in centre

Sluice

DJ.  
23/2/84

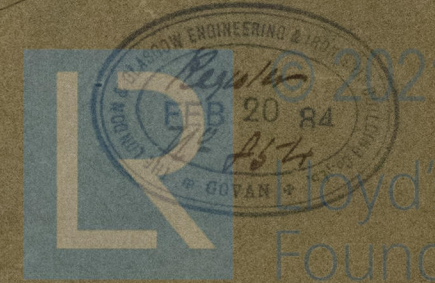

Lloyd's Register Foundation