Lts: Dgs.
27/9/83.

Steel

S.S. "Higo Maru"

Glasgow Report
No. 6660.

S.S. No 243.

SCALE ½ INCH.

TO CLASS 100A AT LLOYDS "AWNING DECKED CLASS".

DIMENSIONS 235'-0" × 33-0 × 15-6 MAIN DECK TO FLOORS.

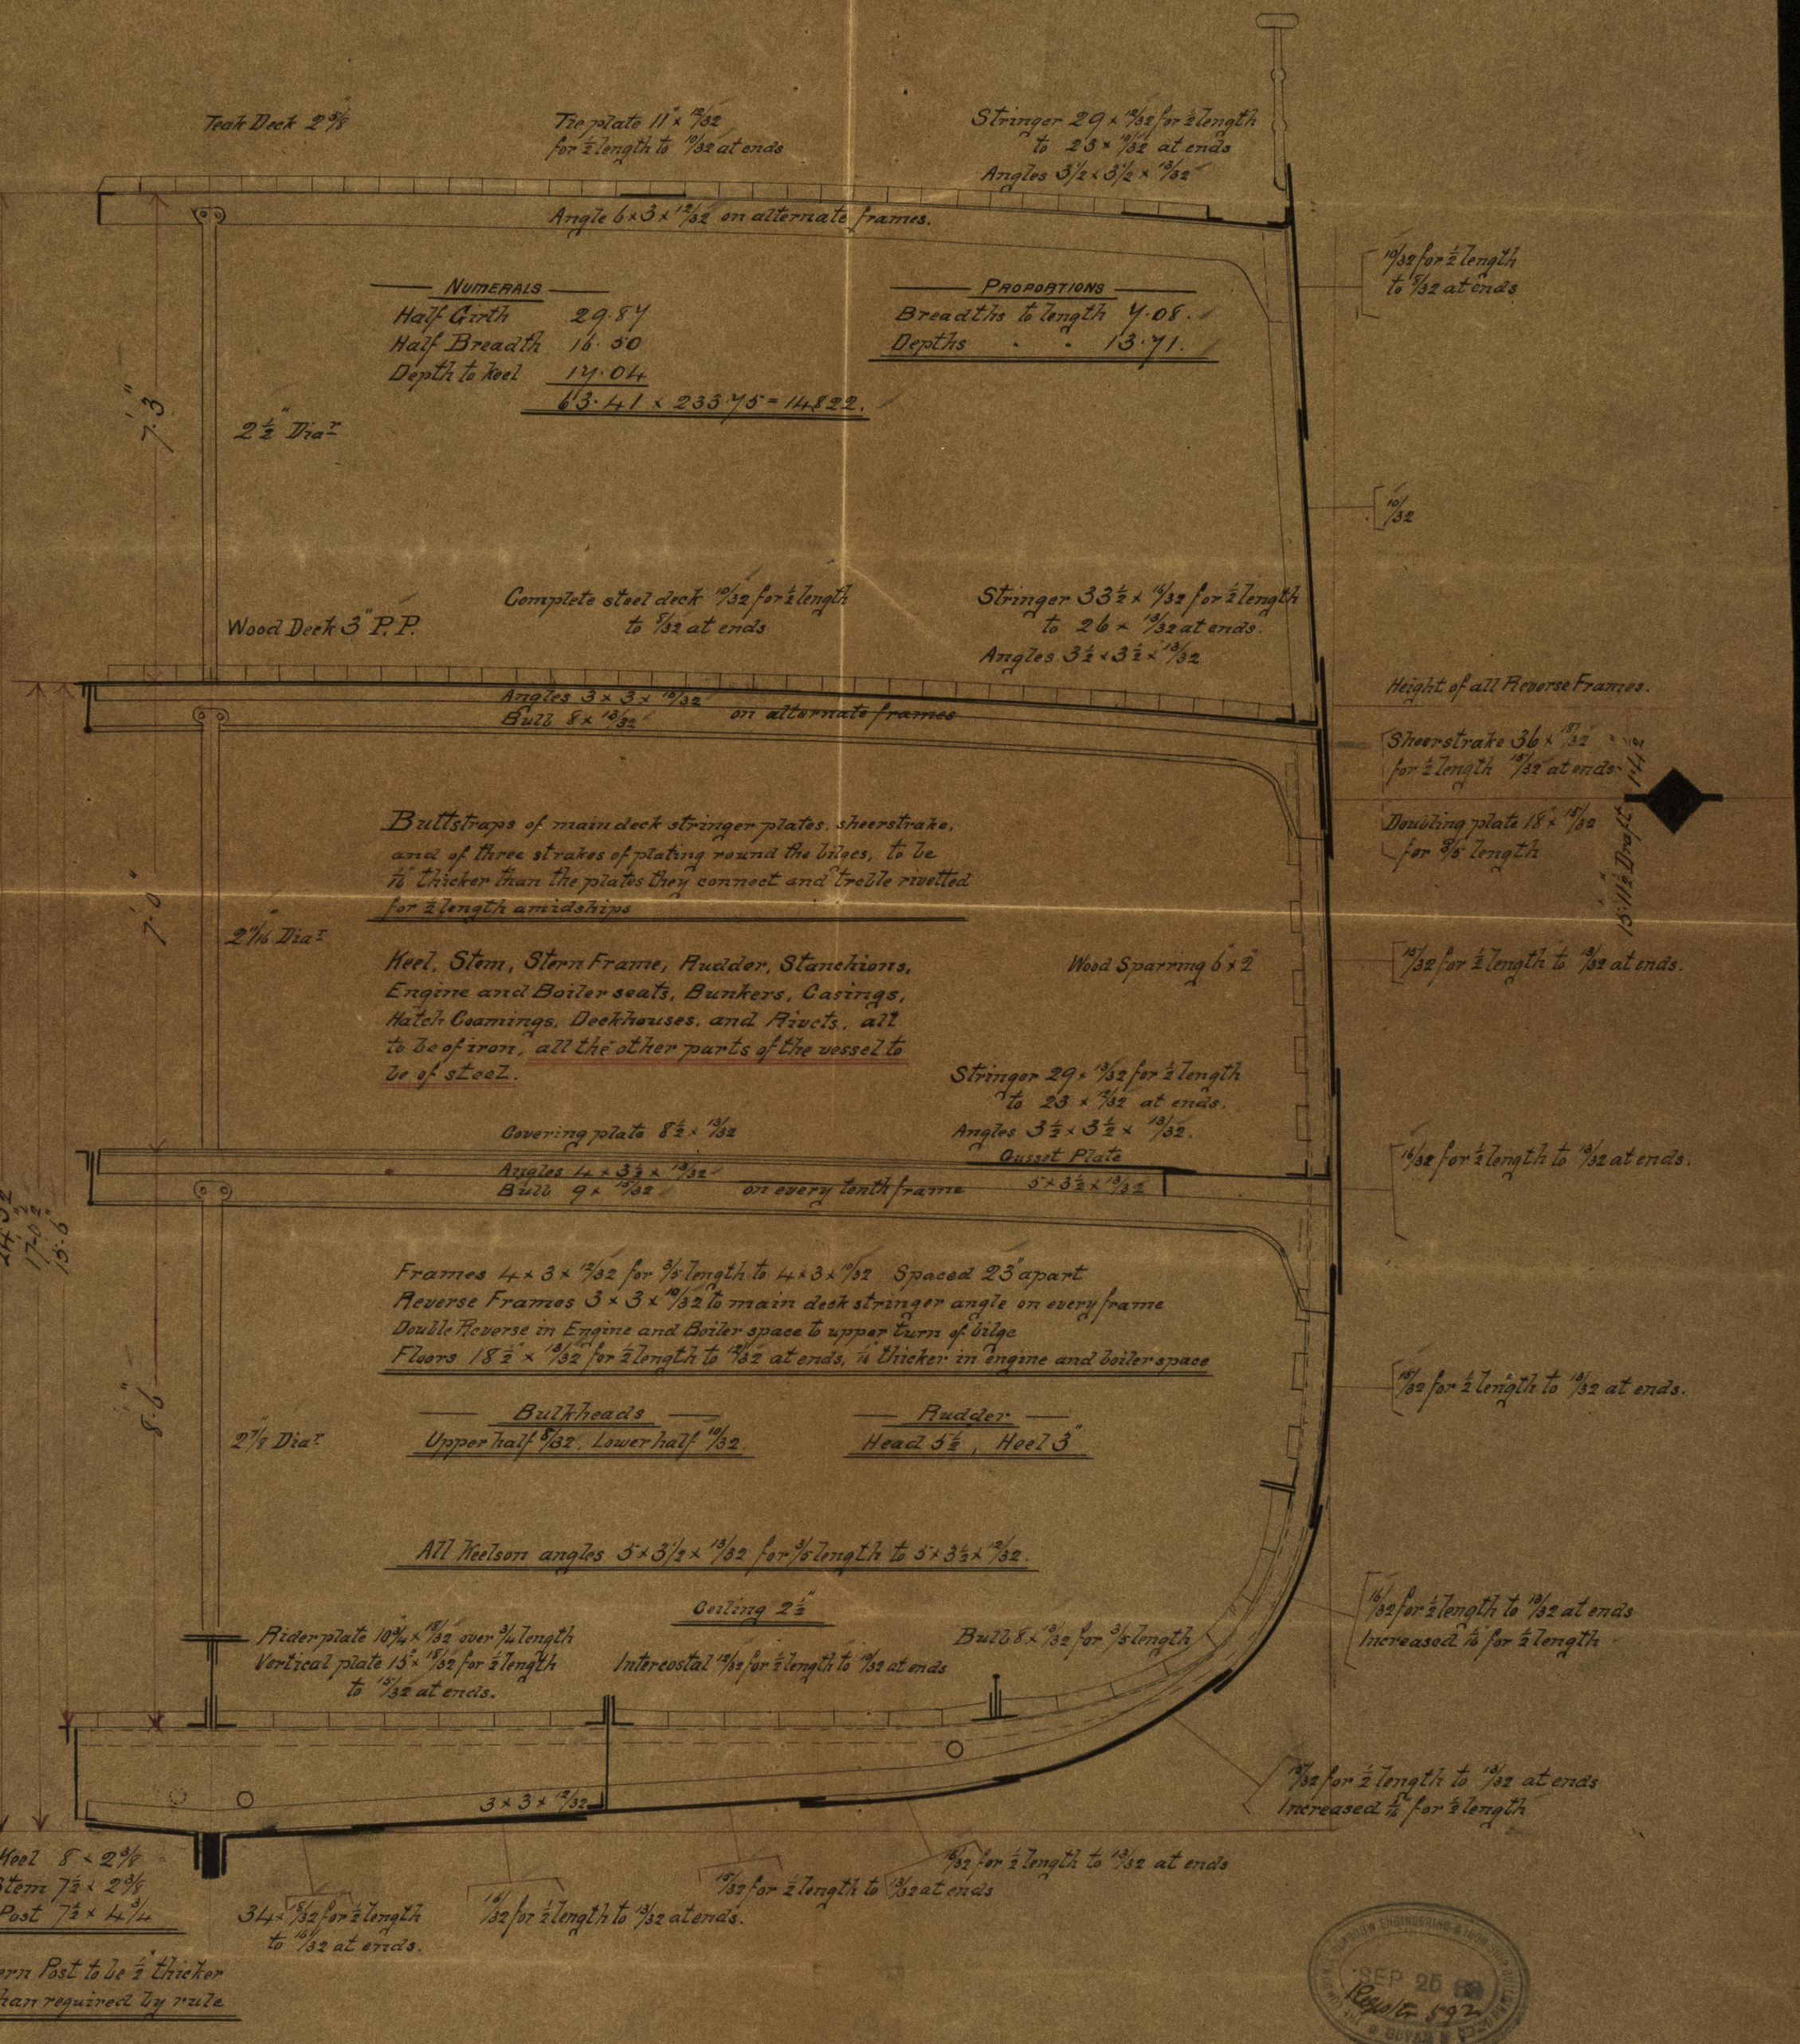

SEP 25 1883
Register

© 2021 Lloyd's Register Foundation

GLS199-0229