
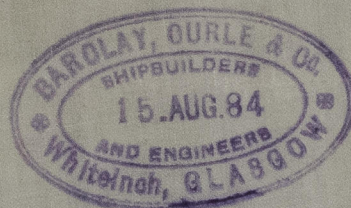


Mr. St. Ruthbert
Glasgow Report No. 6681.

OK'd
27/8/84

Rigging Screws No 330

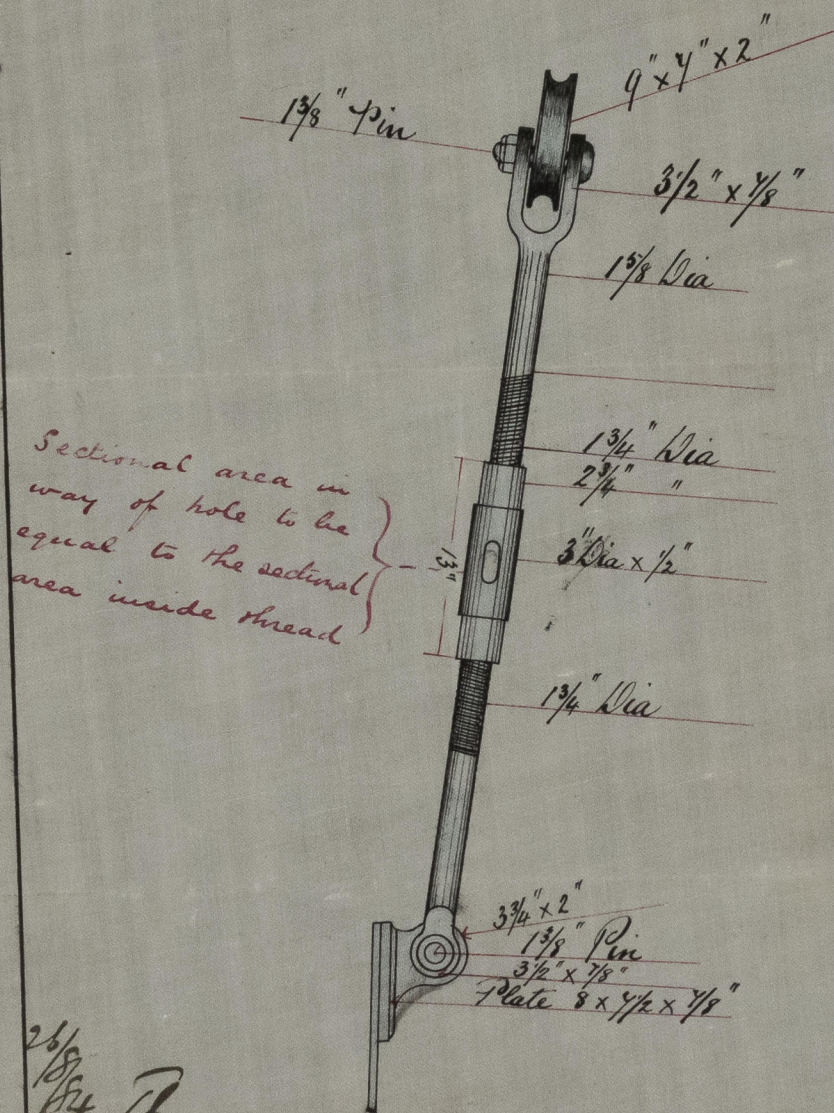

26/8/84 B.



© 2021

Lloyd's Register
Foundation

GLS199-0259