

The words FORGINGS or CASTINGS, IRON or STEEL, should be struck out as may be required.

Received at

Office,

18

# Lloyd's Register of British and Foreign Shipping.

(Report on Vessel No. 6442 Port Glasgow)

No. 545

## SHIP FORGINGS OR CASTINGS.

I have to report that the undermentioned Iron or ~~Steel~~ Forgings or Castings, manufactured by Messrs Rockfort & Co. of Warrington for the Vessel No. 28, being built by Messrs Burnell & Son of Dumbarton have been inspected by me as set forth below, and found to be, so far as can be seen, sound.

Mark on Forgings.

Lloyd's


No. 545  
R.C.

H. Cameron,

Sunderland.

	STERN FRAME.	RUDDER FRAME.	STEM.
Material* - - - -		<u>Scrap iron</u>	<u>Scrap iron</u>
How made - - - -		<u>Forged</u>	<u>Forged</u>
Dimensions - - - -		<u>4 3/4"</u>	<u>10' x 2 3/4"</u>
Progress on Inspection -		<u>Forged &amp; Smithed</u>	<u>Forged</u>
Dates when Inspected		<u>March 5-12-31 April 2-16</u> <u>May 19-31 June 18-21-26 July 4-15-18/84</u>	<u>Oct 4-12/83</u>

SKETCHES OF FRAMES SHEWING POSITION AND DESCRIPTION OF WELDS OF FORGINGS, OR PARTICULARS OF TESTS APPLIED TO CASTINGS.

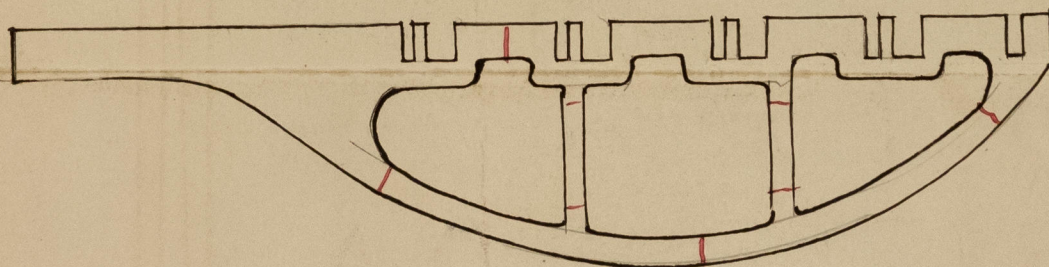

© 2021

Lloyd's Register  
Foundation