


Forecastle Beams. $6\frac{1}{2} \times \frac{5}{8}$. Angles. $3 \times 2\frac{1}{2} \times \frac{1}{4}$.
 " Stringer. $4\frac{1}{2} \times \frac{1}{4}$. Ends. $30 \times \frac{1}{4}$.

S. S. "Bormida" Glasgow Report No. 6650.
S. S. "Bisagno" — do — " 6742.

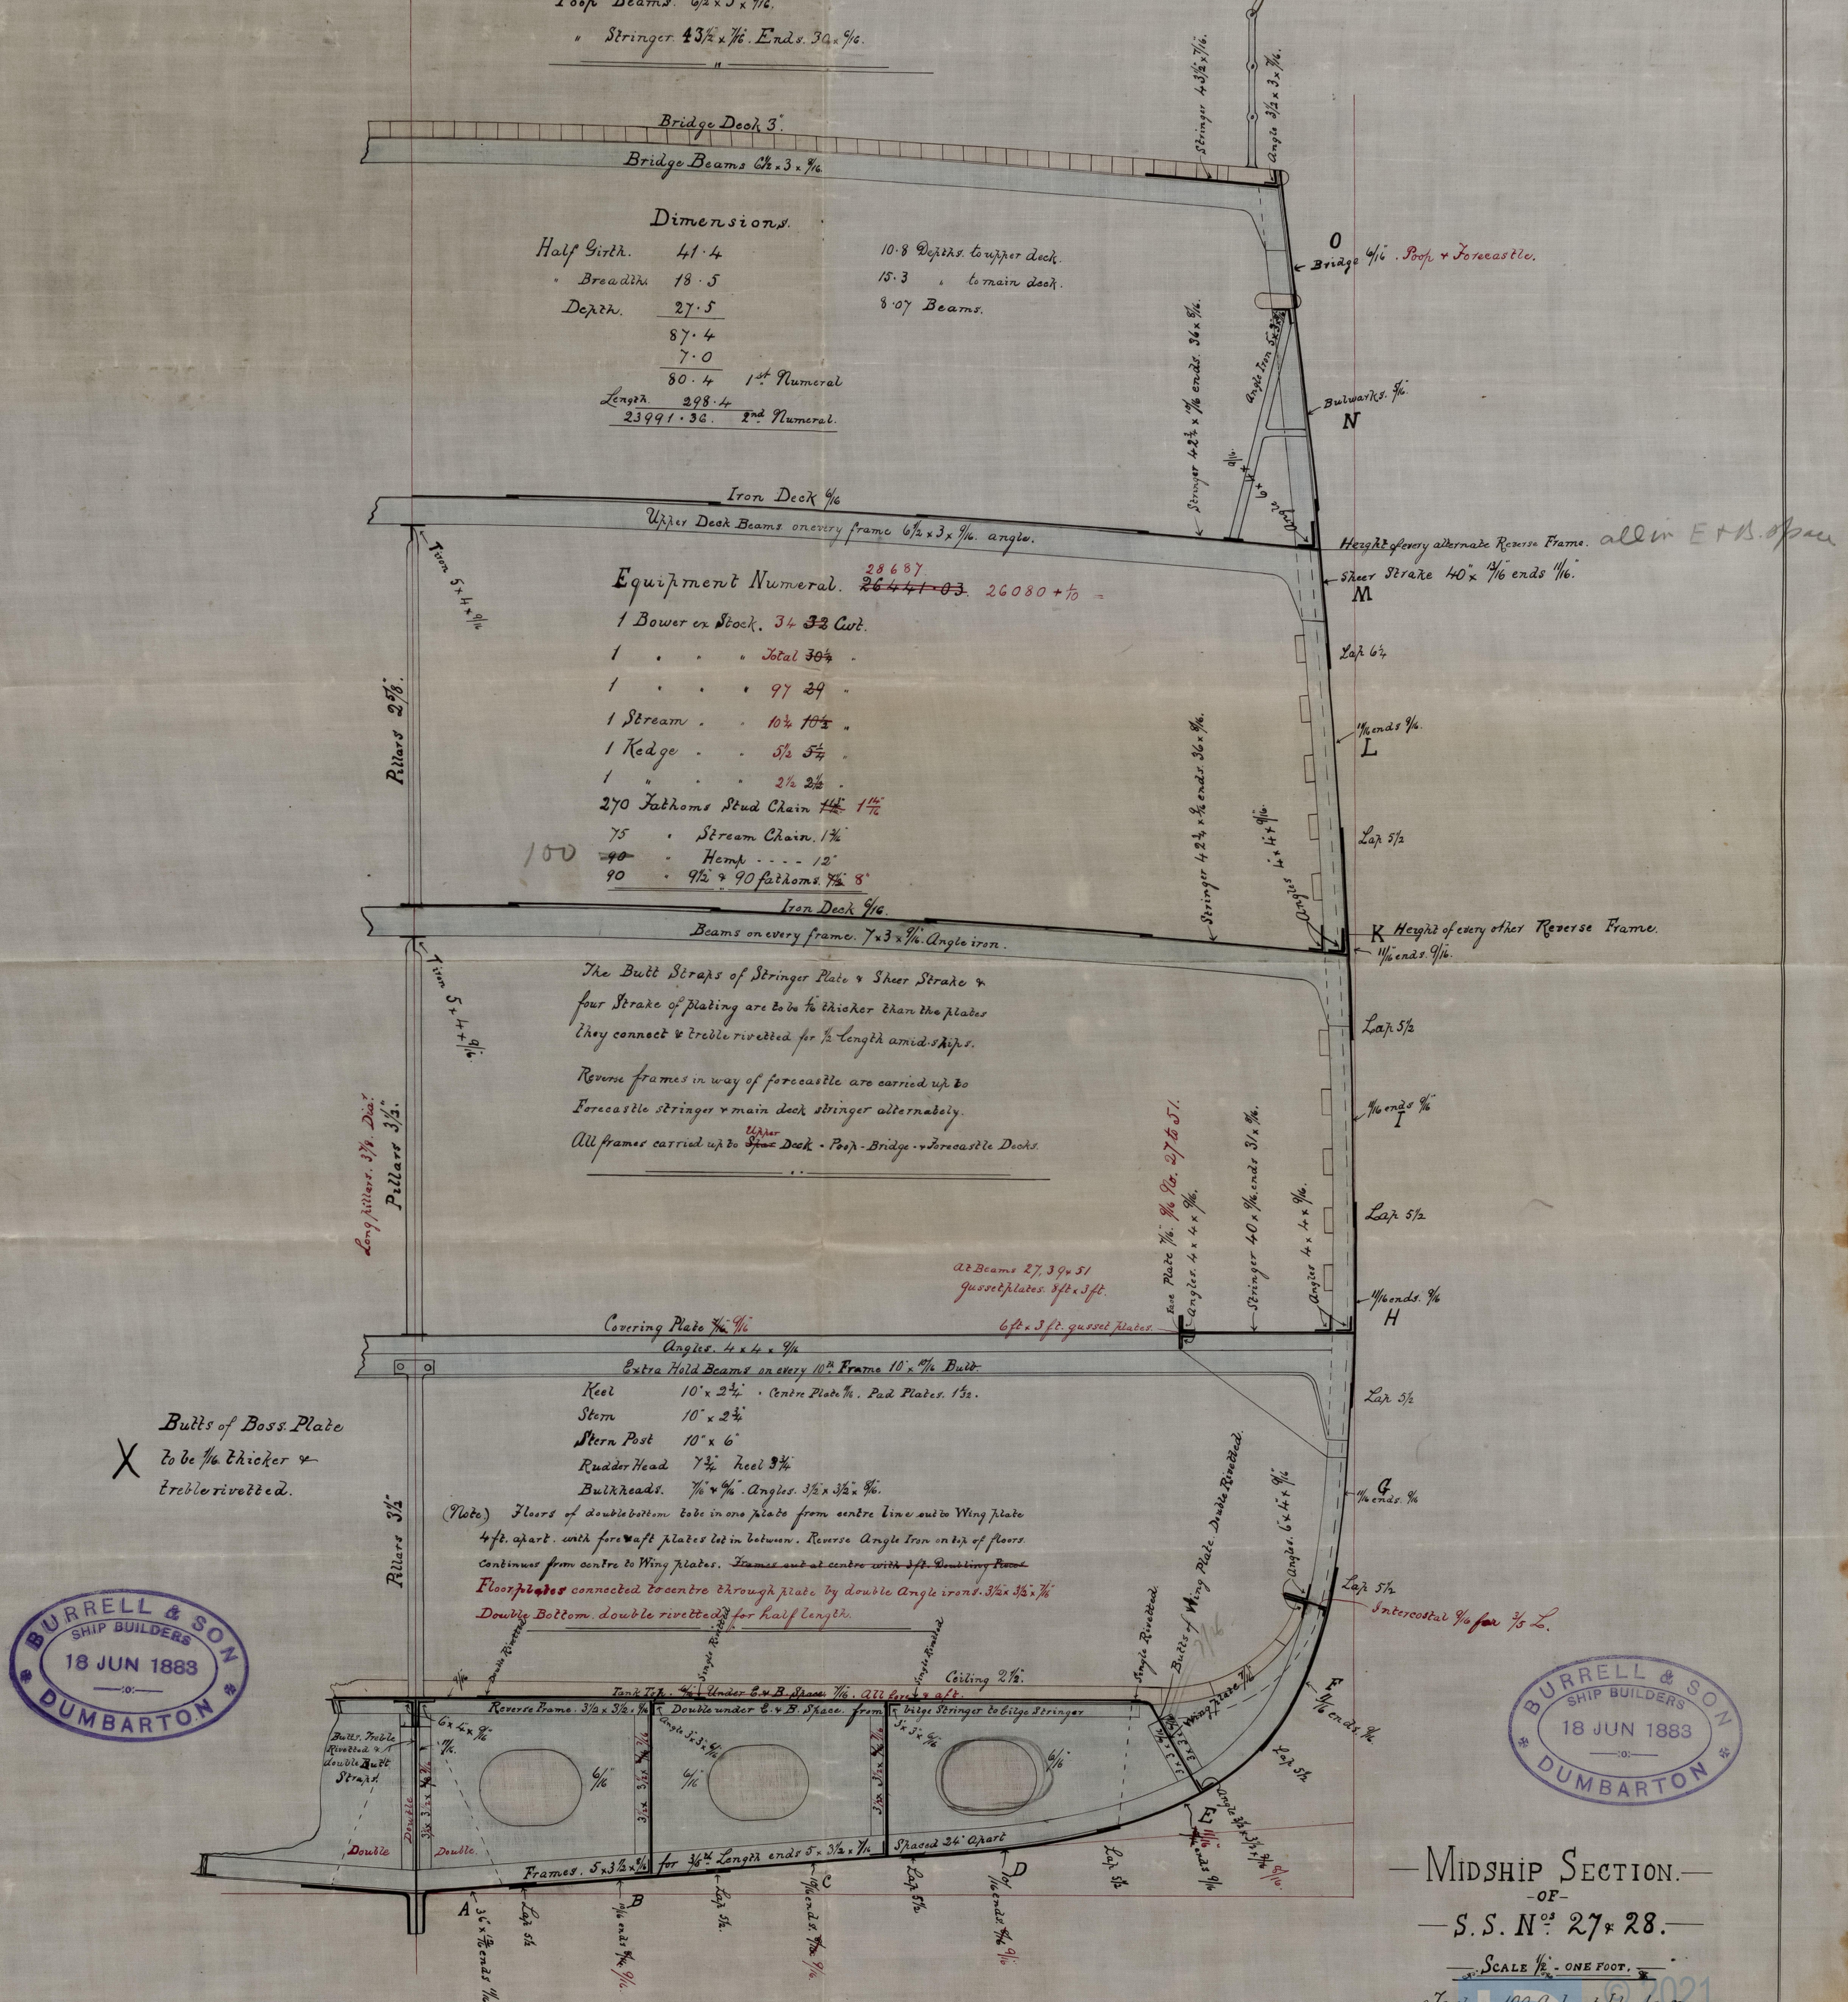

— MIDSHIP SECTION. —
— OF —
— S. S. N^{os} 27 & 28. —

SCALE $\frac{1}{2}$ " - ONE FOOT.

To class 100 A. I. at Lloyds on
— 3 Dk. Rules —

Lloyd's Register
Foundation

GLS200-0132