

OCT. 83
LONDON


Dr. S. G. R.

22.10.83.

S.S. "Bormida" Glasgow Report No. 6650.

S.S. "Bisagno" — do — " 6442.

Section through E. and B. Space No. 24-8.
Scale $\frac{1}{4}$ = one foot.

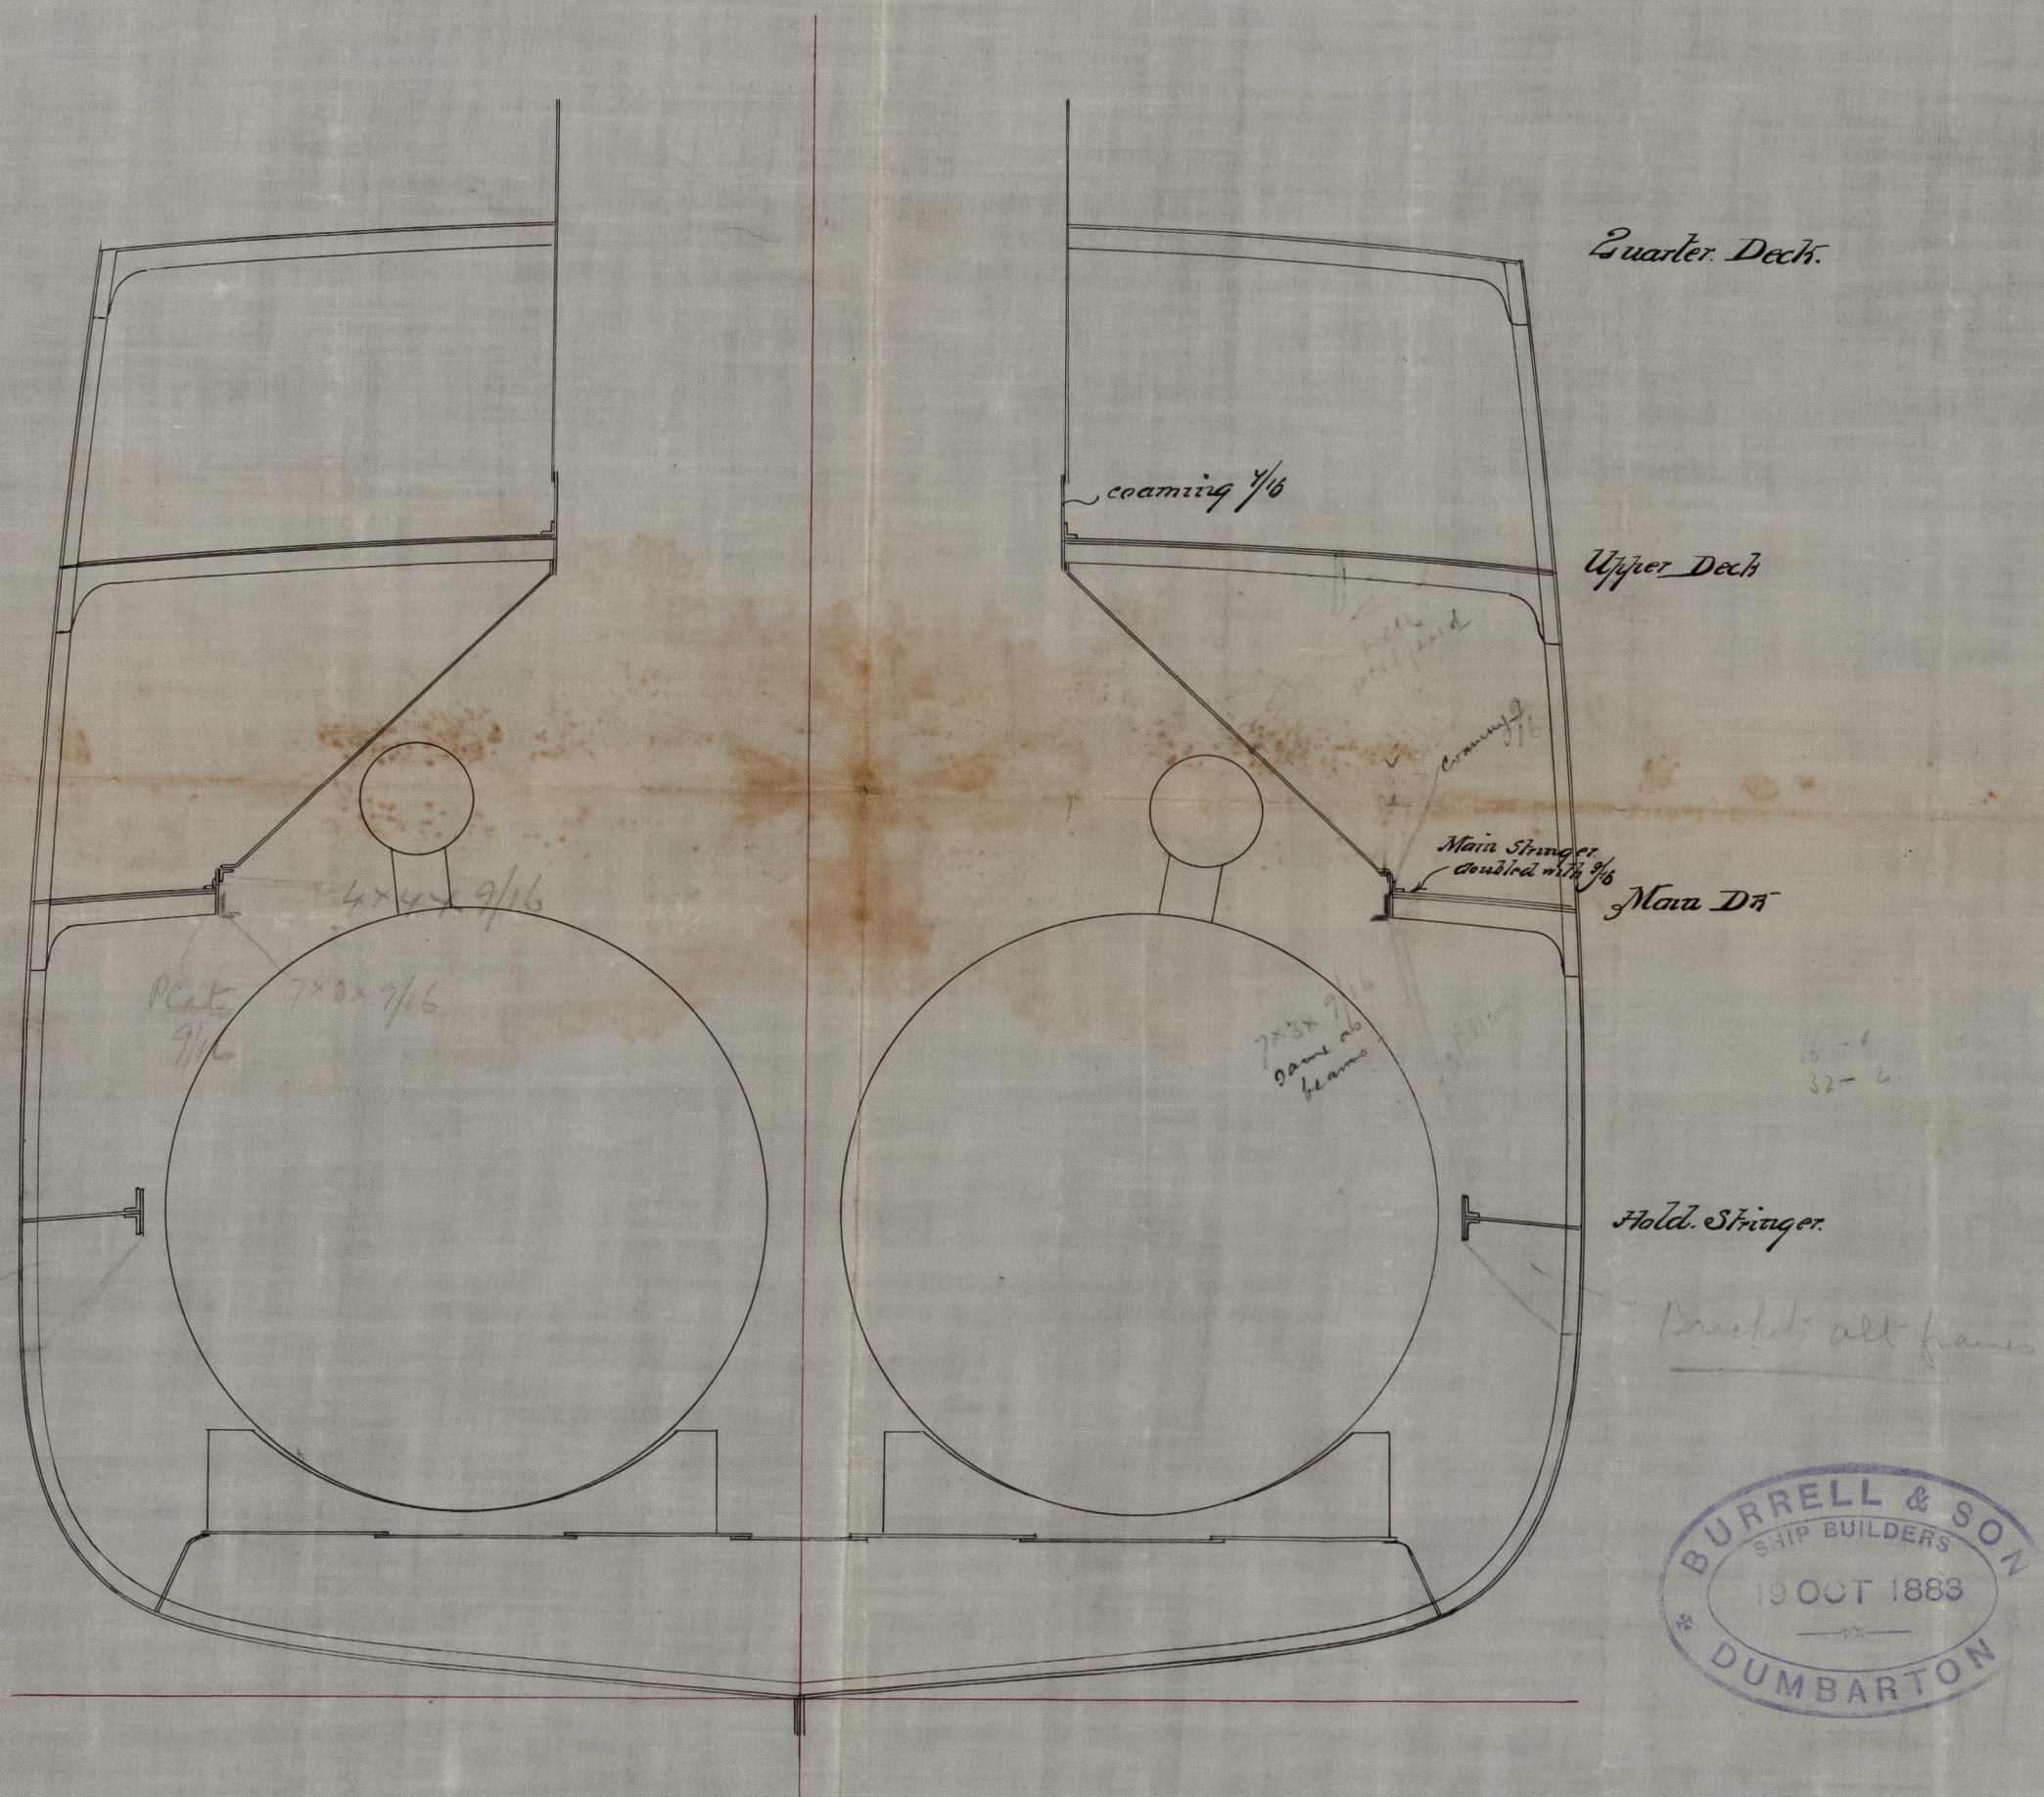

Wm
22/10/83



© 2021

Lloyd's Register
Foundation

GLS200-0135