


OCT. 83  
LONDON

BURRELL & SON  
SHIP BUILDERS  
9 OCT 1883  
DUMBARTON

S.S. "Bormida" Glasgow Report No 6650.  
S.S. "Bisagno" — do — " 6742.



Dr. D. G.  
22.10.83.

Engine and Boiler casing No 278  
Scale 1/4" = one foot

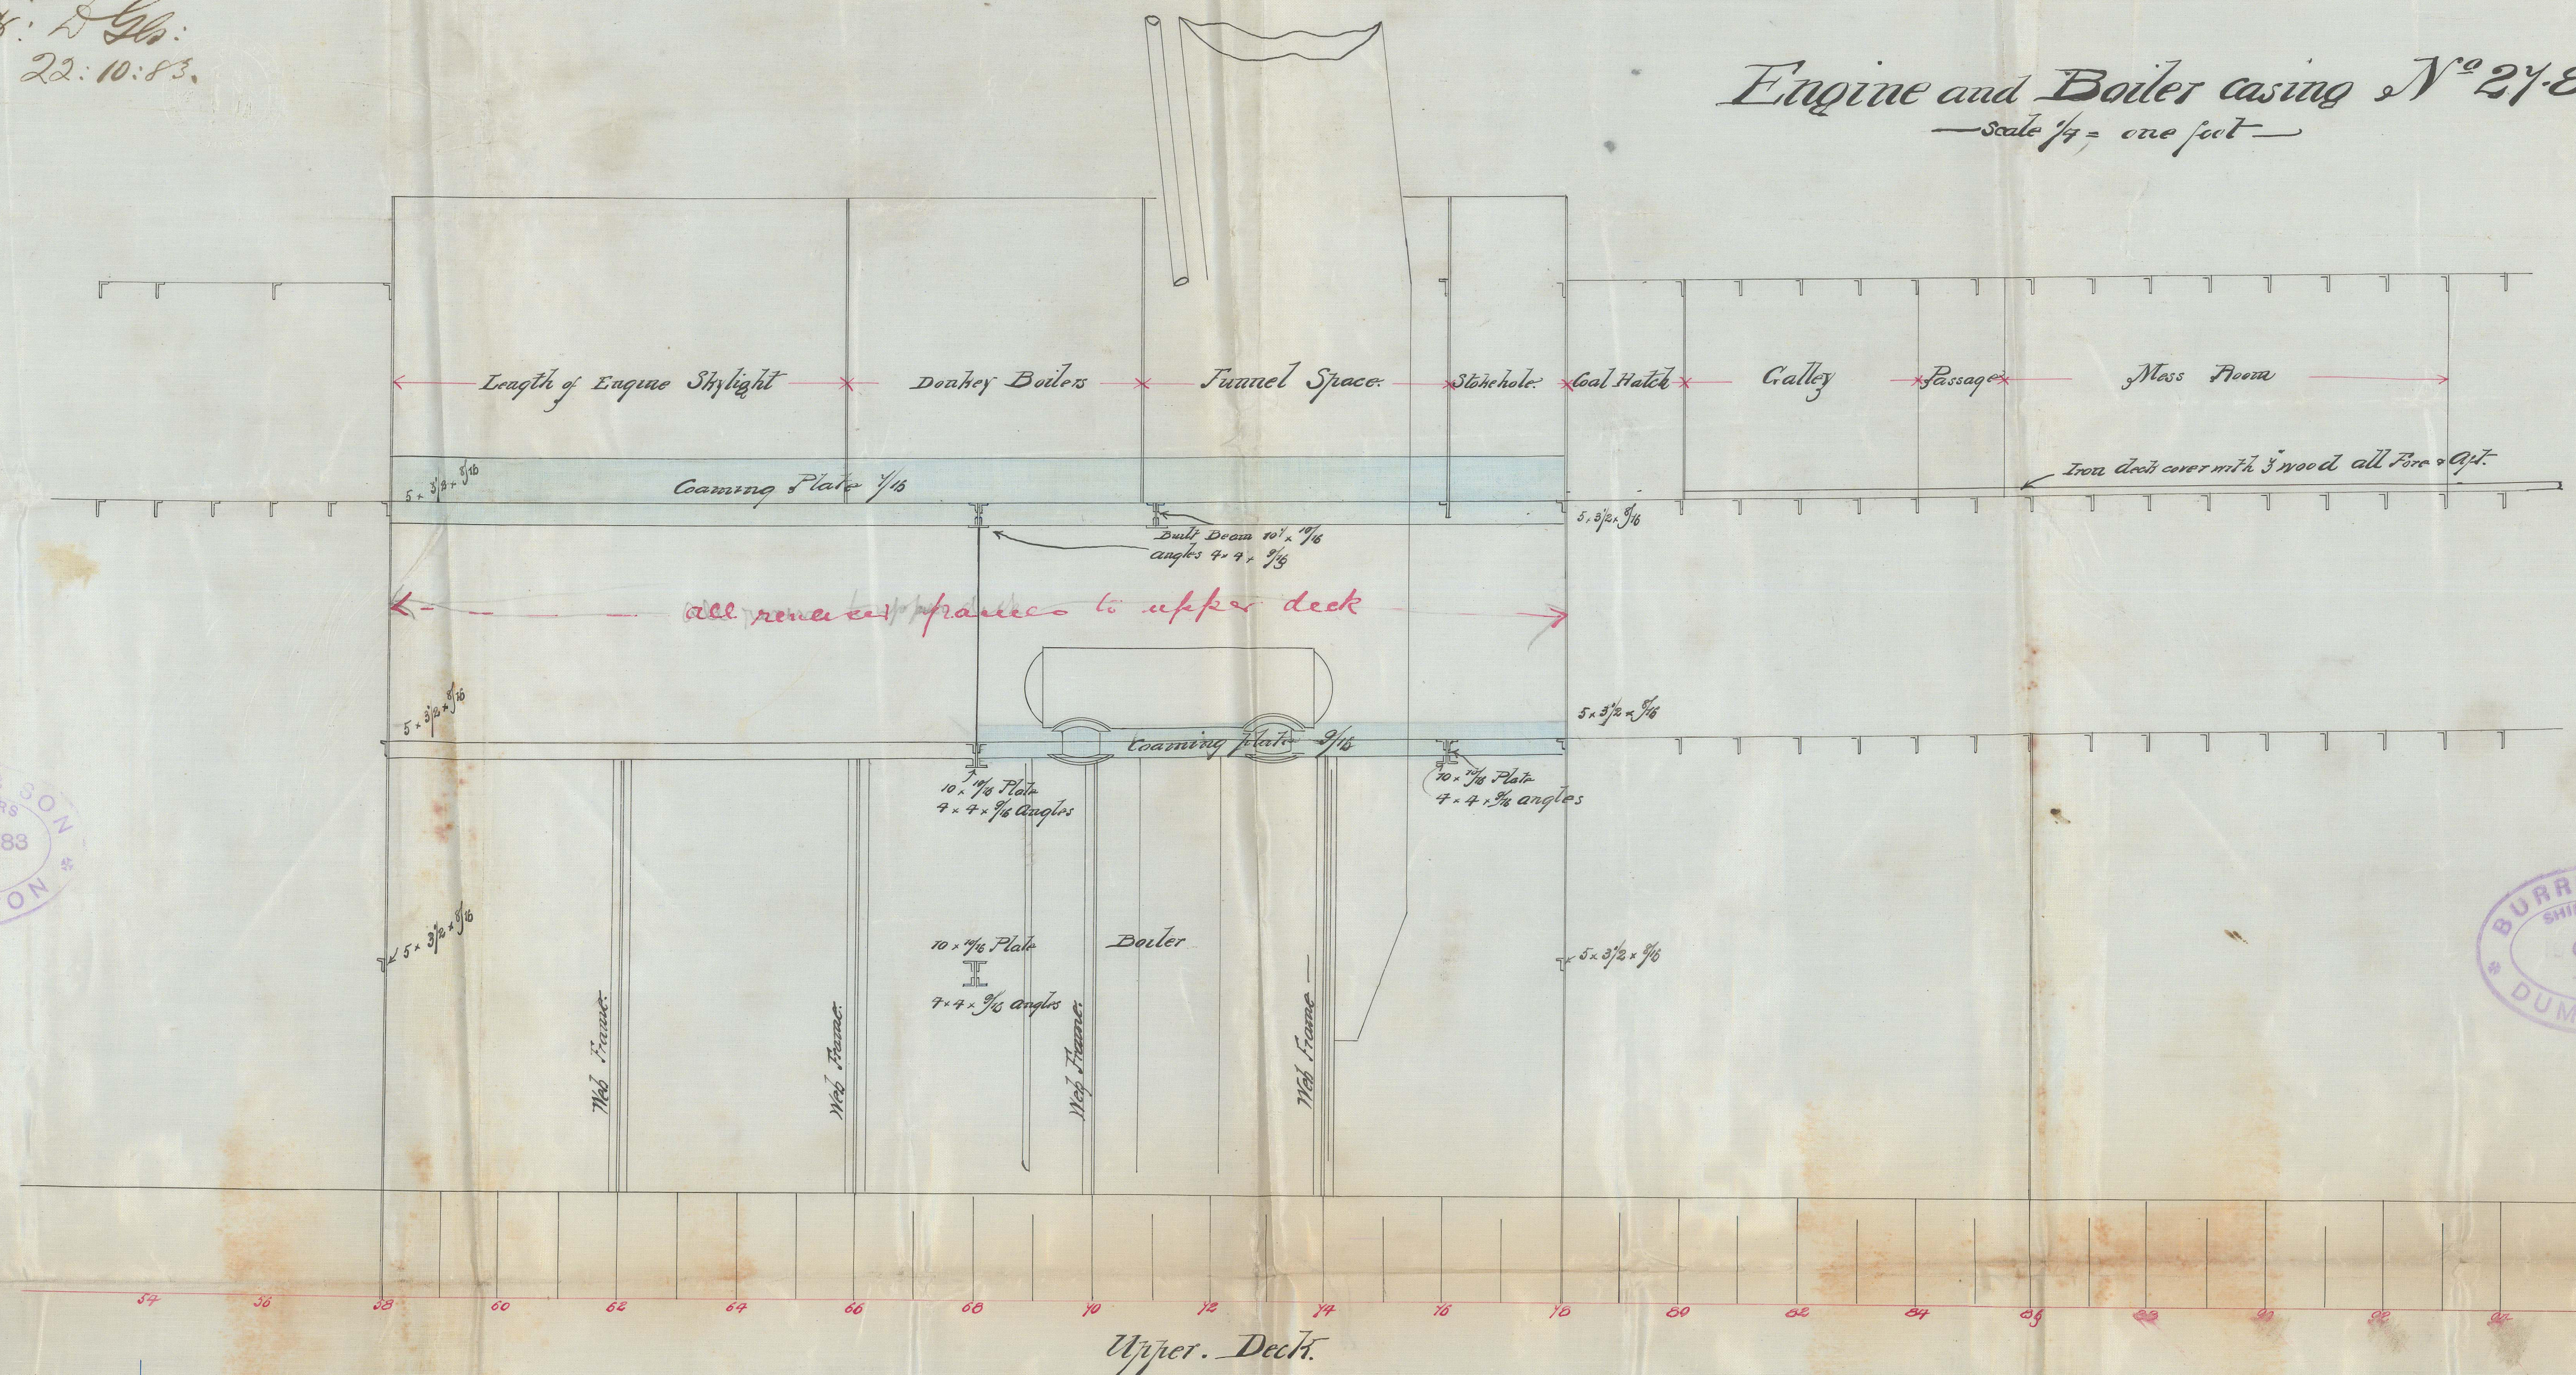

BURRELL & SON  
SHIP BUILDERS  
9 OCT 1883  
DUMBARTON

BURRELL & SON  
SHIP BUILDERS  
OCT 1883  
DUMBARTON

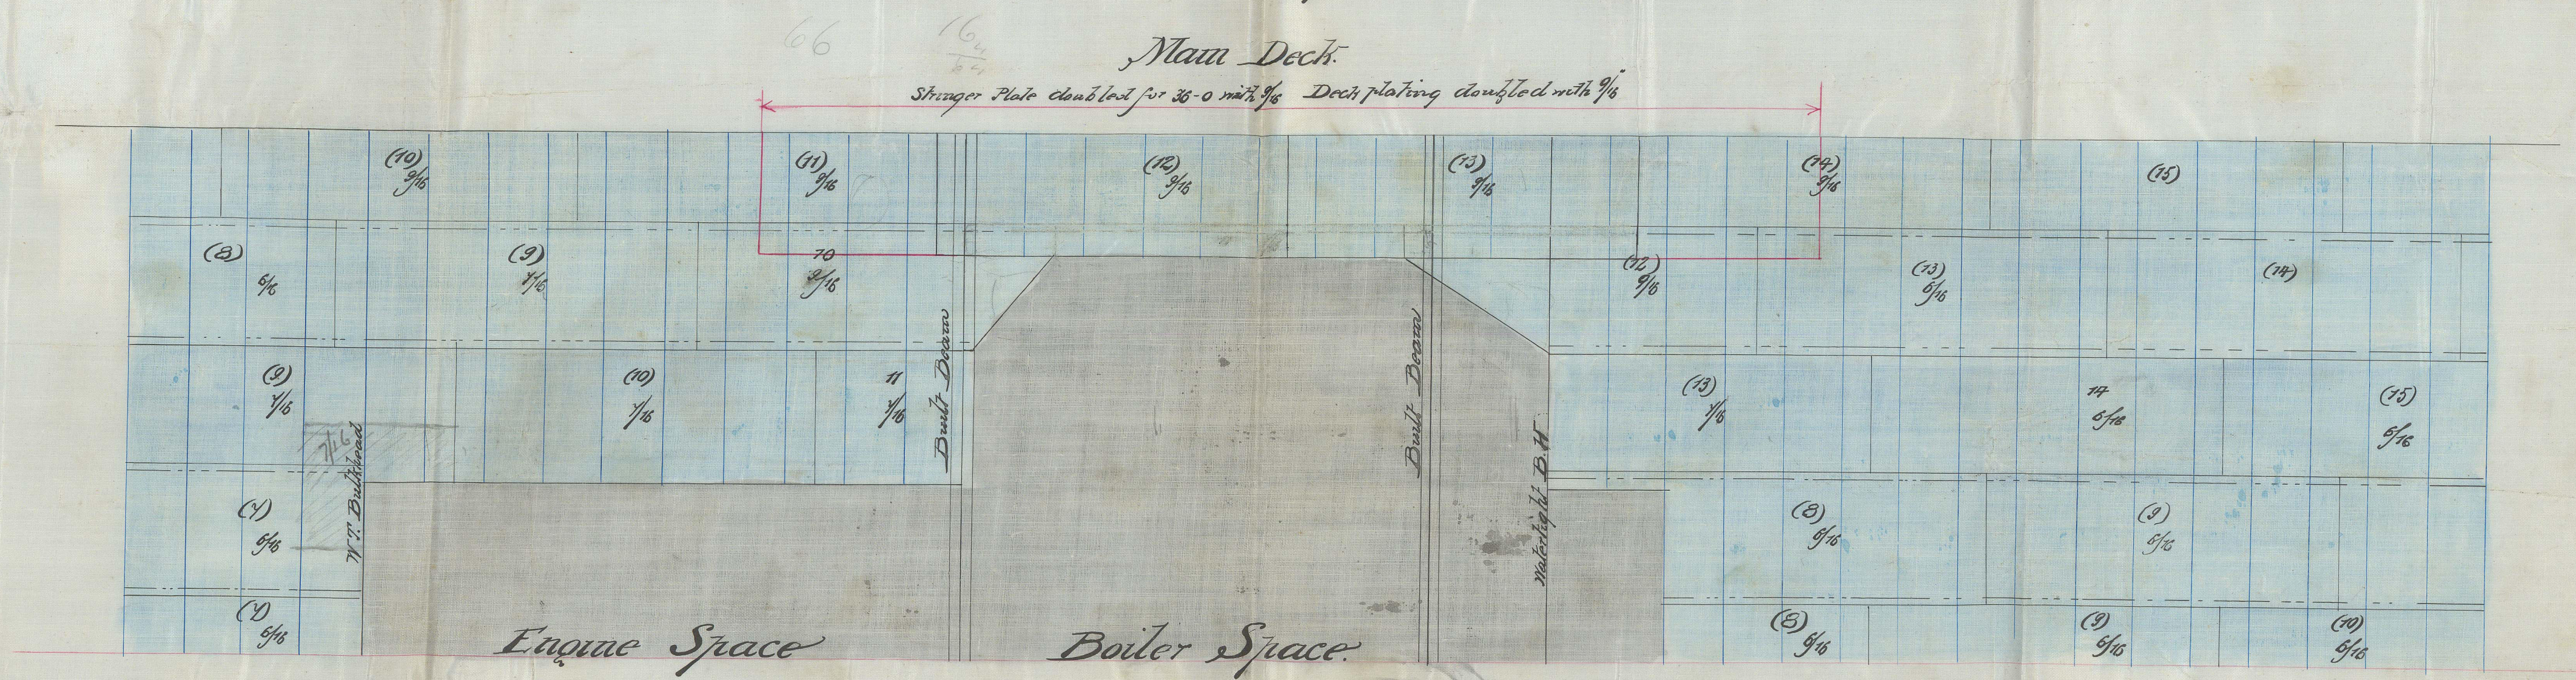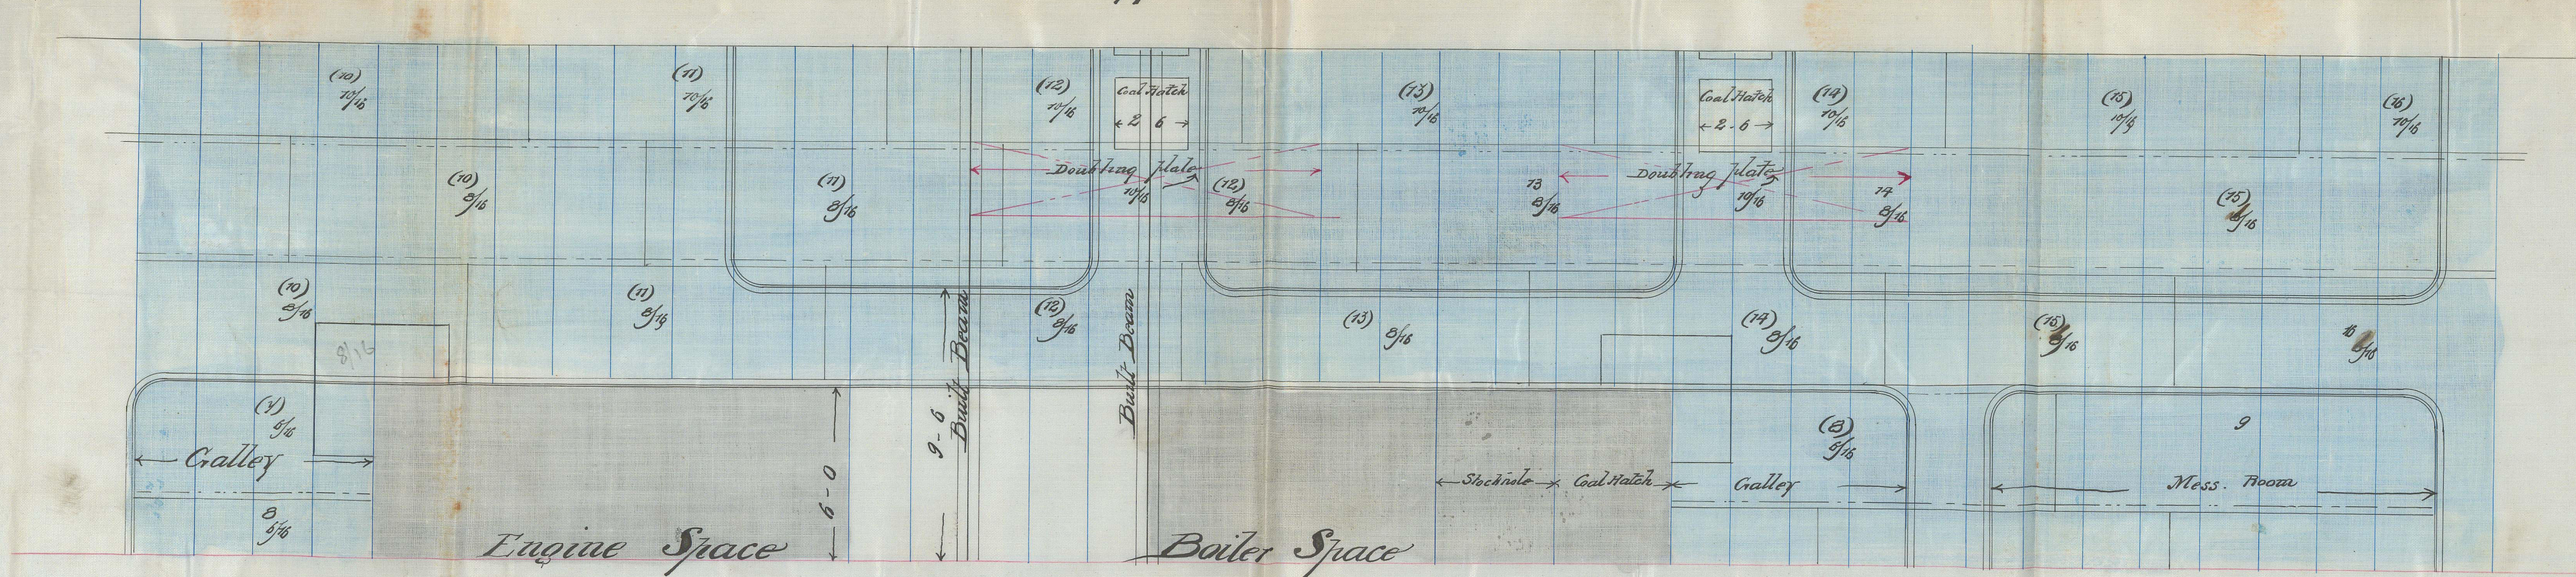

18th  
22/10/83

GIS200-0136