




Dr. to Els.
16/4/84.


Steel Masts & Yard for S.S. Nos 27 & 28.
Scale $\frac{1}{2}$ " = 1 foot in length & $\frac{1}{2}$ " = 1 foot in dia.
Foremast length overall 85 feet 3 inches
Mainmast 77 ft. 0 in
Lower Fore Yard 72 ft. 0 in

S.S. Bormida Glasgow Report No 6650.
S.S. Misagno do 6742.



Steel
Lower fore Yard.

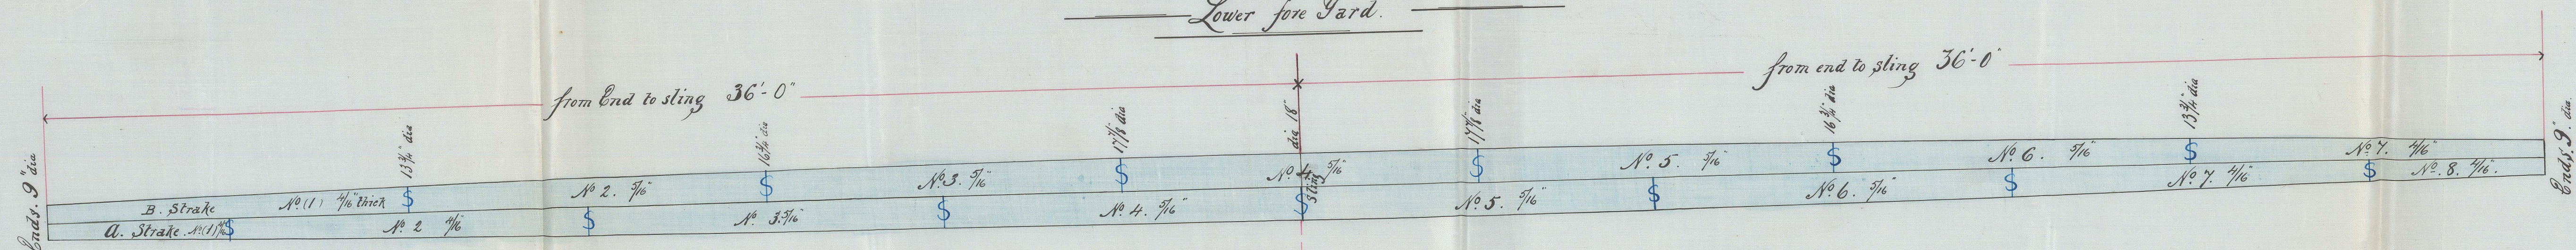


Iron
Foremast.

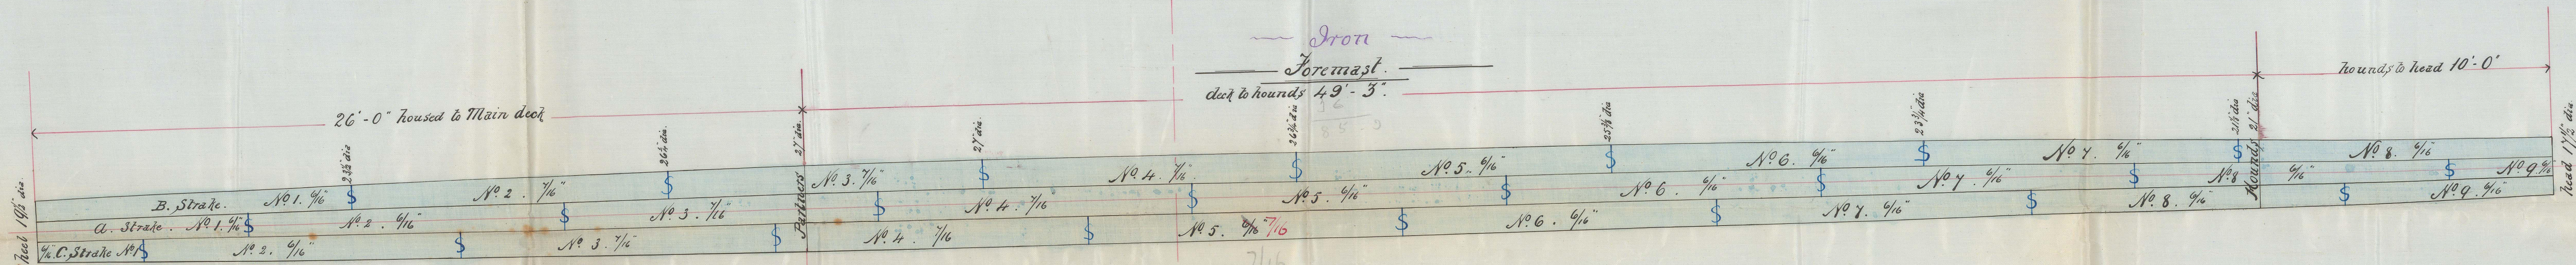


Iron
Mainmast

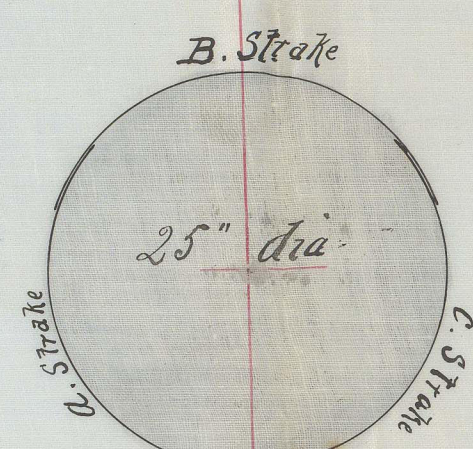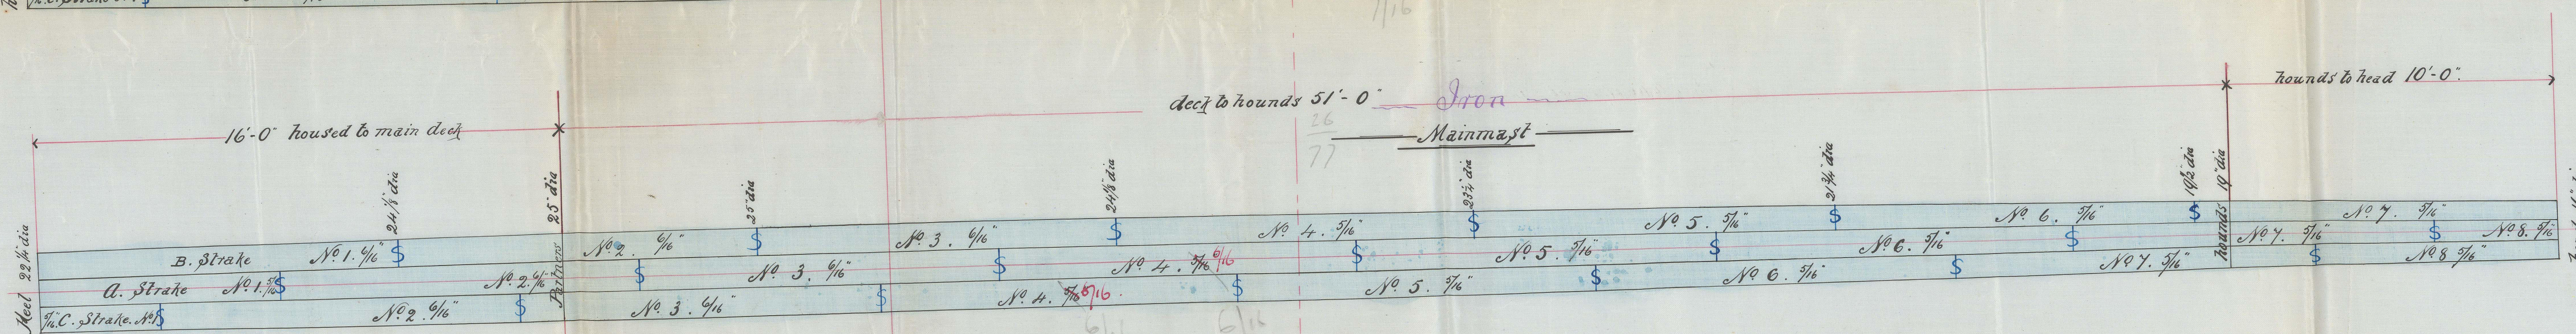


Section of Main Mast
at Partners
Scale 1" = 1 foot.

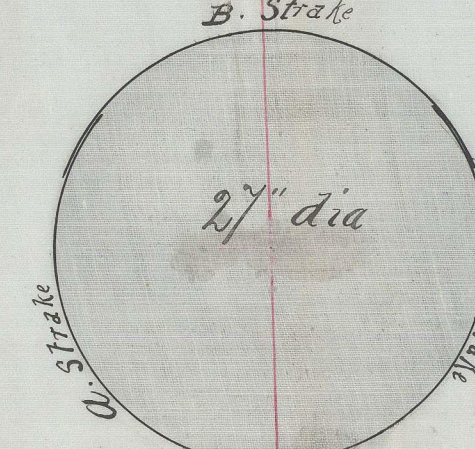

Section of Fore mast
at Partners
Scale 1" = 1 foot.

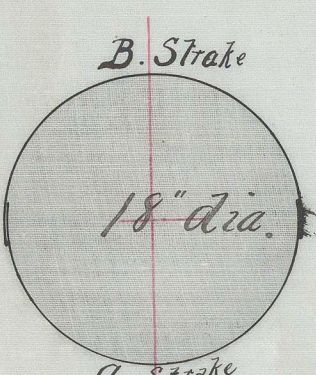

Section of Lower Fore Yard
at Sling
Scale 1" = 1 foot.

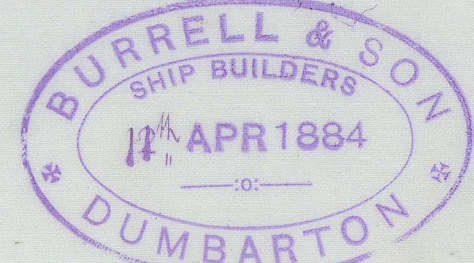

J.P.
17/4/84

GLS200-0137