


RECEIVED  
22 OCT. 83  
LONDON

S. S. <sup>a</sup> Bormida "Glasgow Report N<sup>o</sup> 6650. —  
S. S. Bisagno " — do — . 6742. —

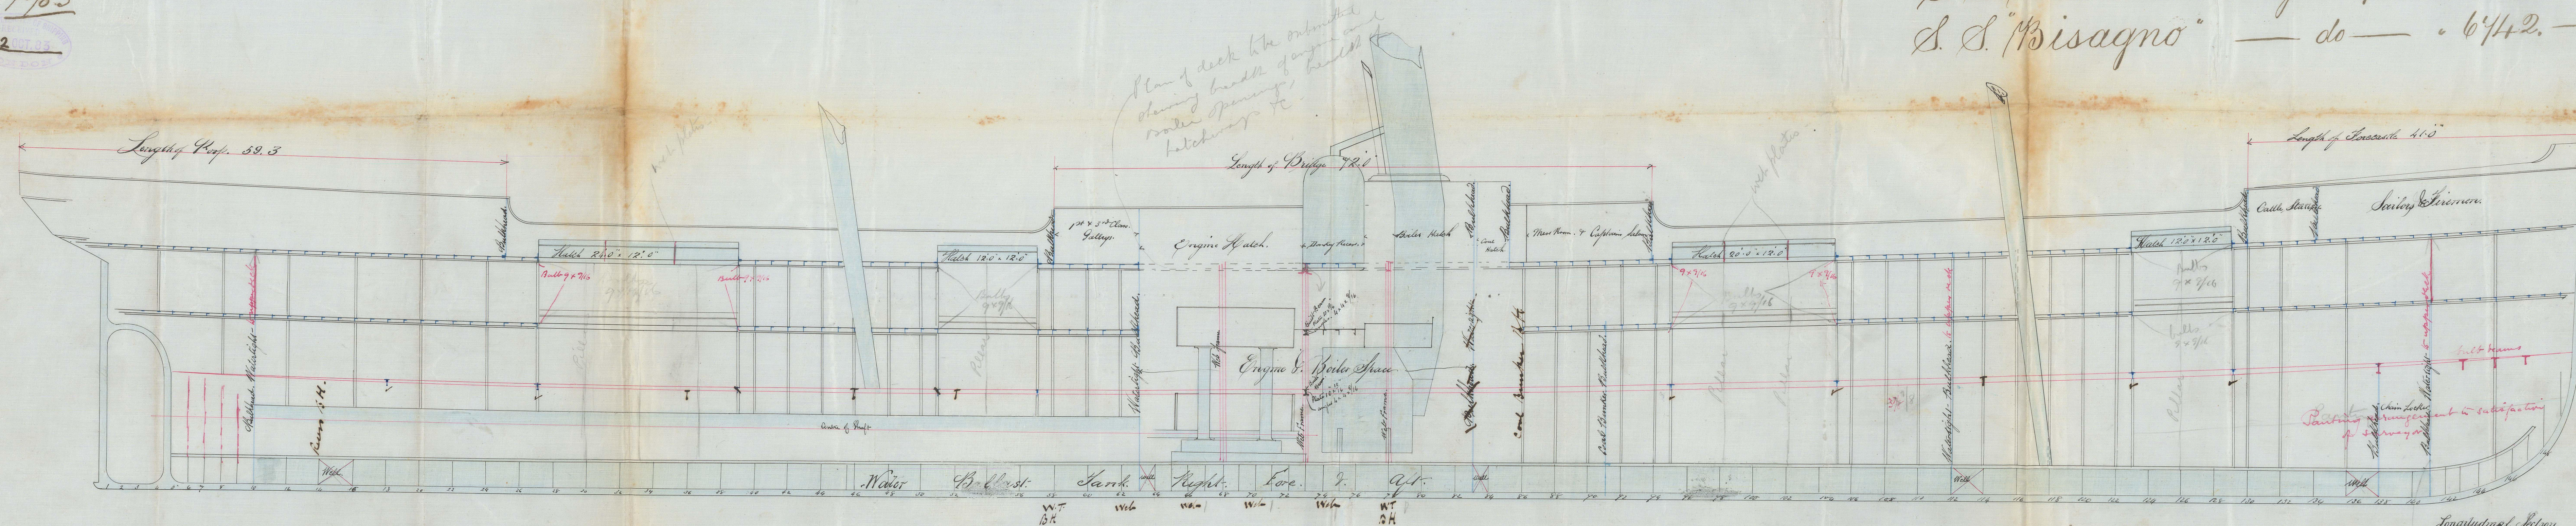

Longitudinal Section.

S. S. N<sup>o</sup> 2742

Scale  $\frac{1}{8}$ " = One

21. 2

18

A circular purple ink stamp. The outer ring contains the text "BURRELL &amp; SON" at the top and "DUMBARTON" at the bottom, separated by two small stars. Inside the ring, the words "SHIP BUILDERS" are written in a smaller arc. In the center, the date "8 MAY 1883" is stamped, with a horizontal line and a small circle below it.

GLS200-0138

© 202

Lloyd's Register  
Foundation