S. S. "Bormida" Glasgow Report No. 6650.–
S. S. "Bisagno" — do — " 6742.–

LLOYD'S REGISTER OF SHIPPING RECEIVED 22 OCT. 83 LONDON
LLOYD'S REGISTER OF SHIPPING RECEIVED 15 APR. 84 LONDON
LLOYD'S REGISTER OF SHIPPING RECEIVED -5 NOV. 83 LONDON
LLOYD'S REGISTER OF SHIPPING RECEIVED 21 JUN. 84 LONDON

Ltr: D.G.Os:
13/5/83
22:10:83
5:11:83
16:4:84

27 & 28

— Midship Section of S. S. No. 27 & 28 —
— To Class 100 A. 1 at Lloyds — on 3 Dk. Rules
— Scale ½" One Foot. —

Forecastle Beams 6½ x 6/16 Angles 3 x 2¼ x 5/16"
Stringer 43½ x 7/16 Ends 30 x 6/16
"Poop." Beams 6½ x 3 x 8/16
" Stringer 43½ x 7/16 ends 30 x 6/16

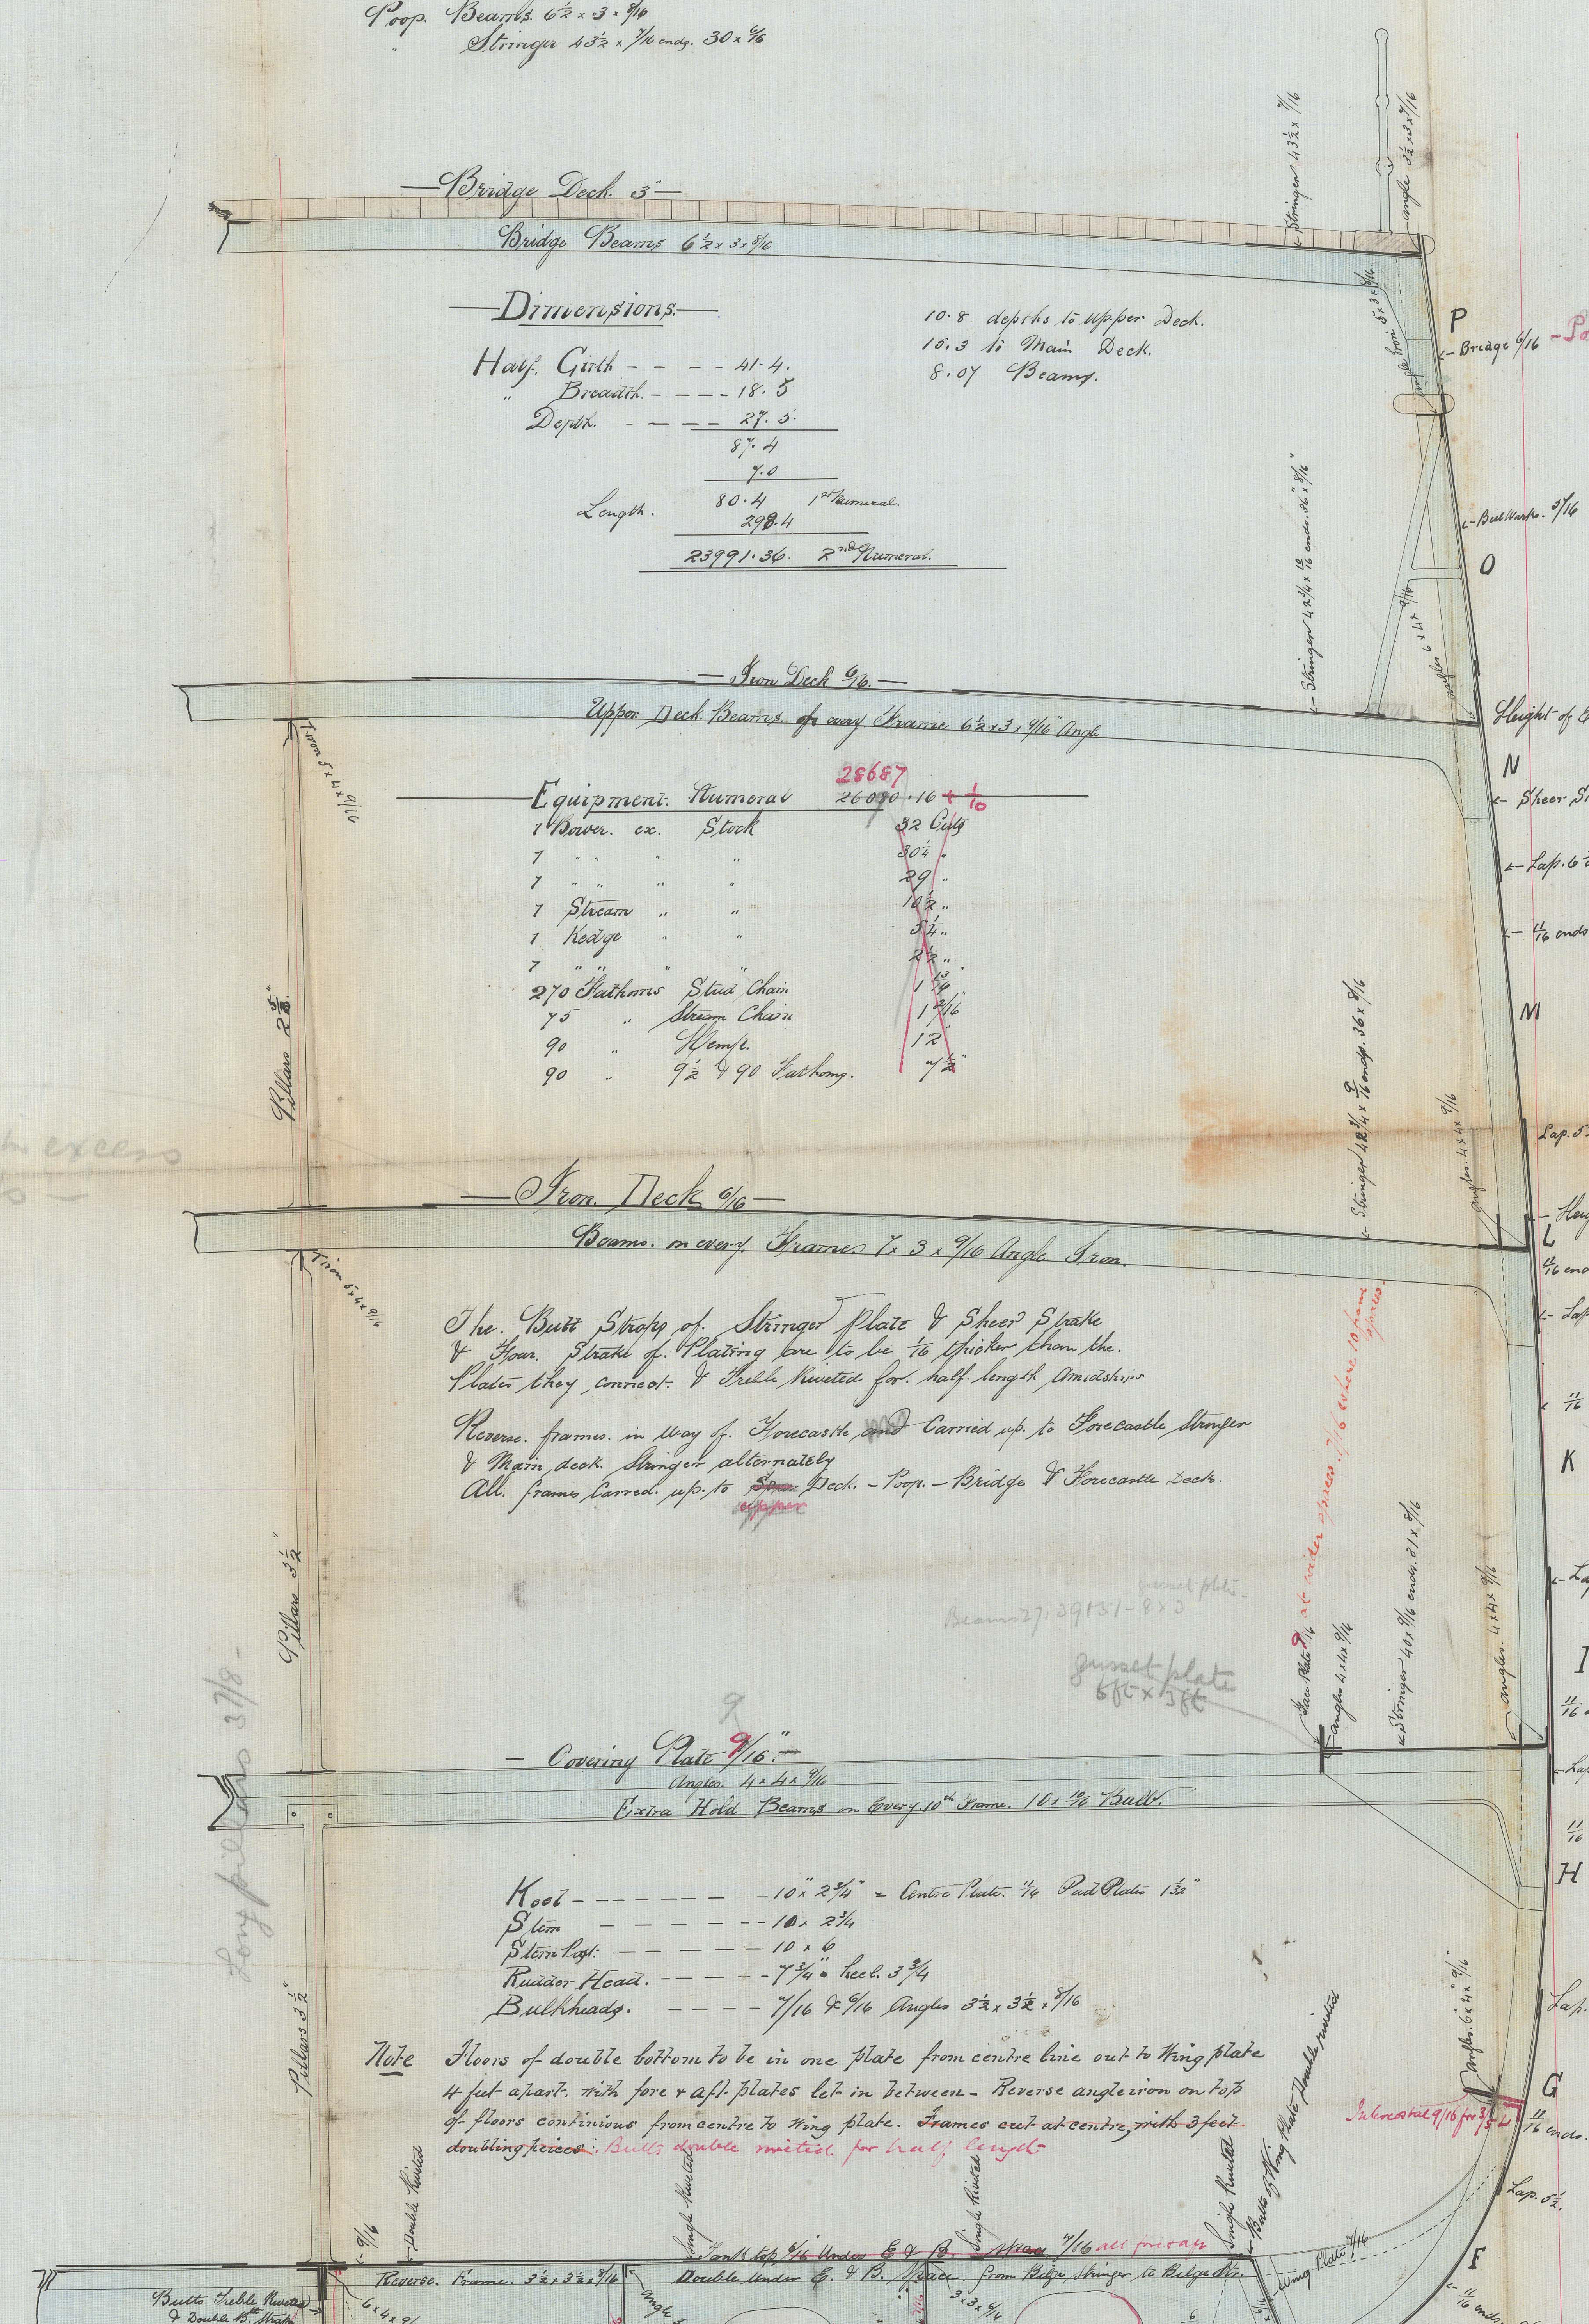

J.H.L.
12/5/83

BURRELL & SON SHIP BUILDERS 8 MAY 1883 DUMBARTON

GLS200-0139
© 2021 Lloyd's Register Foundation