



  
 L.R. 15/9/84.  


GLS200-0153


**PLAN OF BRIDGE & AWNING DECK**  
**OF**  
**S.S. "CAPE CLEAR"** now S.S. "Tekapo" Glasgow Report No. 6752.  
 SCALE  $\frac{1}{4}$ " = 1 FOOT.

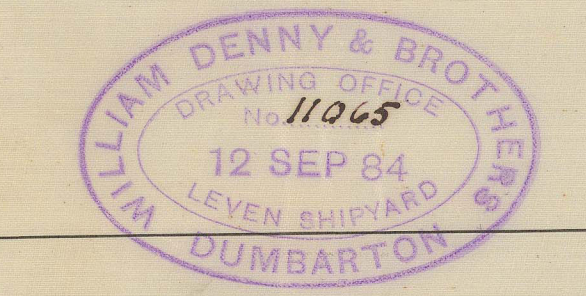

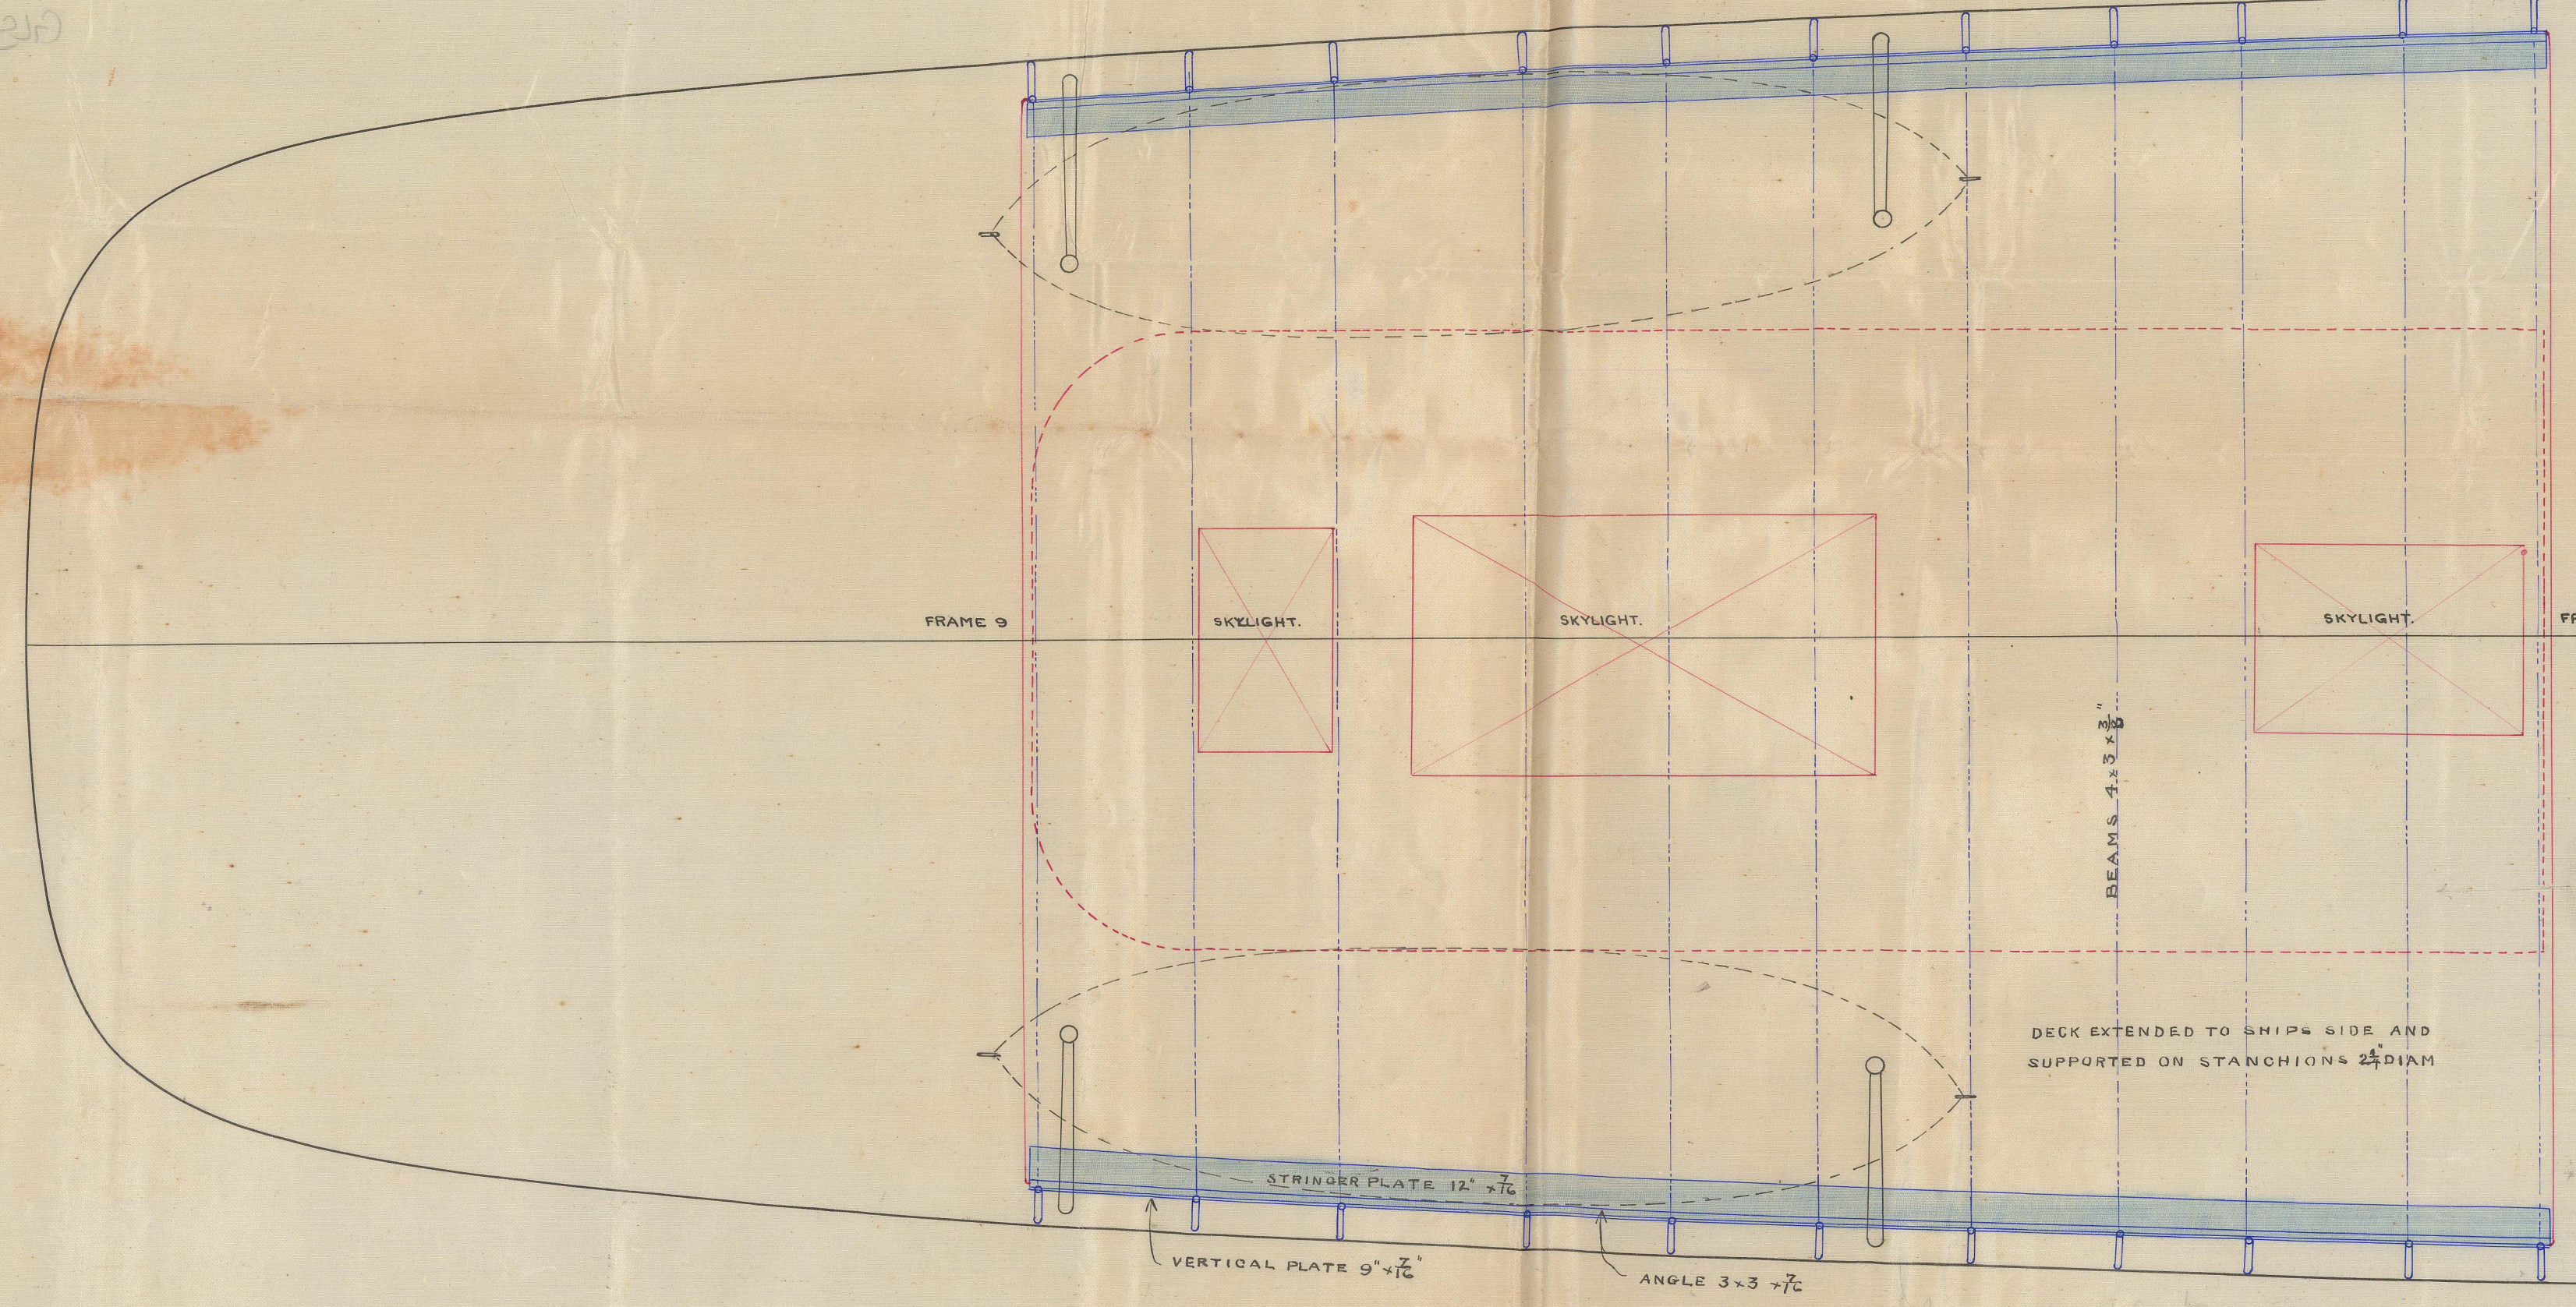

**NOTE** { OLD WORK SHOWN IN BLACK  
 " " " " " " BLUE  
 " " " " " " RED

SEE ALSO SECTION OF BRIDGE DECK

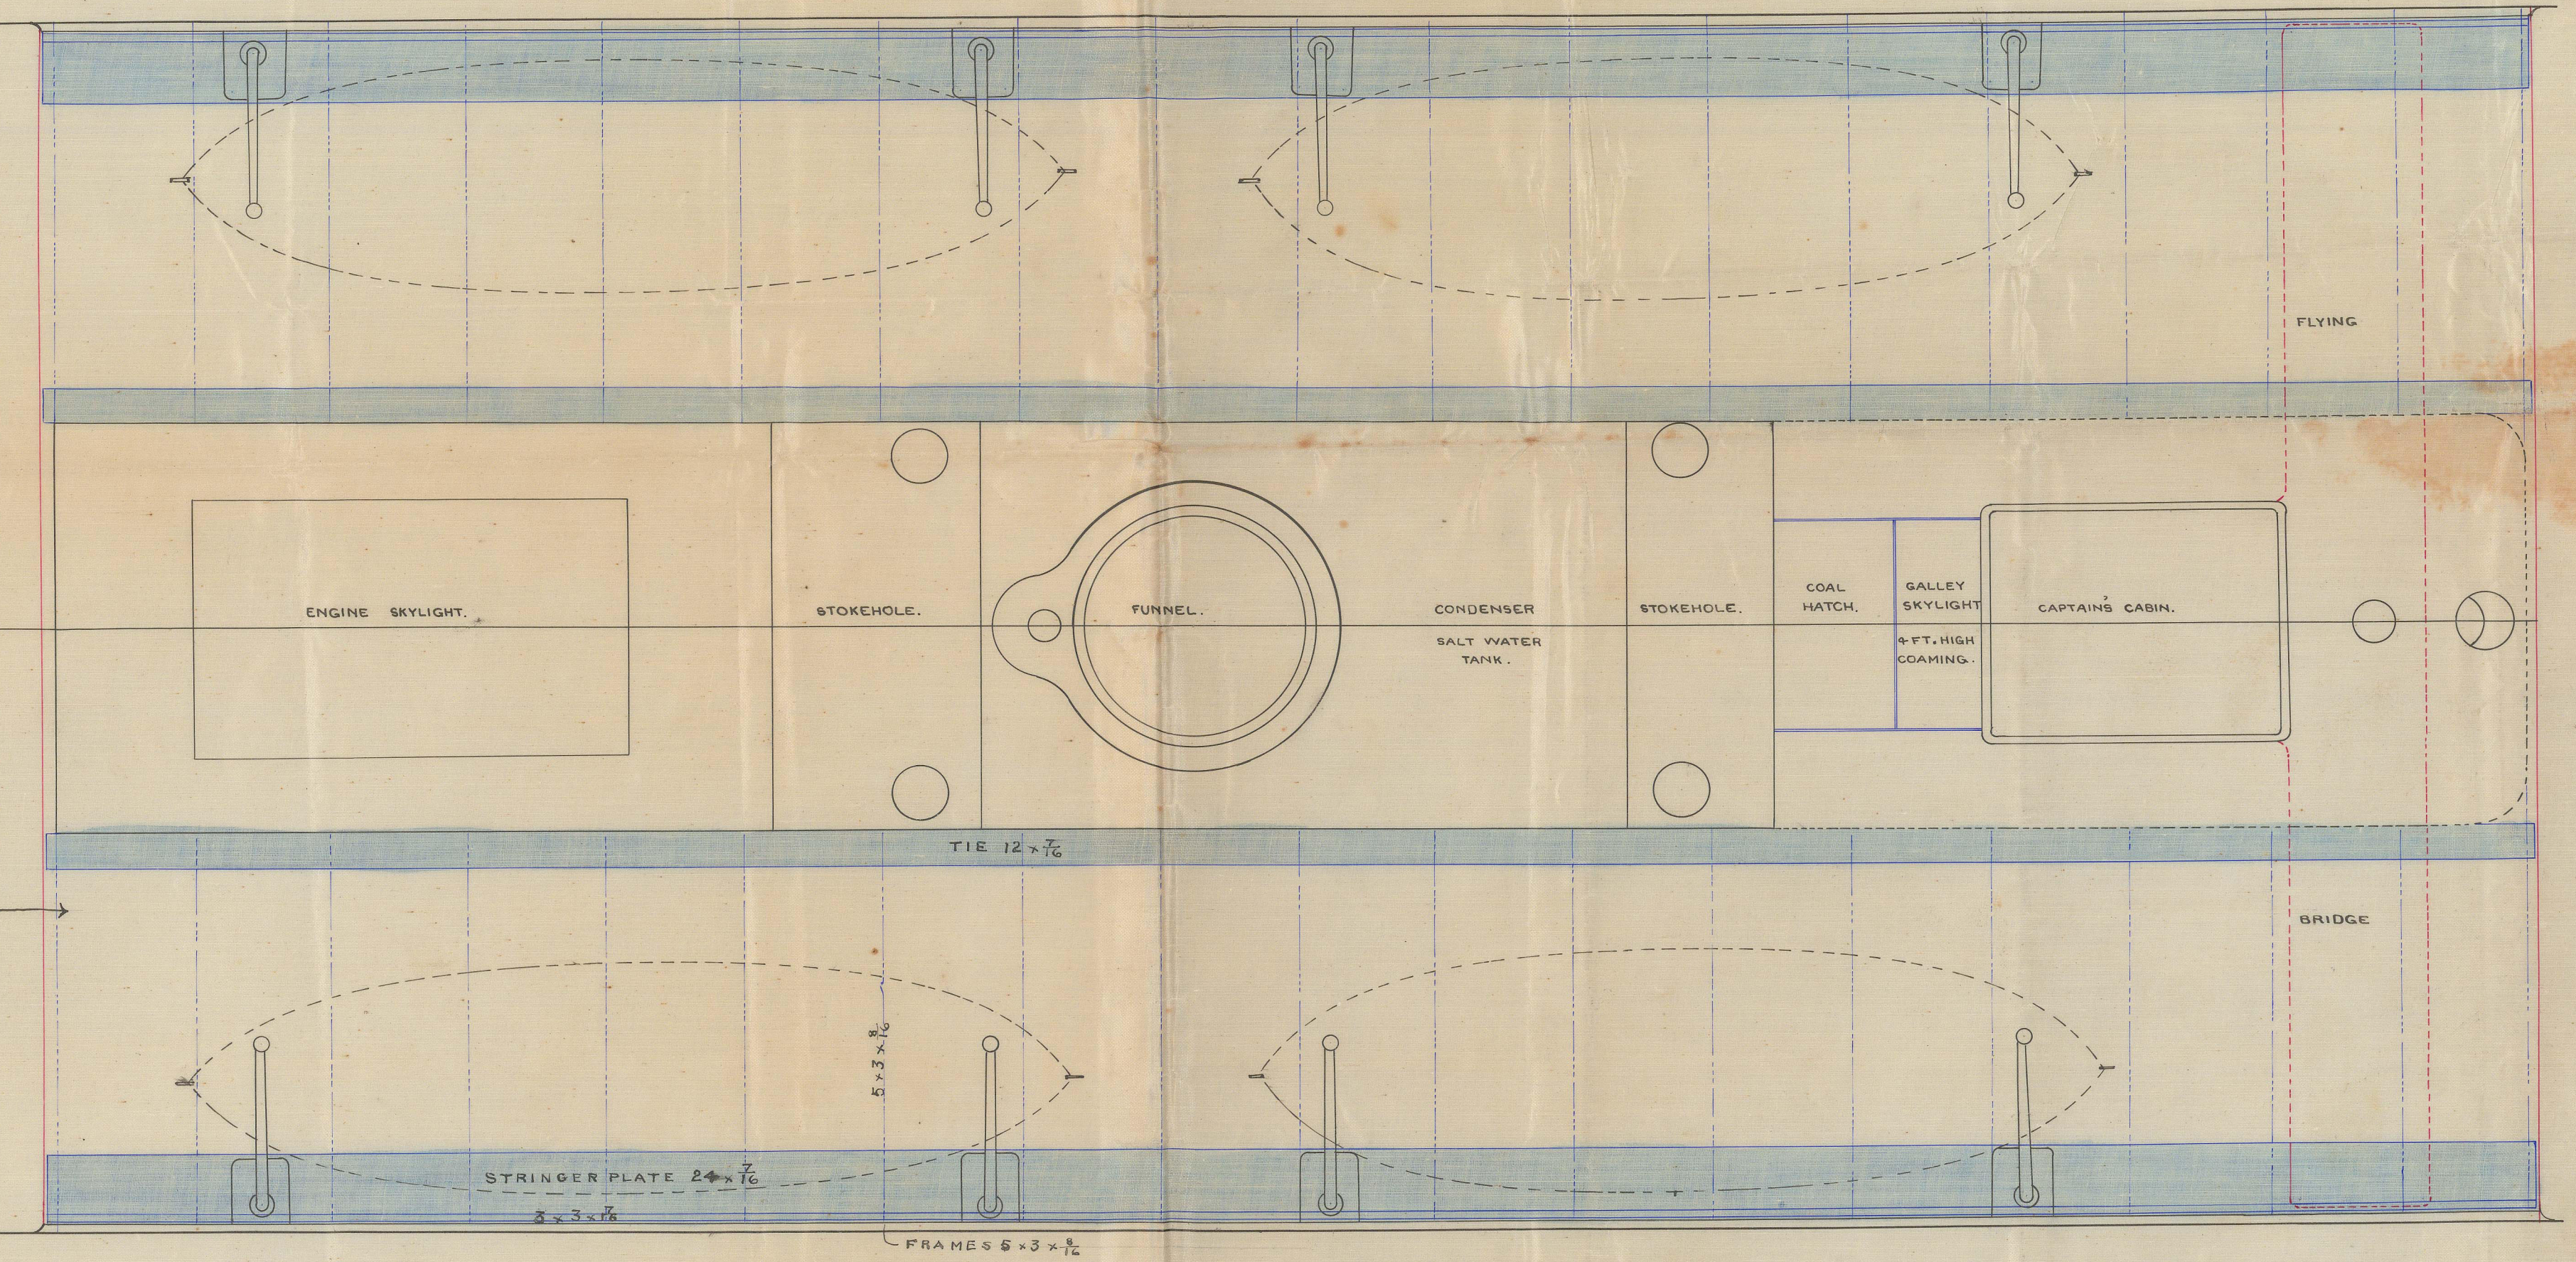


L.R.  
 15/9/84

GLS200-0153




6452-


Mr. A. K. K. K.  
12/21/84

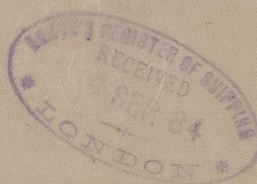

GLS 200-0153

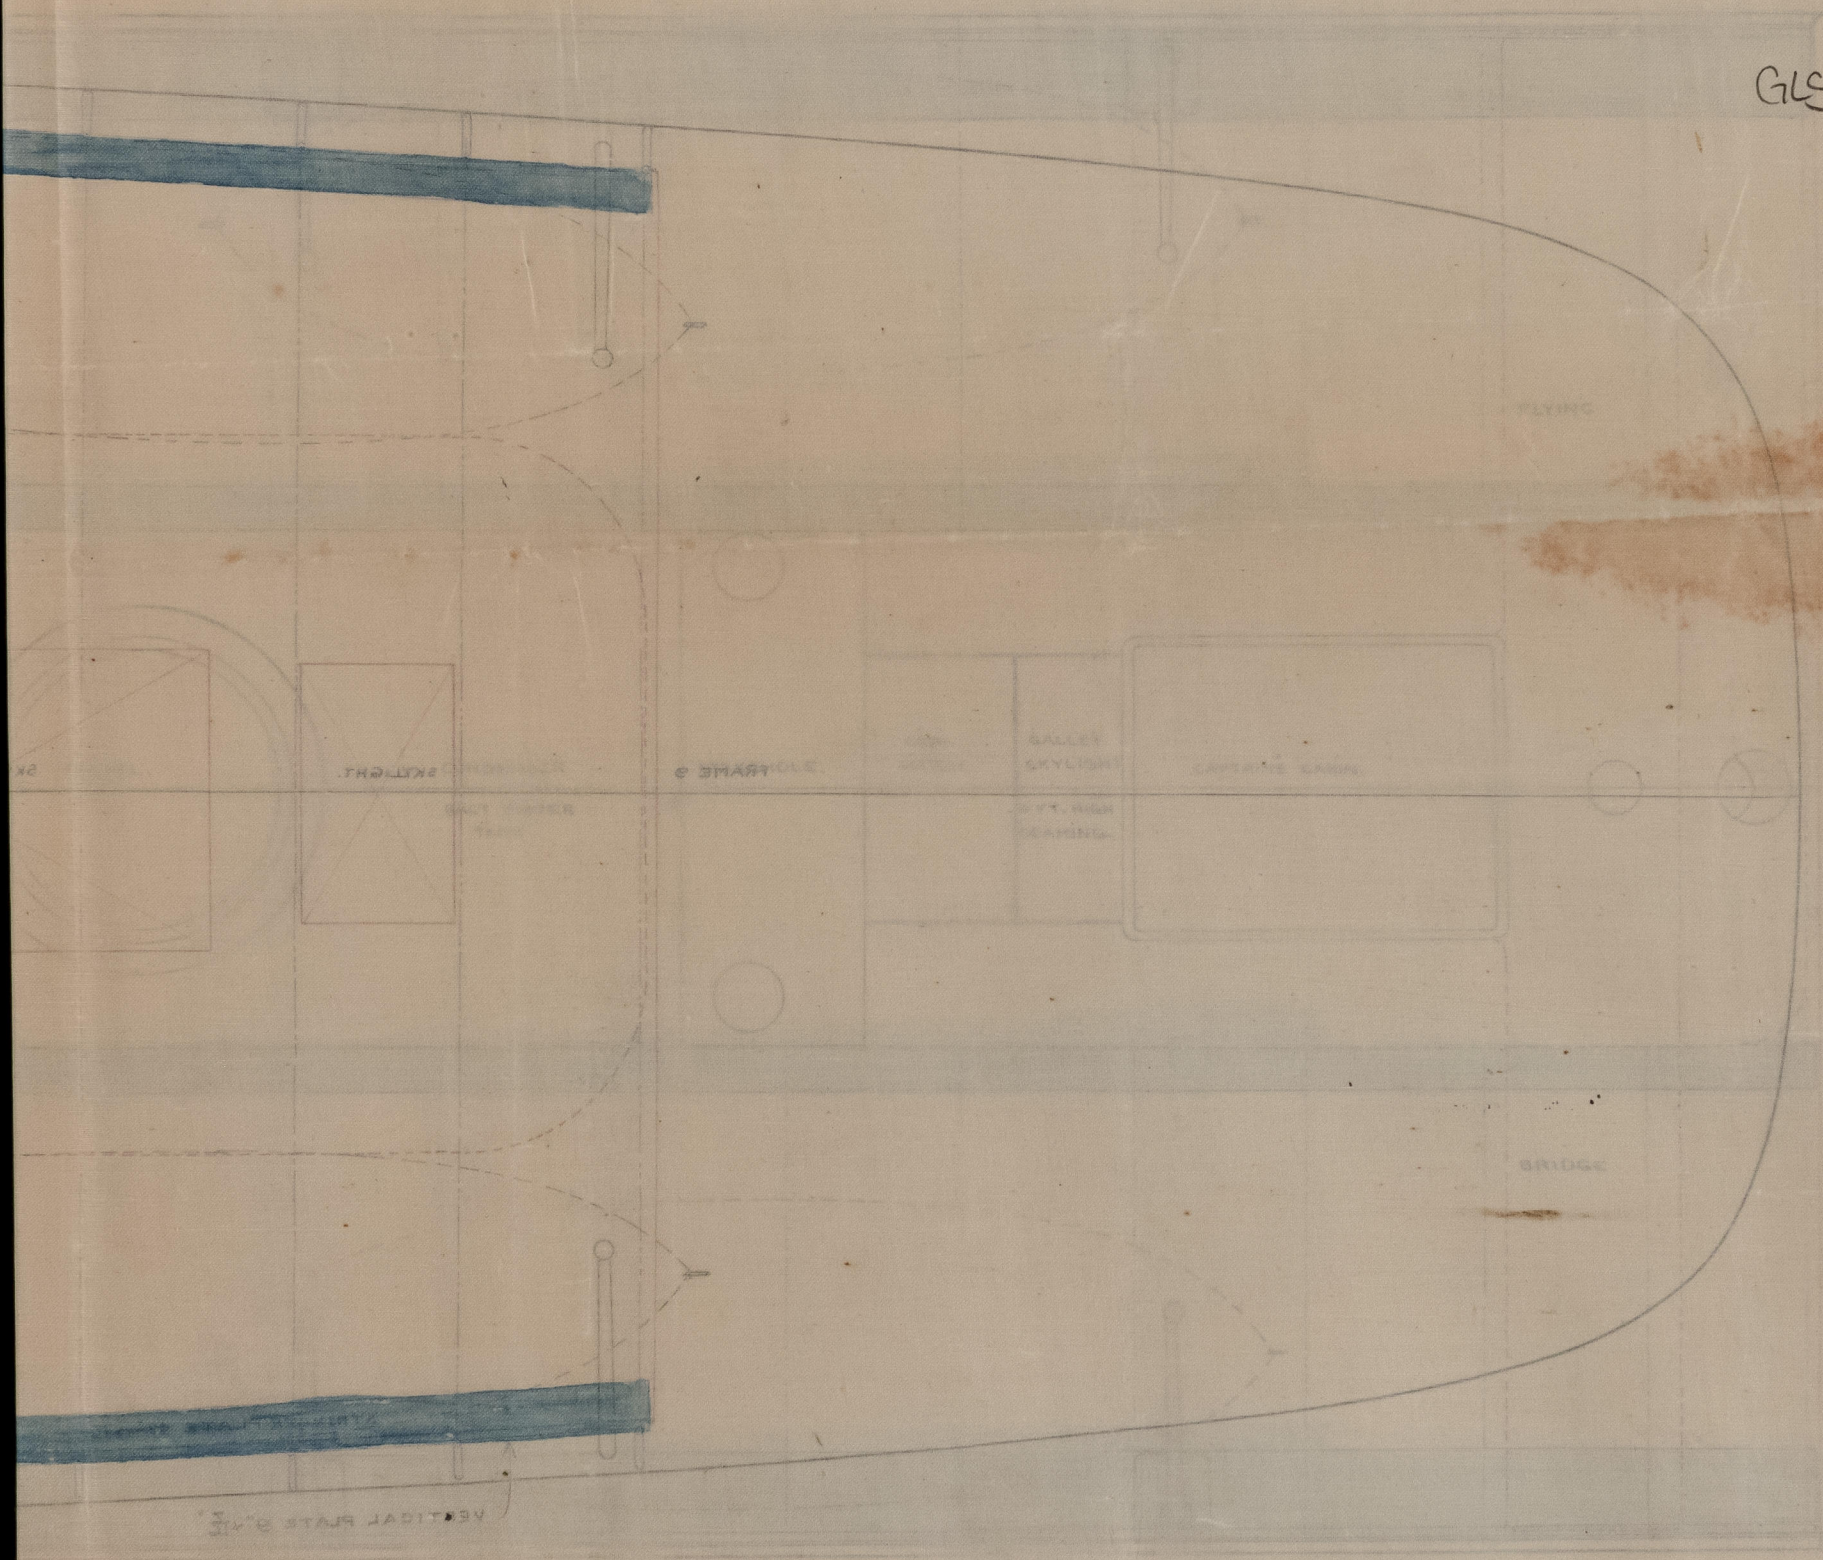

12/21/84

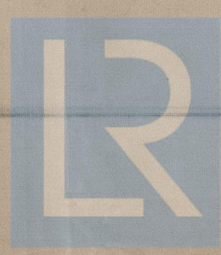

© 2021

Lloyd's Register  
Foundation