



Dr. & Co.
19/84

PLAN OF SPAR DECK
S.S. "CAPE CLEAR"
SCALE 1" = 10' 0"

NOTE: — ALL OLD WORK SHOWN IN BLACK
ALL NEW IRON — — — BLUE
ALL NEW WOOD — — — RED

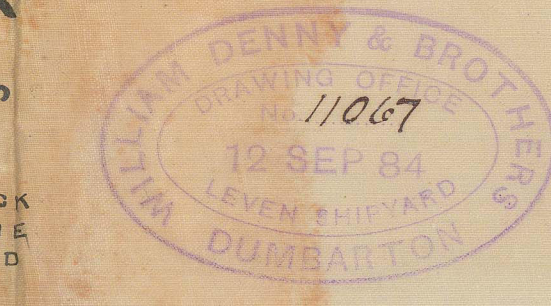

now S.S. "Tekapo" Glasgow Report No 6452.

 

17/1
19/84

GLS200-0154



Lloyd's Register
Foundation