



Lt. D. Llo.  
15/9/84

# SKETCH OF NEW BRIDGE DECK


S. S. "CAPE CLEAR"

now S. S. "Tekapo"


SCALE  $\frac{1}{2}$ " = 1 FOOT

Glasgow Report


No 6452-

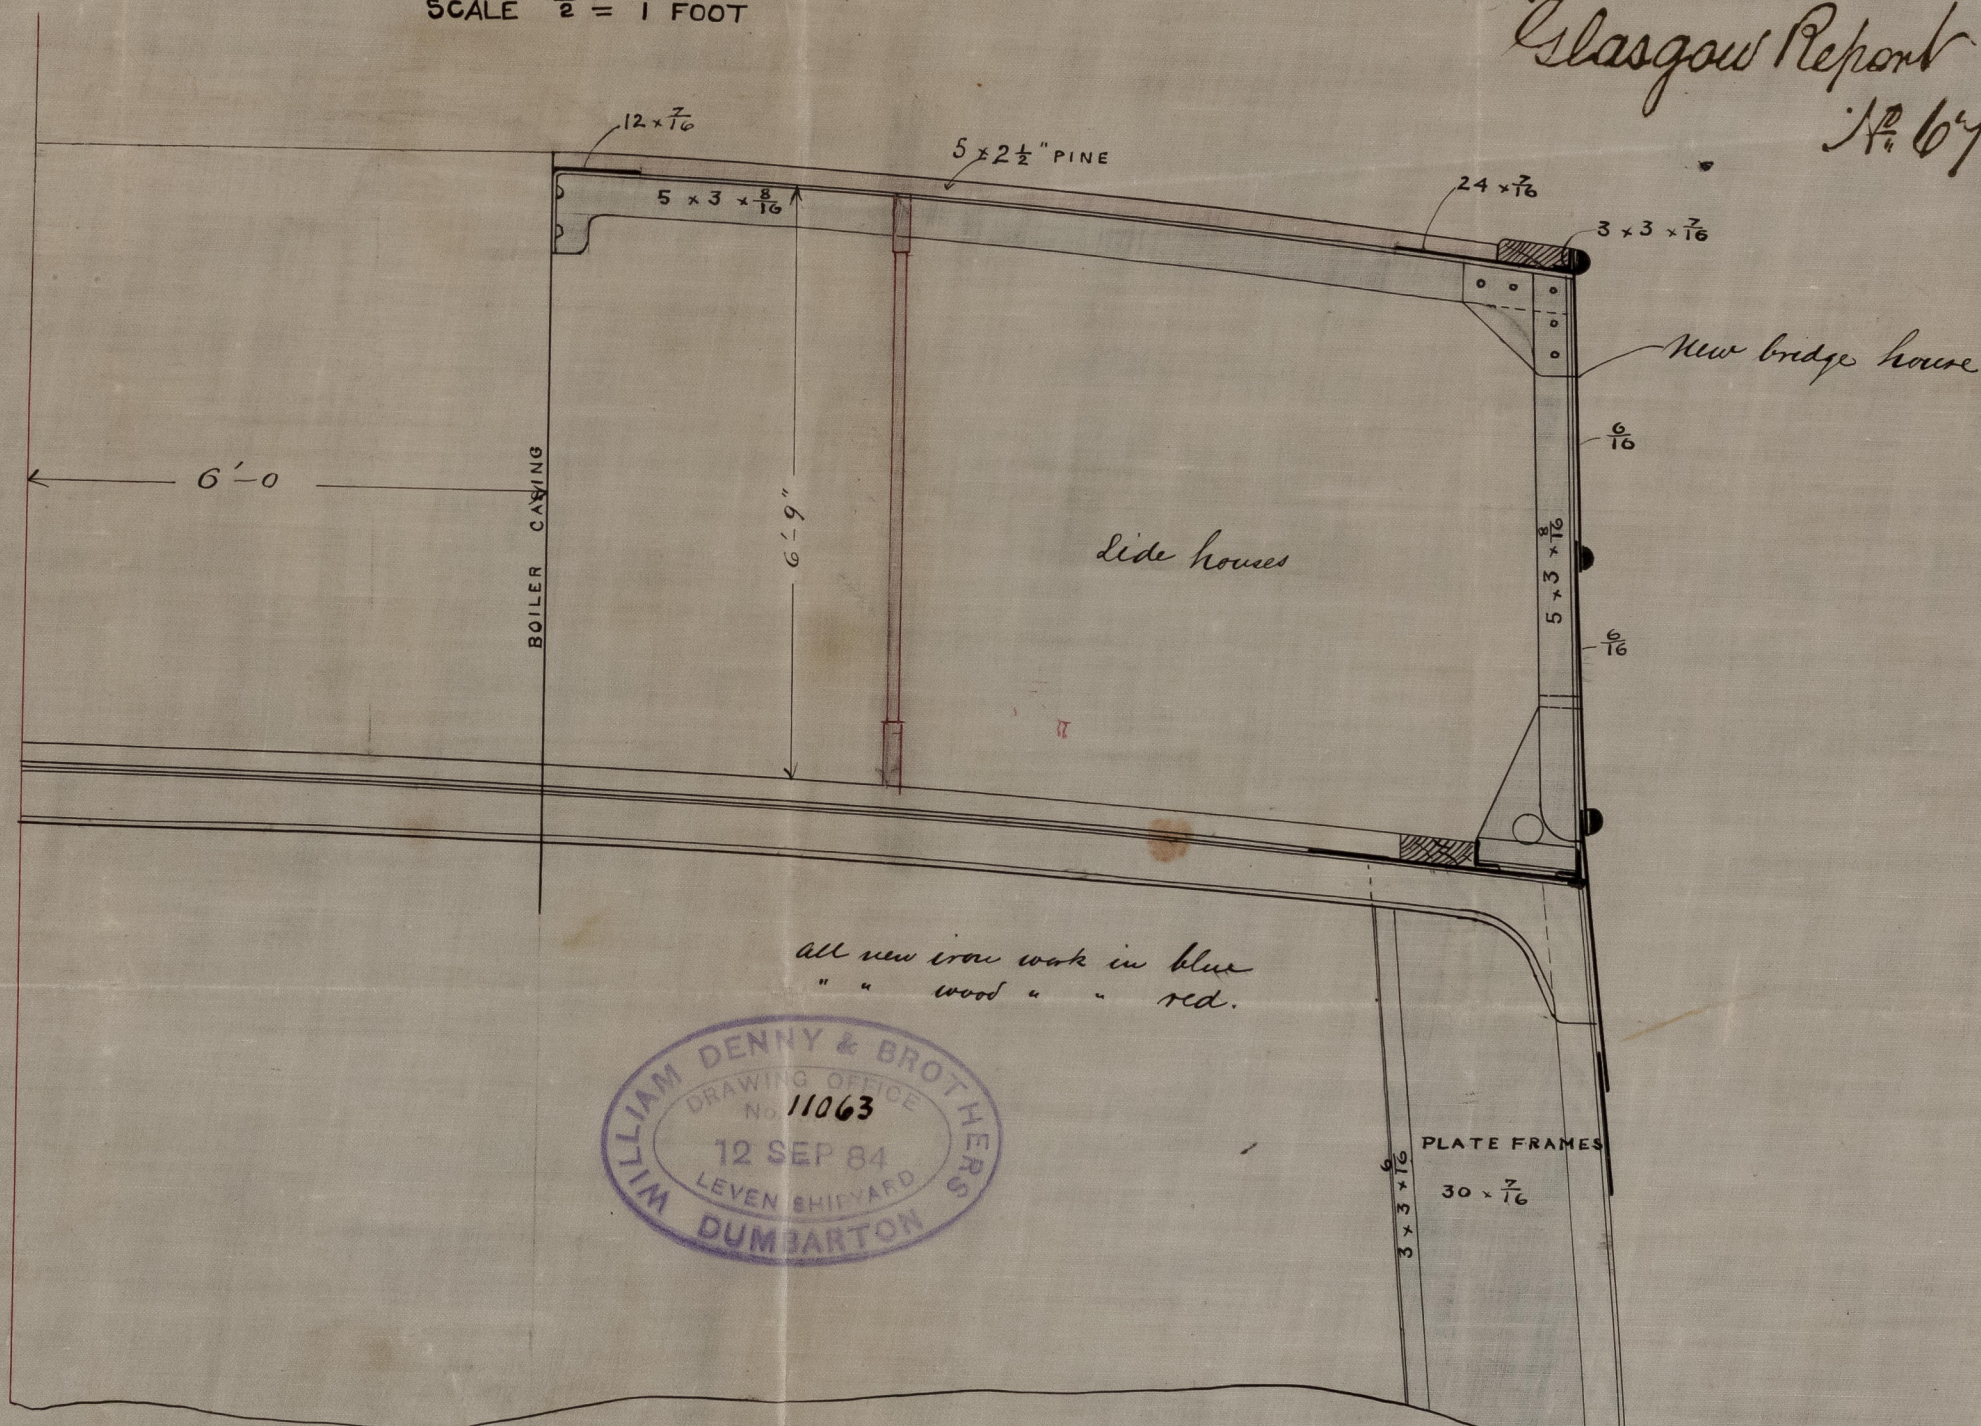

all new iron work in blue  
" " wood " " red.

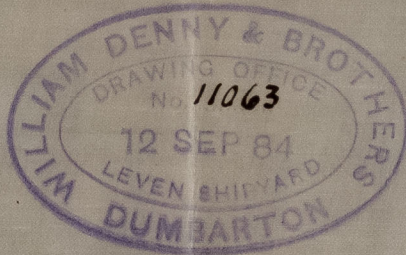

Lt. D. Llo.  
15/9/84

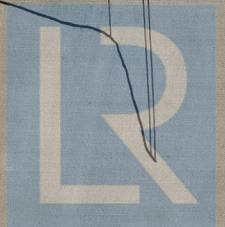

© 2021

Lloyd's Register Foundation

GLS200-0155