

Lloyd's Register of British and Foreign Shipping.

(Report on Vessel No. 6453 Port Glasgow)

No. 834 SHIP FORGINGS OR CASTINGS.

The words FORGINGS or CASTINGS, IRON or STEEL, should be struck out as may be required.

I have to report that the undermentioned Iron ~~or Steel~~ Forgings ~~or Castings~~, manufactured by The Portland Forge Co of Kilmarnock for the Vessel No. 258, being built by Messrs A. McMillan & Son of Dumbarton have been inspected by me as set forth below, and found to be, so far as can be seen, sound and efficient

Mark on Forgings.

Lloyd's
No. 834
G. N.


George Newcomb

Glasgow

14/8/84.

	STERN FRAME.	RUDDER FRAME.	STEM.
Material* - - - -	/	Scrap iron	/
How made - - - -		Forged	
Dimensions - - - -		6 3/4 & 3 1/2	
Progress on Inspection -		Forged and smithed	
Dates when Inspected		6.13.20.30/6/84. 10.17/7/84.	

SKETCHES OF FRAMES SHEWING POSITION AND DESCRIPTION OF WELDS OF FORGINGS, OR PARTICULARS OF TESTS APPLIED TO CASTINGS.

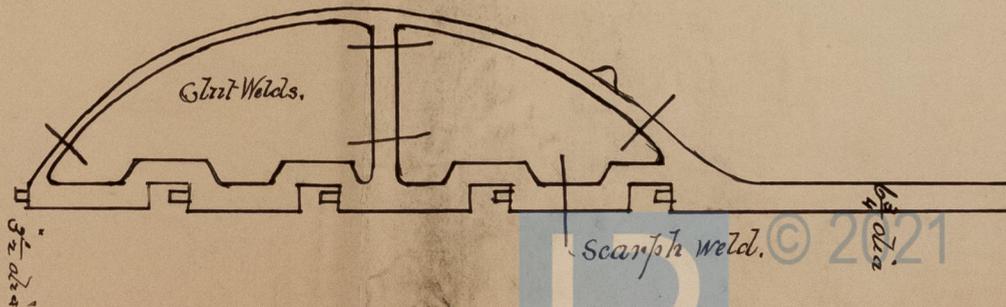

* If of Iron, state whether scrap or puddled Iron.

