



D. L. L. L. L.
 5/9/84

S.S. "Rossquill" Glasgow Report No. 6460.

Arrangement of Pumps, &c.

S.S. No 29.

Scale 1/8" = 1 foot

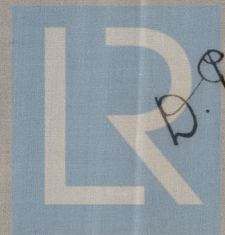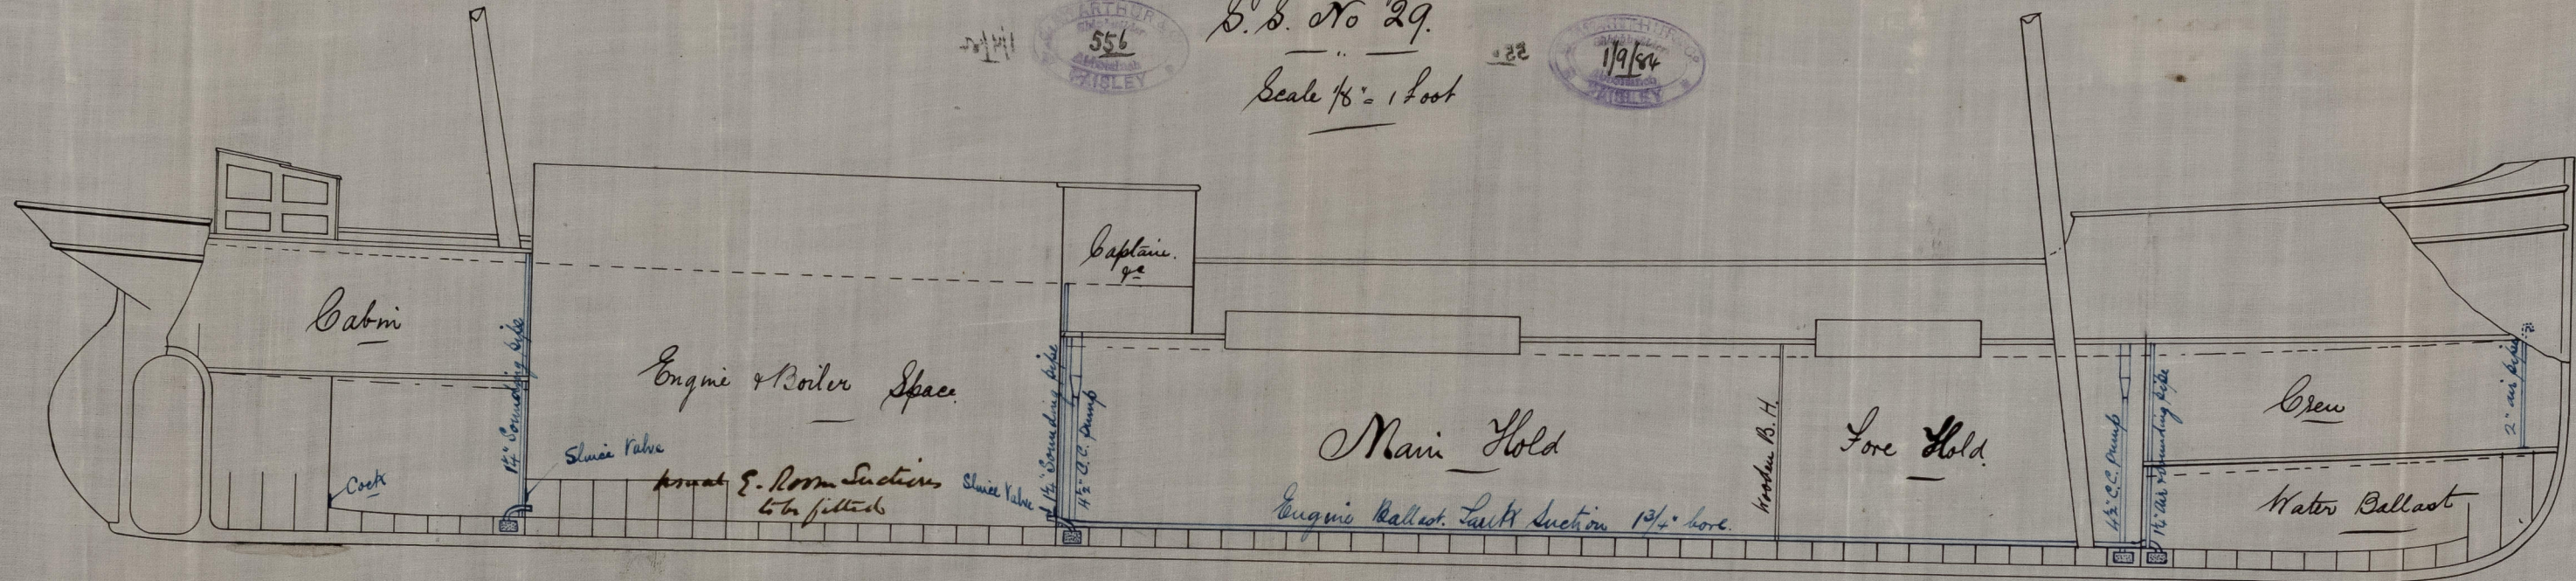

© 2021

Lloyd's Register
 Foundation

GLS200-0166