

Lloyd's Register of British and Foreign Shipping.

(Report on Vessel No. 6460 Port Glasgow)

No. 96.A. SHIP FORGINGS OR CASTINGS.

I have to report that the undermentioned Iron or Steel Forgings or Castings, manufactured by Messrs Casley & Binnett of Newcastle for the Vessel No. 29, being built by Messrs J McArthur & Co. of Paisley have been inspected by me as set forth below, and found to be, so far as can be seen, sound and efficient.



Mark on Forgings.

Lloyd's
No. 96.A.
R.C.

H. Cameron,
Sunderland.

	STERN FRAME.	RUDDER FRAME.	STEM.
Material* - - - -	<u>Scrap Iron</u>	<u>Scrap Iron</u>	<u>Scrap Iron</u>
How made - - - -	<u>Forged</u>	<u>Forged</u>	<u>Forged</u>
Dimensions - - - -	<u>6 1/4" x 3 1/4"</u>	<u>3 3/4" x 2 1/4"</u>	<u>6 1/4" x 1 5/8"</u>
Progress on Inspection -	<u>Forged and Smithed</u>	<u>Forged & smithed</u>	<u>Forged</u>
Dates when Inspected	<u>June 6-12-16-23 July 3-7-10 14-17/84</u>	<u>July 3-7-10 Aug 5-11-14 19-24-30/84</u>	<u>June 6-12-23/84</u>

SKETCHES OF FRAMES SHEWING POSITION AND DESCRIPTION OF WELDS OF FORGINGS, OR PARTICULARS OF TESTS APPLIED TO CASTINGS.

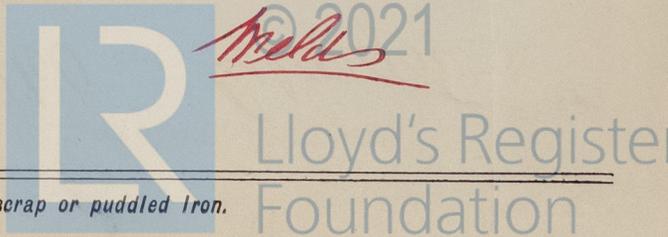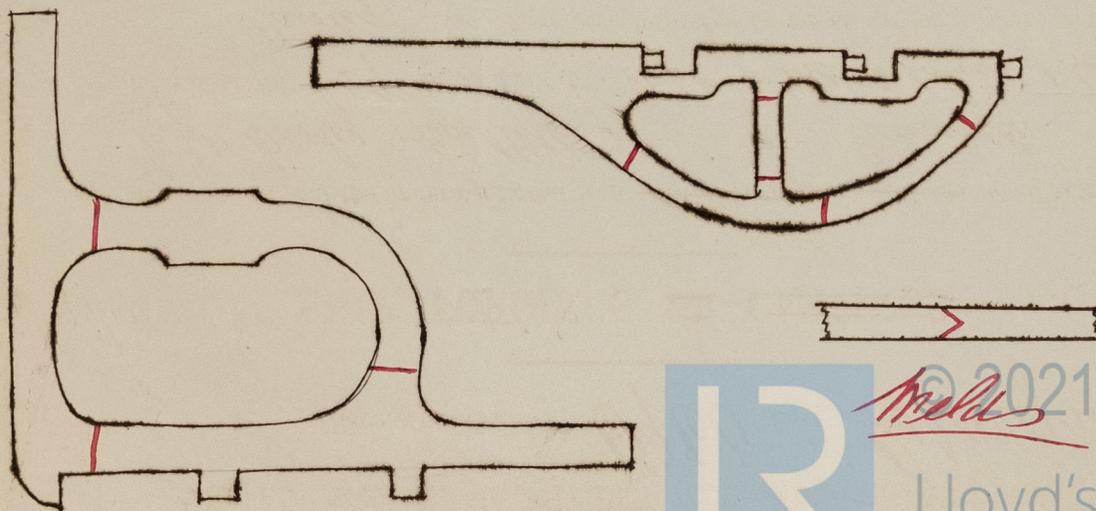

* If of Iron, state whether scrap or puddled Iron.