

21 FEB. 84

S. S. "Chau" Glasgow Report No. 6436.
S. S. "Saupo" do do 6484.


WILLIAM DENNY & BROS. LTD.
ENGINEERS

SKETCH SHEWING STRENGTHENING AMIDSHIPS

S. S. No. 284 v. 5

SCALE 1" = ONE FOOT

Ltr. to Cels:
22/2/84

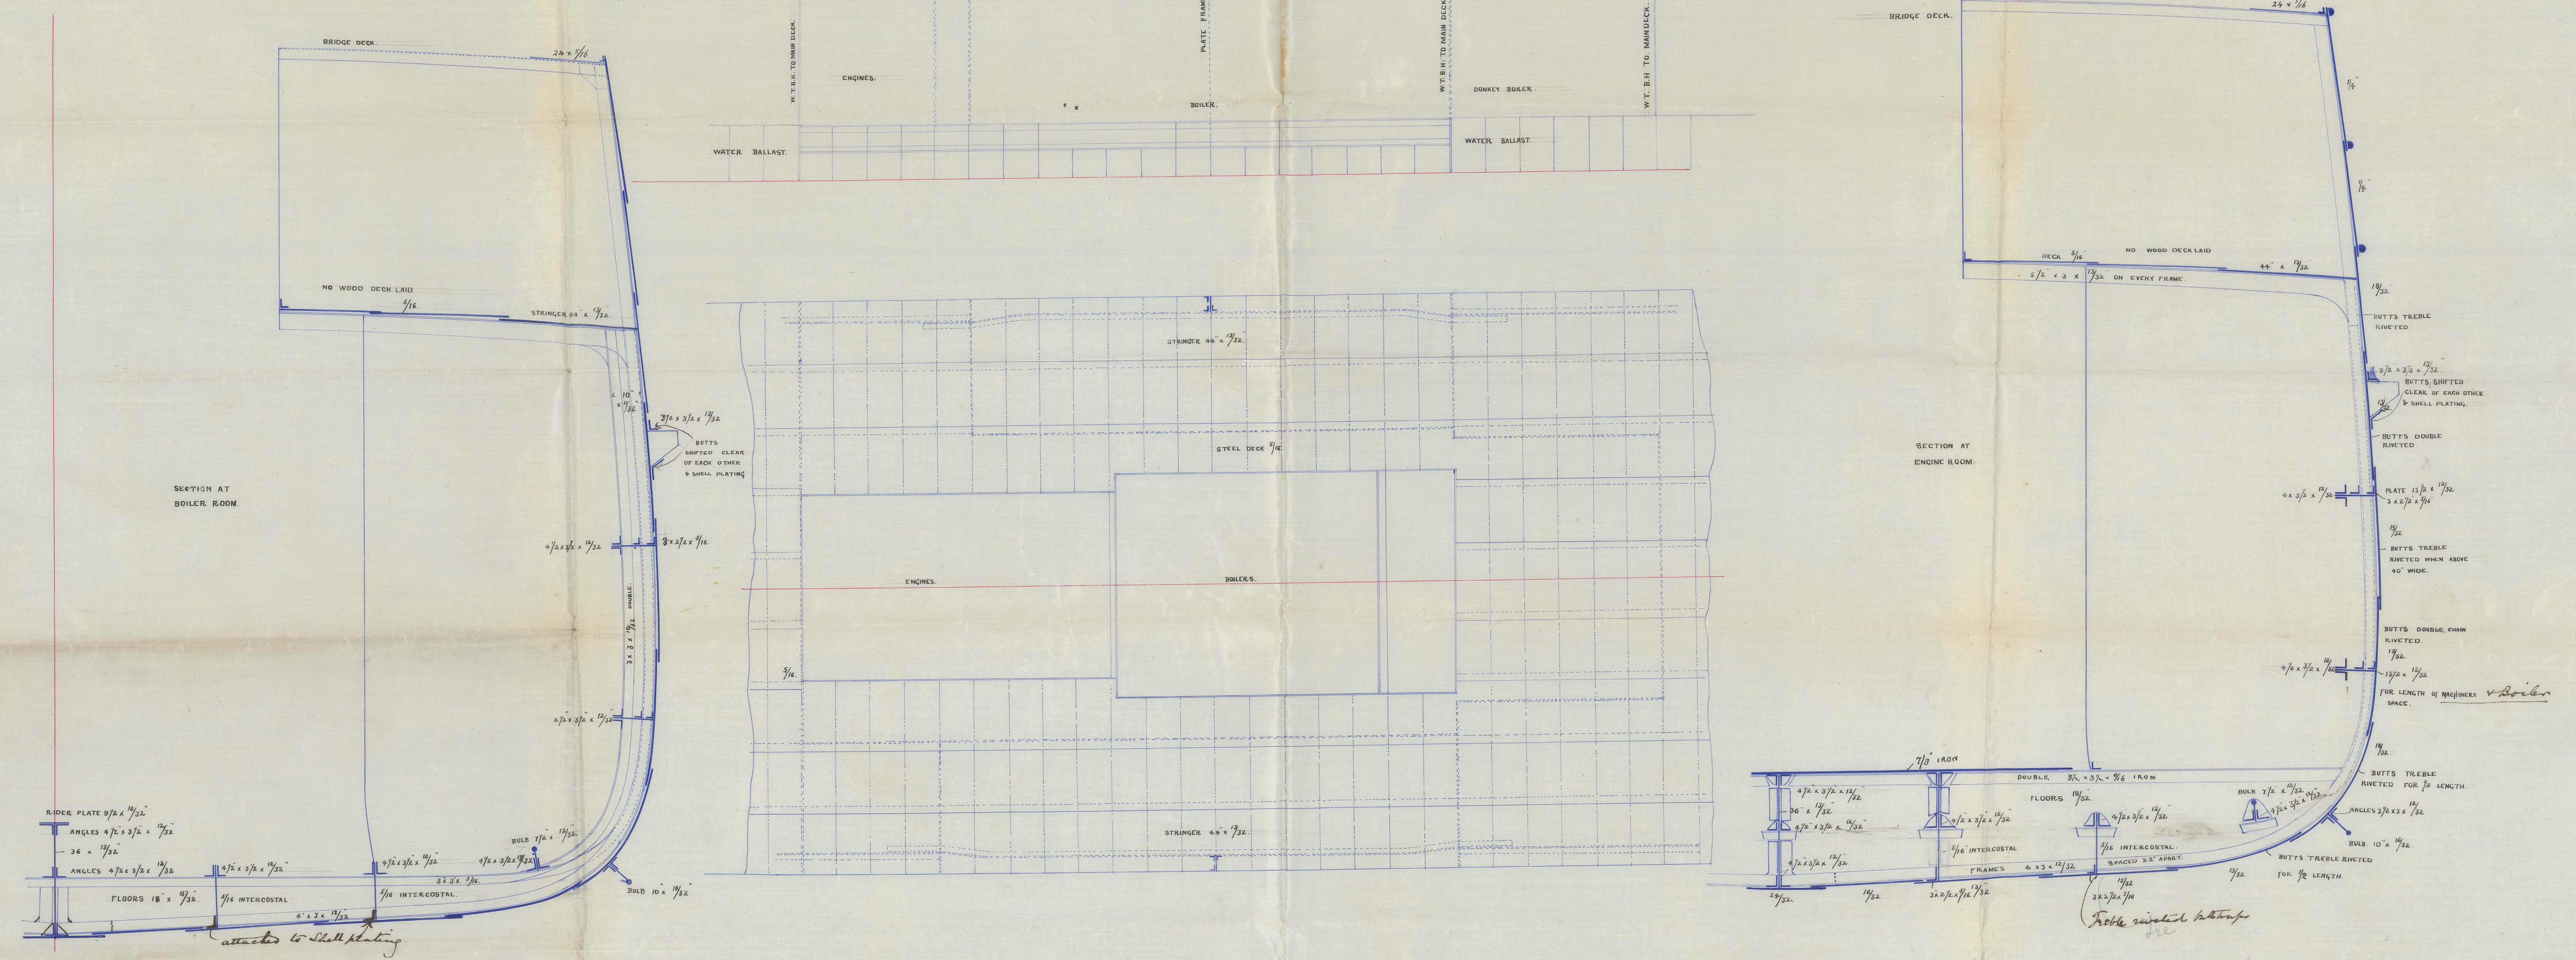

P. 22/2/84

GLS200-0215