



Mr. to Hls
11/3/84

S.S. Chau "Glasgow Report No. 6436.
S.S. "Taupo" do " 64874

PUMPING ARRANGEMENT

N^o 284-5

SCALE $\frac{1}{8}$ " = 1 FOOT.

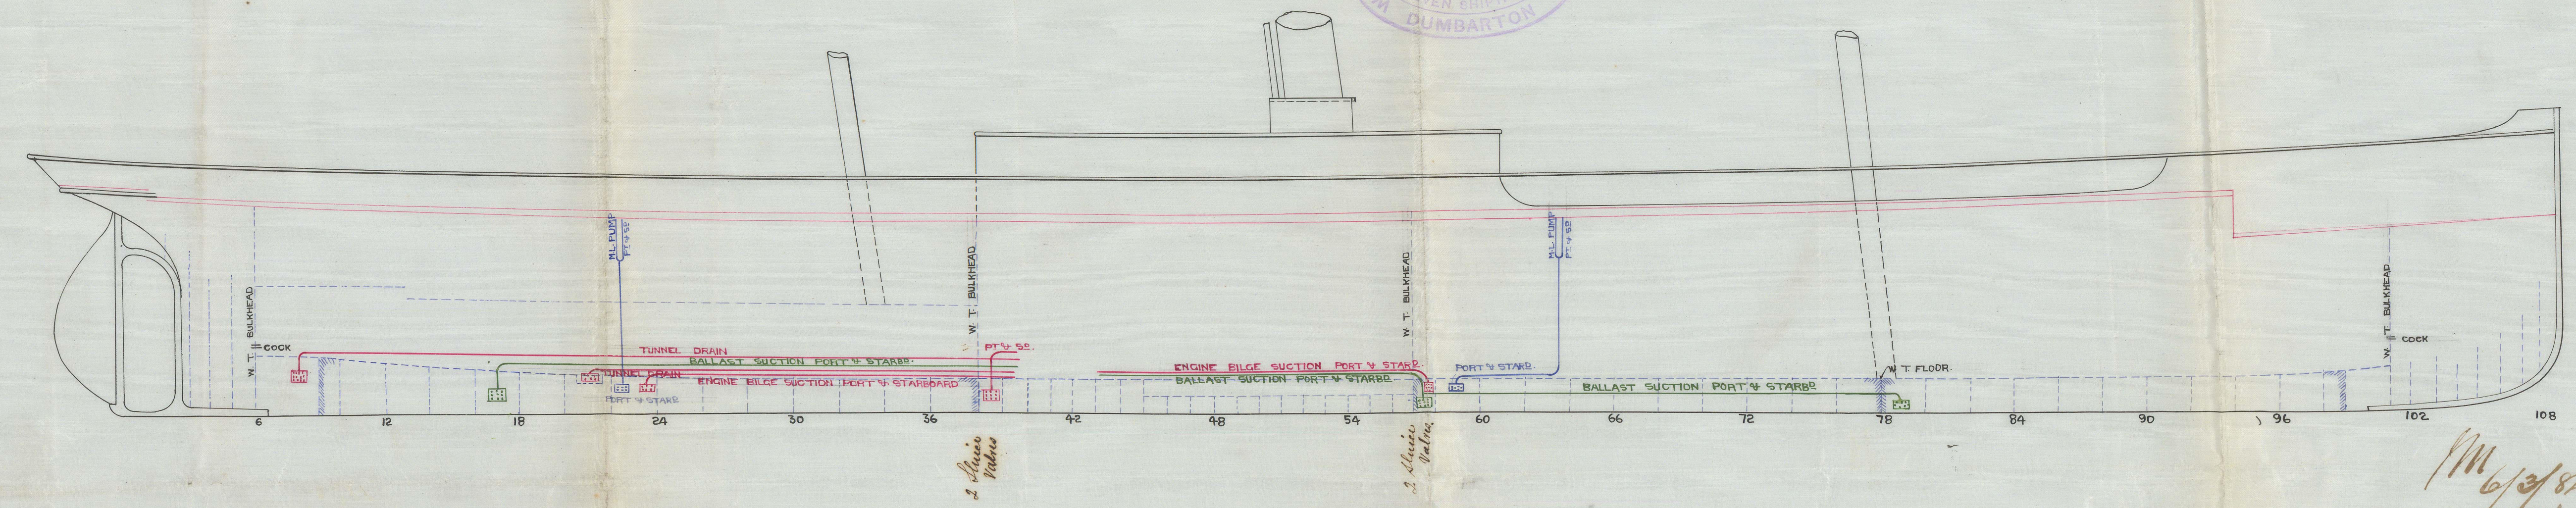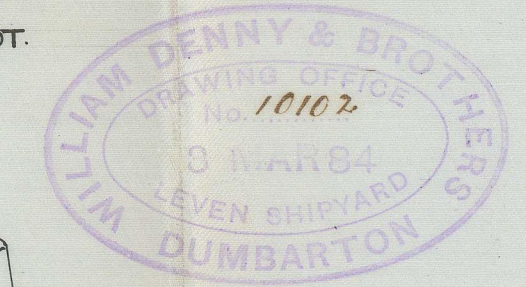

M 6/3/84
W.P.
7/3/84

GLS200-0218