


3 AUG 83
LONDON

COPY DRAWING
No 1033

C. L. Carthaginian Glasgow Report No 6485

Sh. 585.
16/8/83

MIDSHIP SECTION

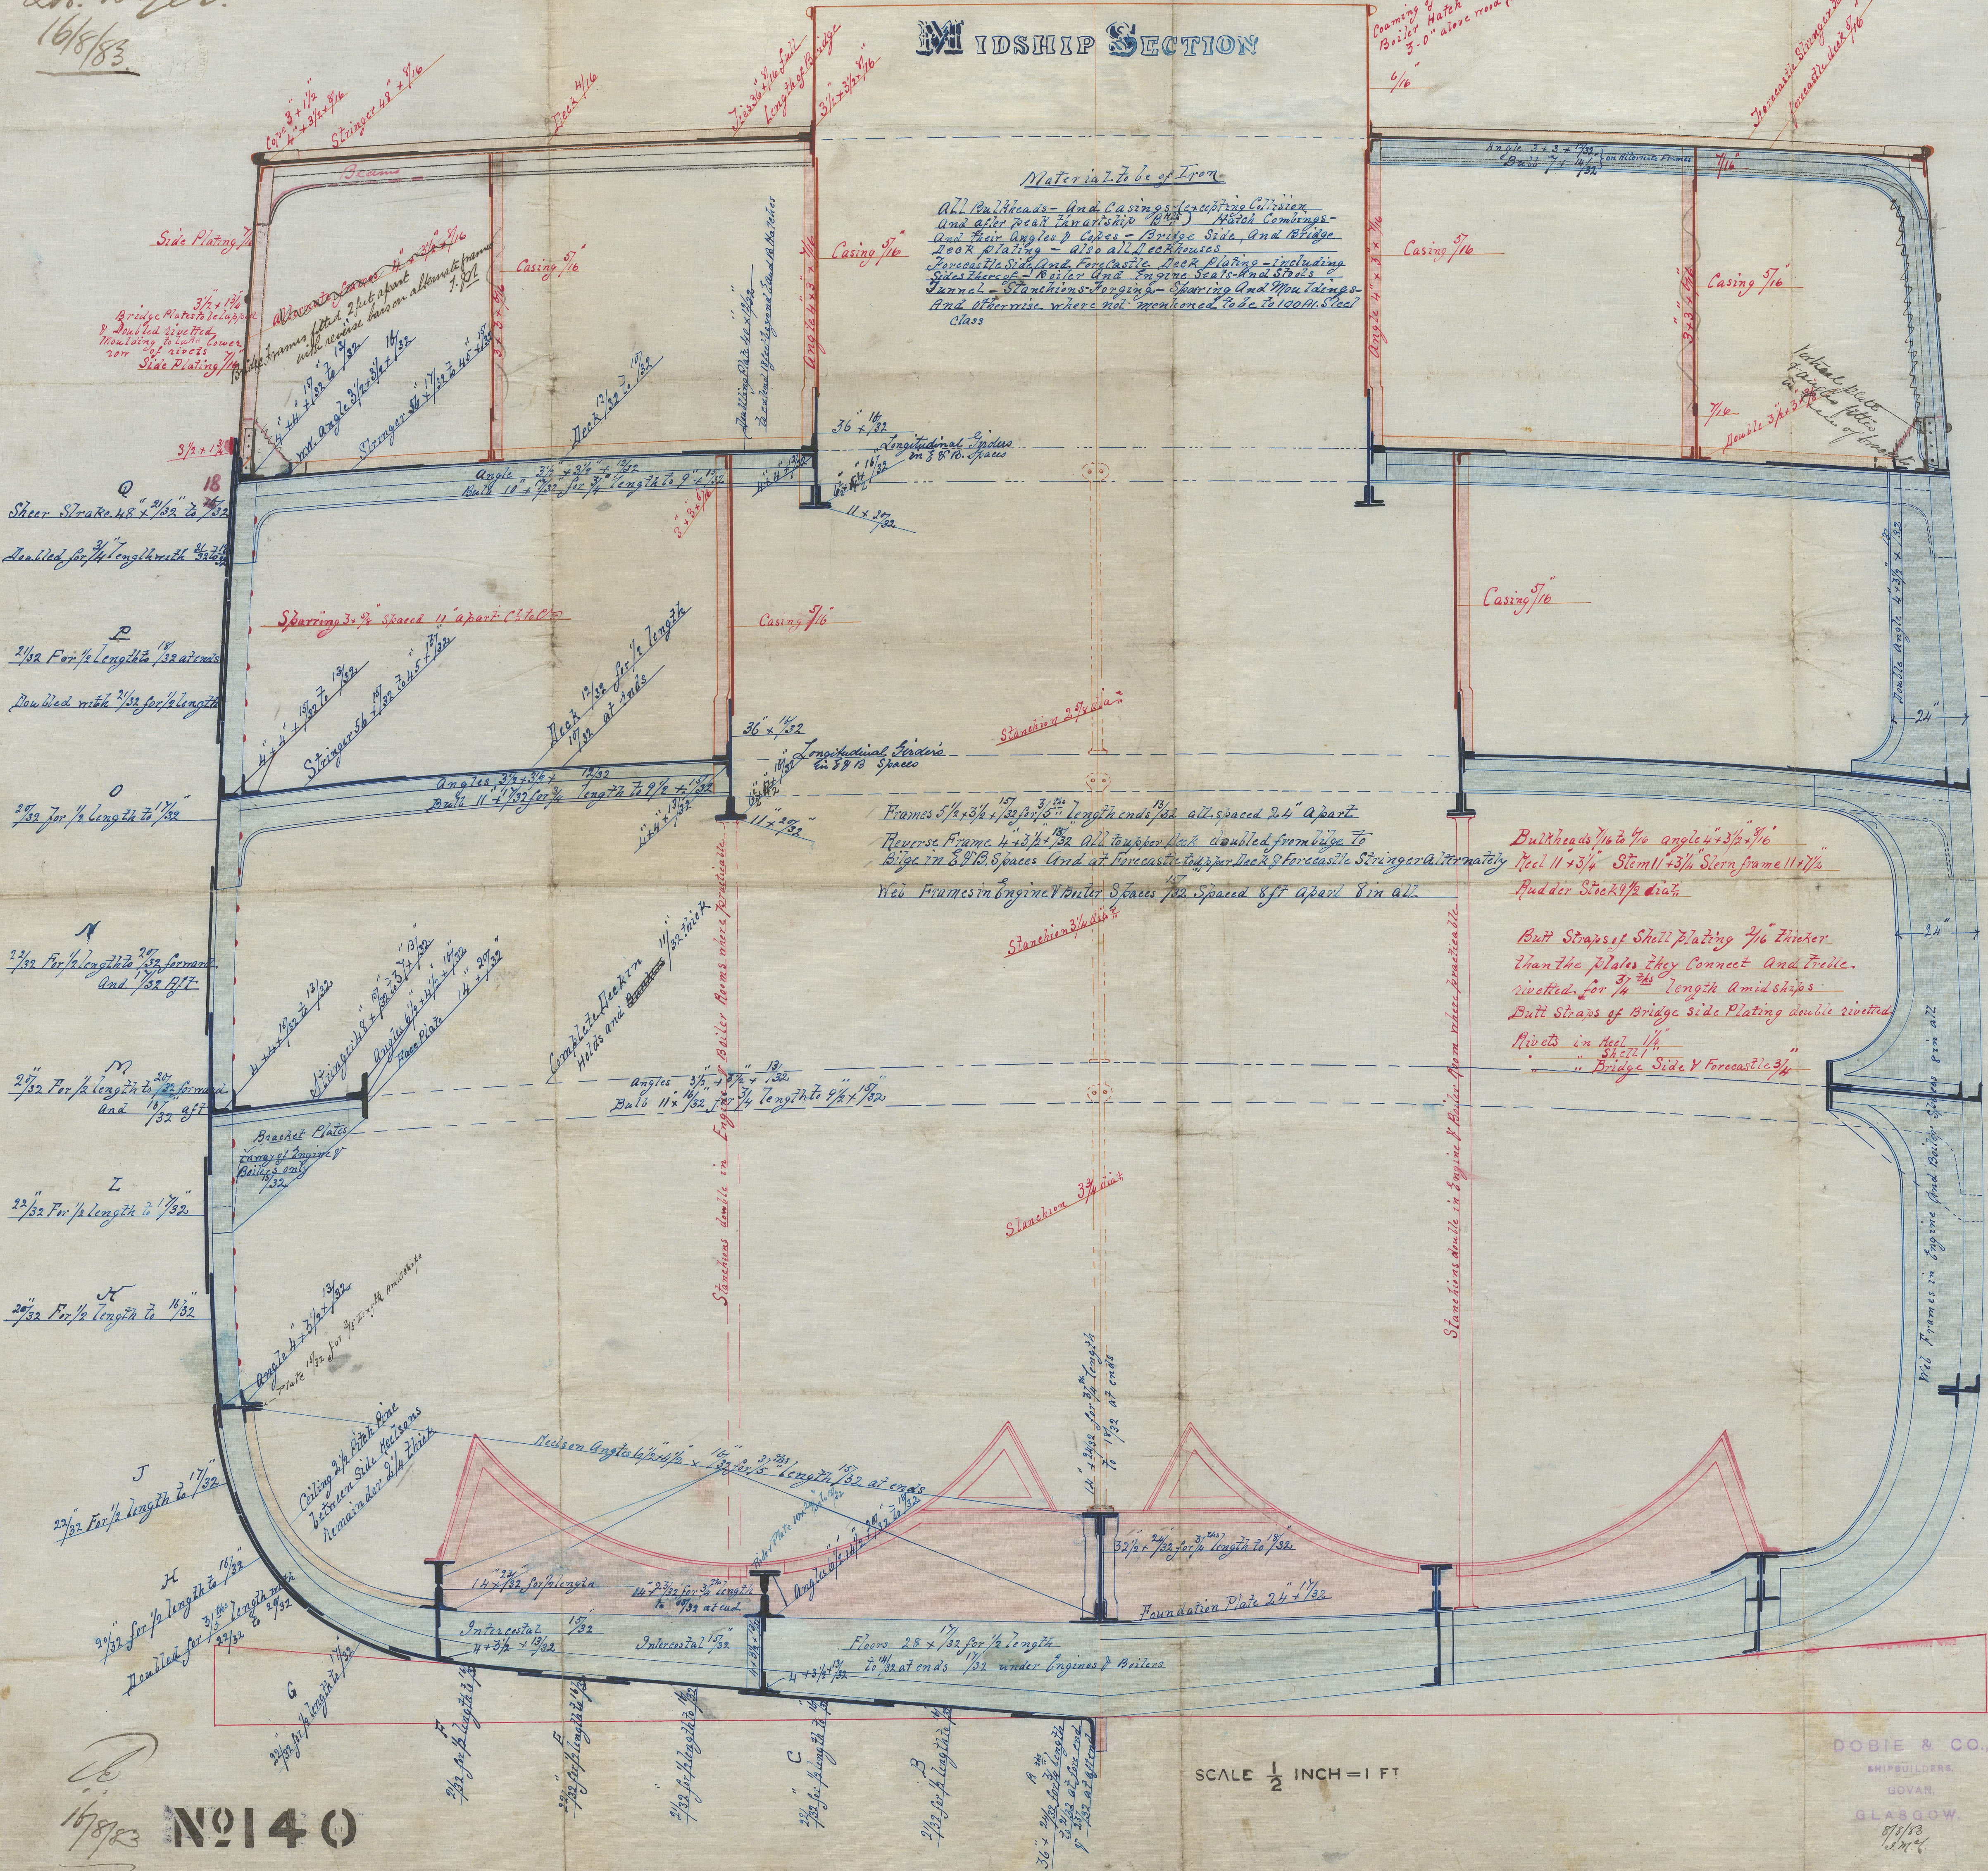

Material to be of Iron
All Bulkheads - and Casings - including Waisies -
and after peak transverse bulkheads - Hatch Comings -
and their angles & Copes - Bridge Side, and Bridge
Deck plating - also all cofferdams
Forecastle Side and Forecastle Deck Plating - including
Sides of - Boiler and Engine Seats and Stairs &
Tunnel - Stanchions for girders - Spacing and Mountings -
And otherwise where not mentioned to be of iron or steel
Class

Half Girth = 49.1	Dimensions as per Rule
Area = 22.5	
Depth = 31.78	384.16 x 45 x 31.78
103.38	
7	
96.88 = 1st Numerical	
384.16	
578.28	
96.38	
385.52	
771.04	
2891.4	
37025.3408 = 2nd Numerical	

Depth to length to upper deck = 12.08
" " " " Middle Deck = 15.98
Breadth to length = 9.57

Equipment Numerals
103.88
384.16
62.028
103.38
413.52
827.04
310.14
397.14.4608
+ 1/10 = 397.1
43685 = Equipment Numerals

SCALE 1/2 INCH = 1 FT

DOBIE & CO.,
SHIPBUILDERS,
GOVAN,
GLASGOW.