


13 AUG 23
COPY DRAWING
No 1035


Dr. L. G. G.
16/8/03.

Upper Deck Plan

S. S. "Carthagenia" Glasgow Report No 6485

 

Middle Deck Plan

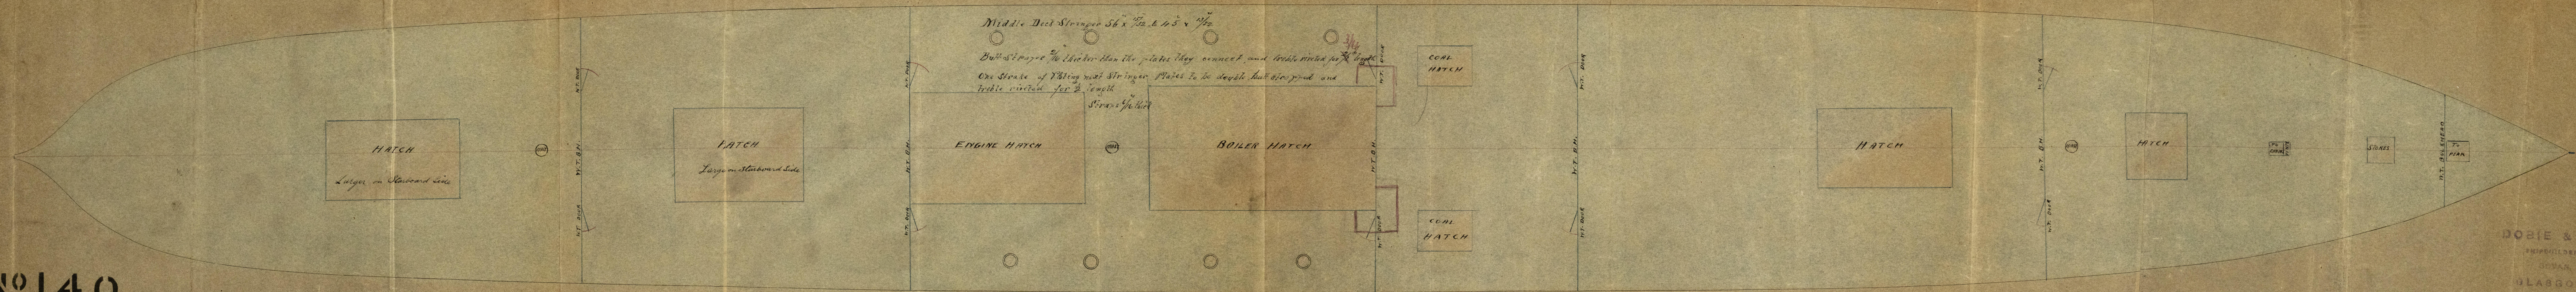

SCALE 1/8" INCH = 1 FT

No 140

DOBIE & CO.
SHIPBUILDERS
GLASGOW