

Lloyd's Register of British and Foreign Shipping.

(Report on Vessel No. 6490 Port Glasgow)

No. 84.a.

SHIP FORGINGS OR CASTINGS.

I have to report that the undermentioned Iron or ~~Steel~~ Forgings or Castings, manufactured by The Darlington Forge Co of Darlington for the Vessel No. 256, being built by Capt. A Mc Millan Sons of Dumbarton have been inspected by me as set forth below, and found to be, so far as can be seen, sound.

The words FORGINGS or CASTINGS, IRON or STEEL, should be struck out as may be required.


Mark on Forgings.

Lloyd's
No. 84.a.
H.C.

H. CAMERON.
Sunderland

	STERN FRAME.	RUDDER FRAME.	STEM.
Material* - - - -	<u>Scrap Iron</u>	<u>Scrap Iron</u>	
How made - - - -	<u>Forged</u>	<u>Forged</u>	
Dimensions - - - -	<u>6" x 3 1/2"</u>	<u>3 3/4" x 2 1/4"</u>	
Progress on Inspection -	<u>Forged & Smithed</u>	<u>Forged & Smithed</u>	<u>Not seen</u>
Dates when Inspected	<u>May 14. 24. 28 June 14. 7/84</u>	<u>May 28 June 14. 7. 11. 16. 19. 26/84</u>	

SKETCHES OF FRAMES SHEWING POSITION AND DESCRIPTION OF WELDS OF FORGINGS, OR PARTICULARS OF TESTS APPLIED TO CASTINGS.

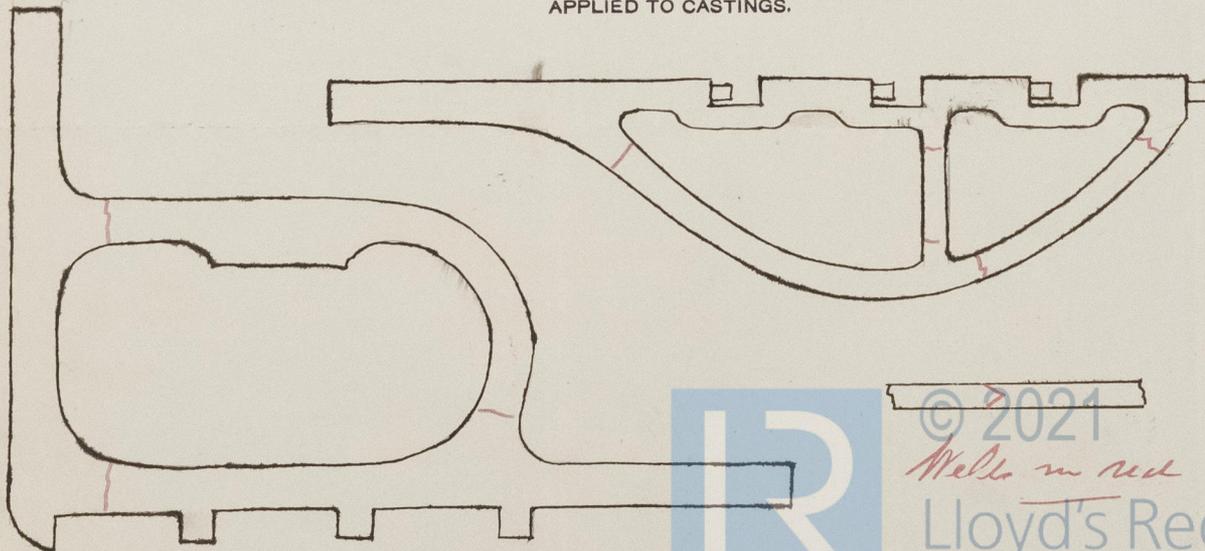

© 2021
Welds in red

Lloyd's Register
Foundation

* If of Iron, state whether scrap or puddled Iron.