


S. S. Glamorganshire  
C/o Dept No 6502.

DIMENSIONS 340'-0" x 40'-0" x 26'-6" TO FLOORS.

SCALE  $\frac{1}{2}$  INCH.

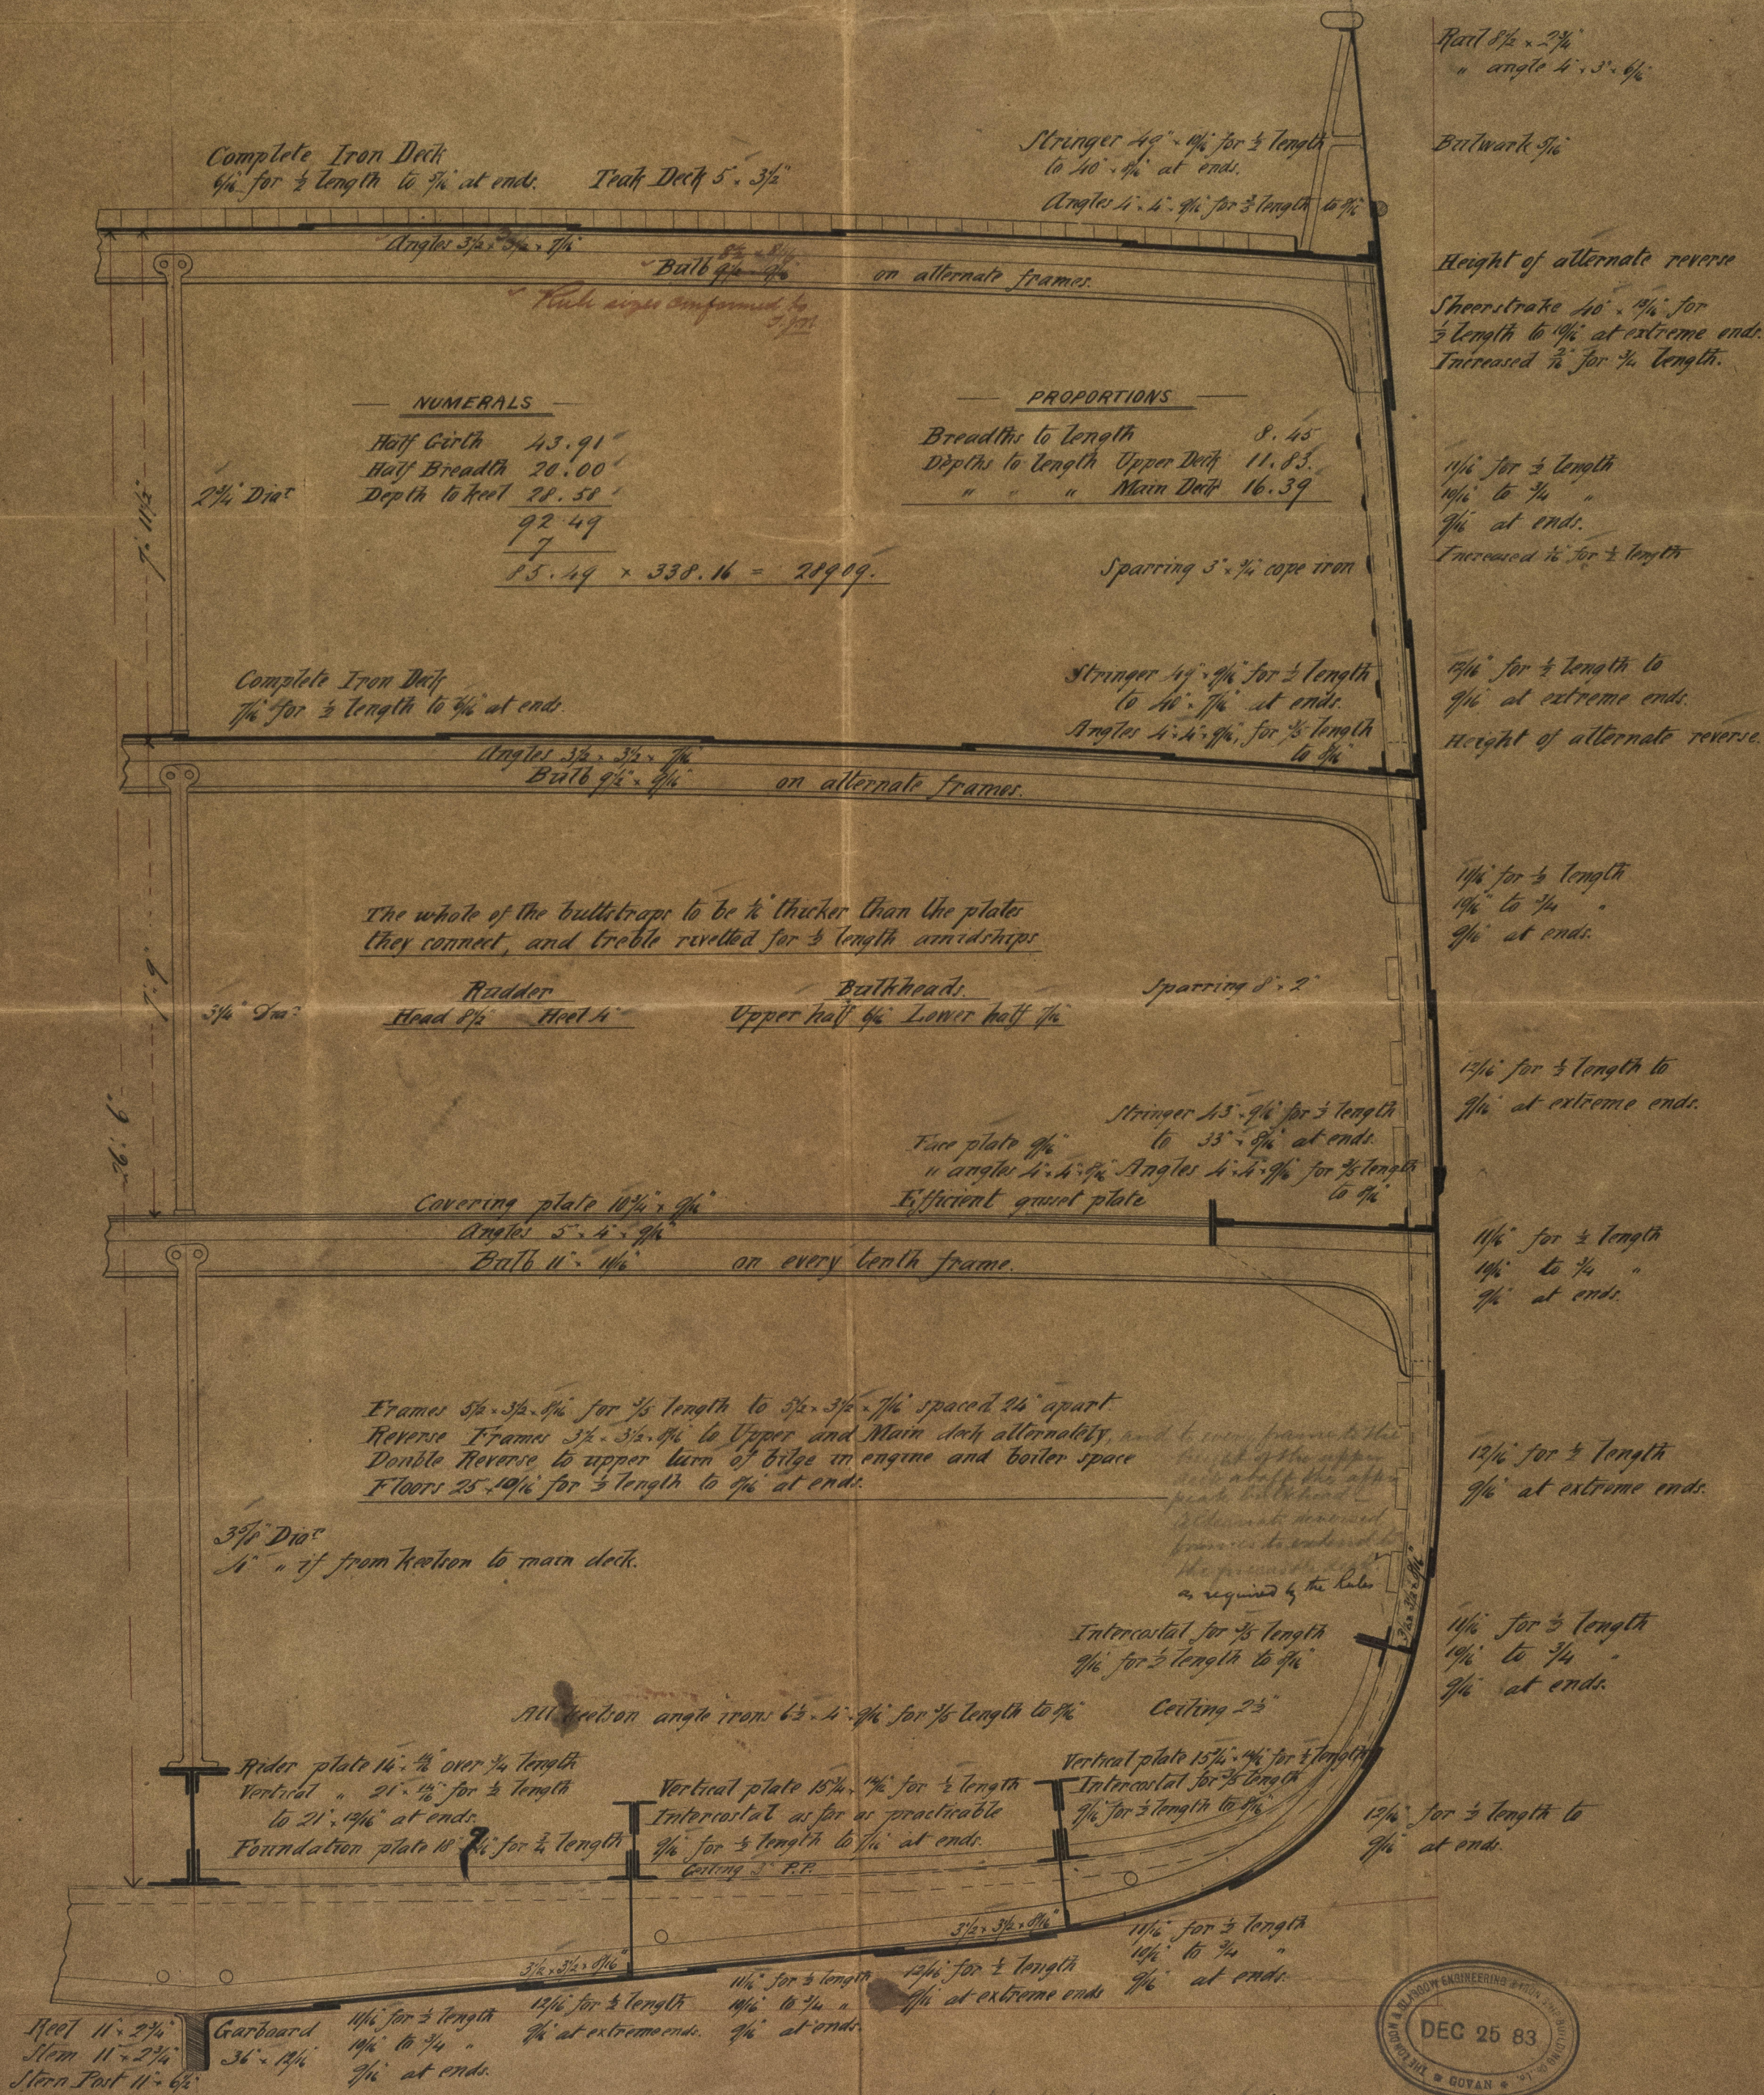


Register N<sup>o</sup> 7440

Mr W. Hanson

28/12/83