

# Lloyd's Register of British and Foreign Shipping.

(Report on Vessel No. 6803 Port Glasgow)

No. 602

## SHIP FORGINGS OR CASTINGS.

I have to report that the undermentioned ~~Iron or~~ Steel Forgings ~~or Castings~~, manufactured by The Dennytown Forge Co of Dunbarton for the Vessel No. 283, being built by Messrs Wm Denny Bros & Co of Dunbarton have been inspected by me as set forth below, and found to be, so far as can be seen, sound and efficient

The words FORGINGS or CASTINGS, IRON or STEEL, should be struck out as may be required.

Mark on Forgings.


Lloyd's  
No. 602  
G.N.

George Newcomb  
Glasgow

29/2/84.

	STERN FRAME.	RUDDER FRAME.	STEM.
Material*	<u>Siemens Martin scrap steel</u>		
How made	<u>Forged</u>		
Dimensions	<u>12 x 8</u>		
Progress on Inspection	<u>Forged and smithed</u>		
Dates when Inspected	<u>20.26/11/83. 5.20.22.27/12/83.</u> <u>15.22.25/1/84. 1.5.8.19.26.28/2/84.</u>		

SKETCHES OF FRAMES SHEWING POSITION AND DESCRIPTION OF WELDS OF FORGINGS, OR PARTICULARS OF TESTS APPLIED TO CASTINGS.

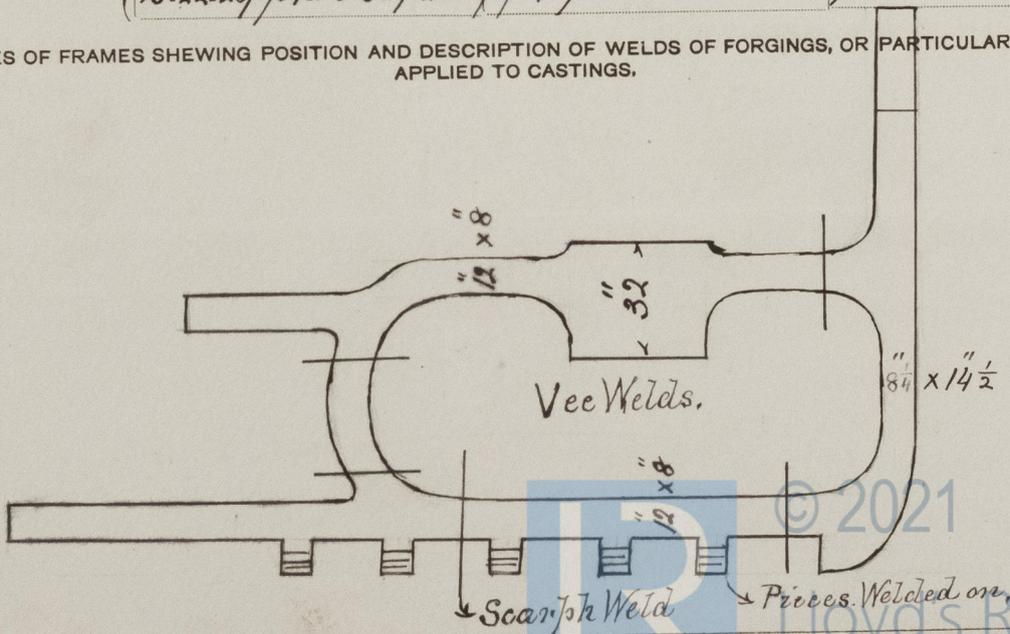

\* If of Iron, state whether scrap or puddled iron.