

23 JAN 84

Dr. D. G. S.
30/1/84

ARRANGEMENT OF STRENGTHENING IN MACHINERY SPACE
S. S. N° 282-3


SCALE 1/8" = 1 FOOT

WILLIAM DENNY & BROTHERS
DRAWING OFFICE
25 JAN 84
LEVEN ROAD


S. S. "Hera" "Chicago Report No. 6692"
do "do" 6803

NOTE: BEAMS SHOWN IN RED
ARE CORRECT.


CITADEL DECK

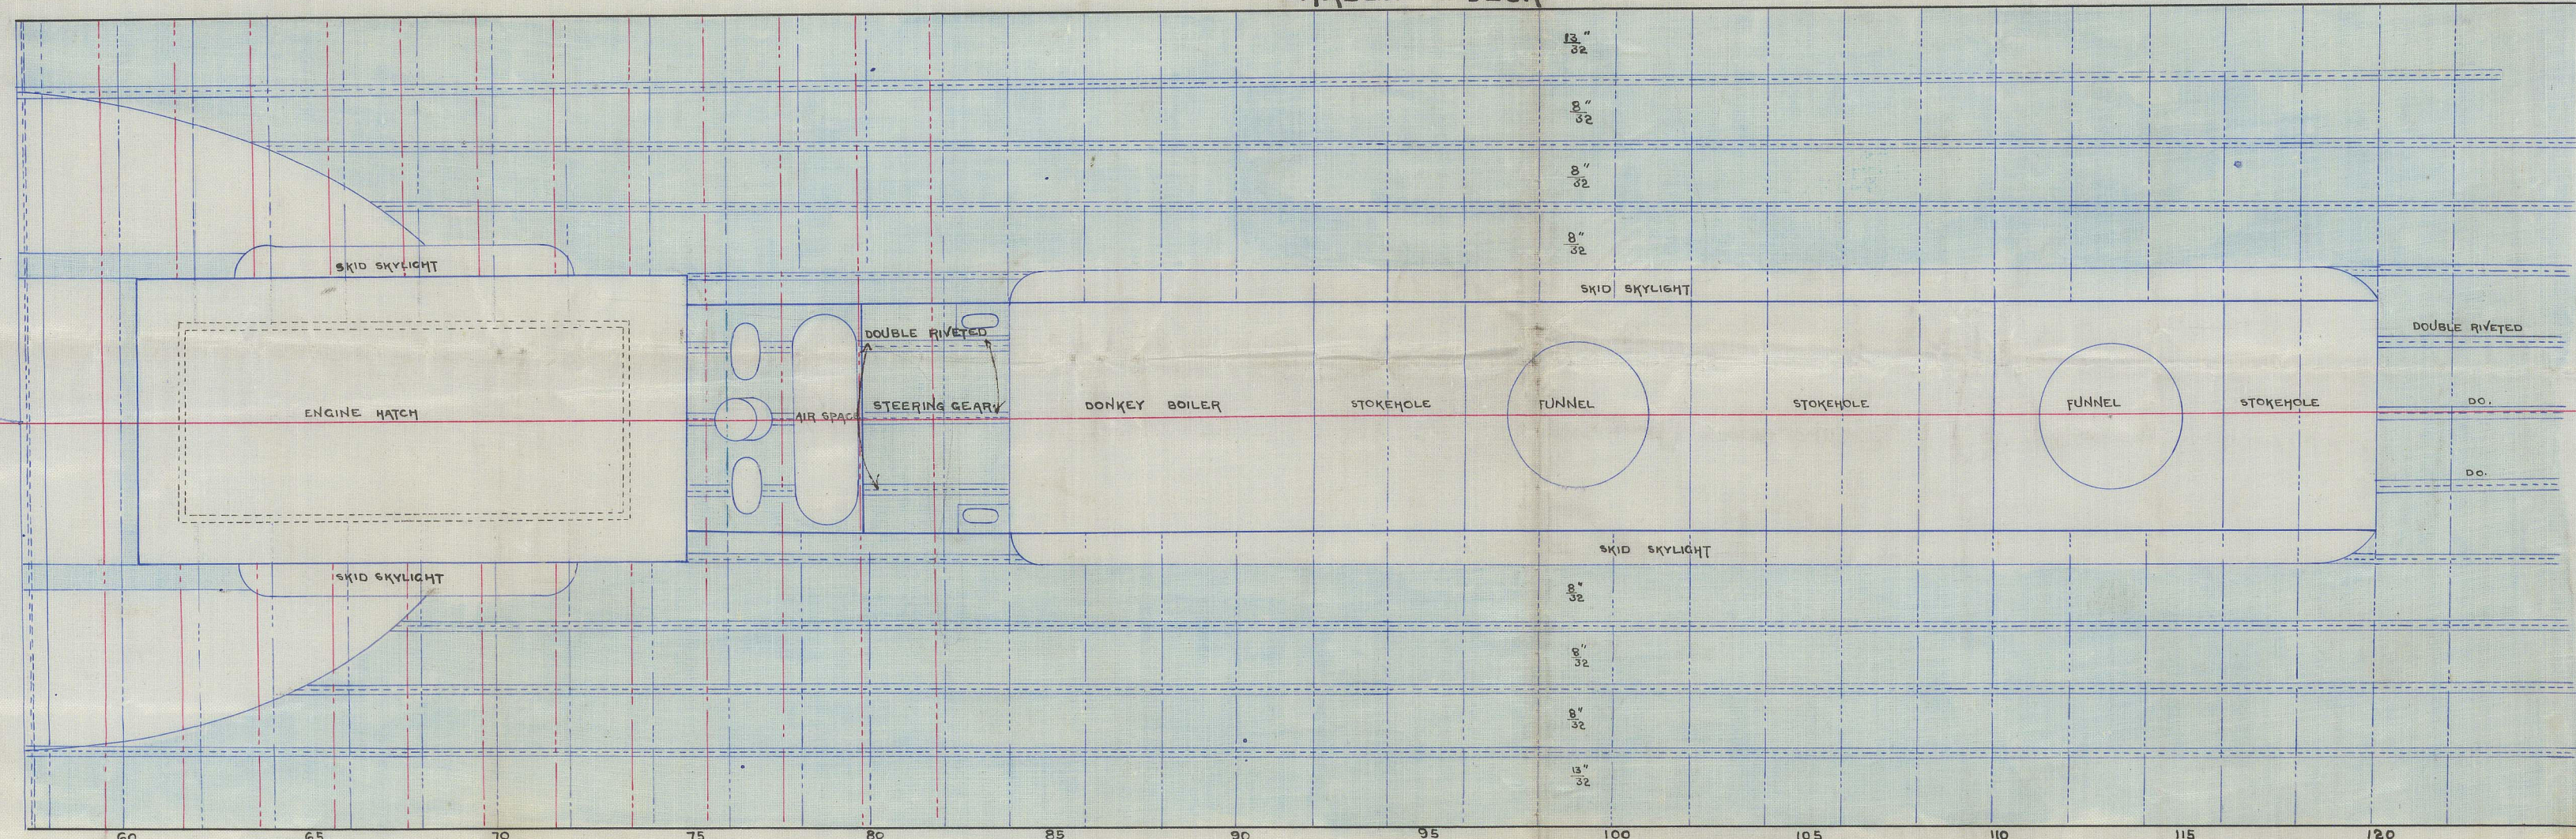


UPPER DECK

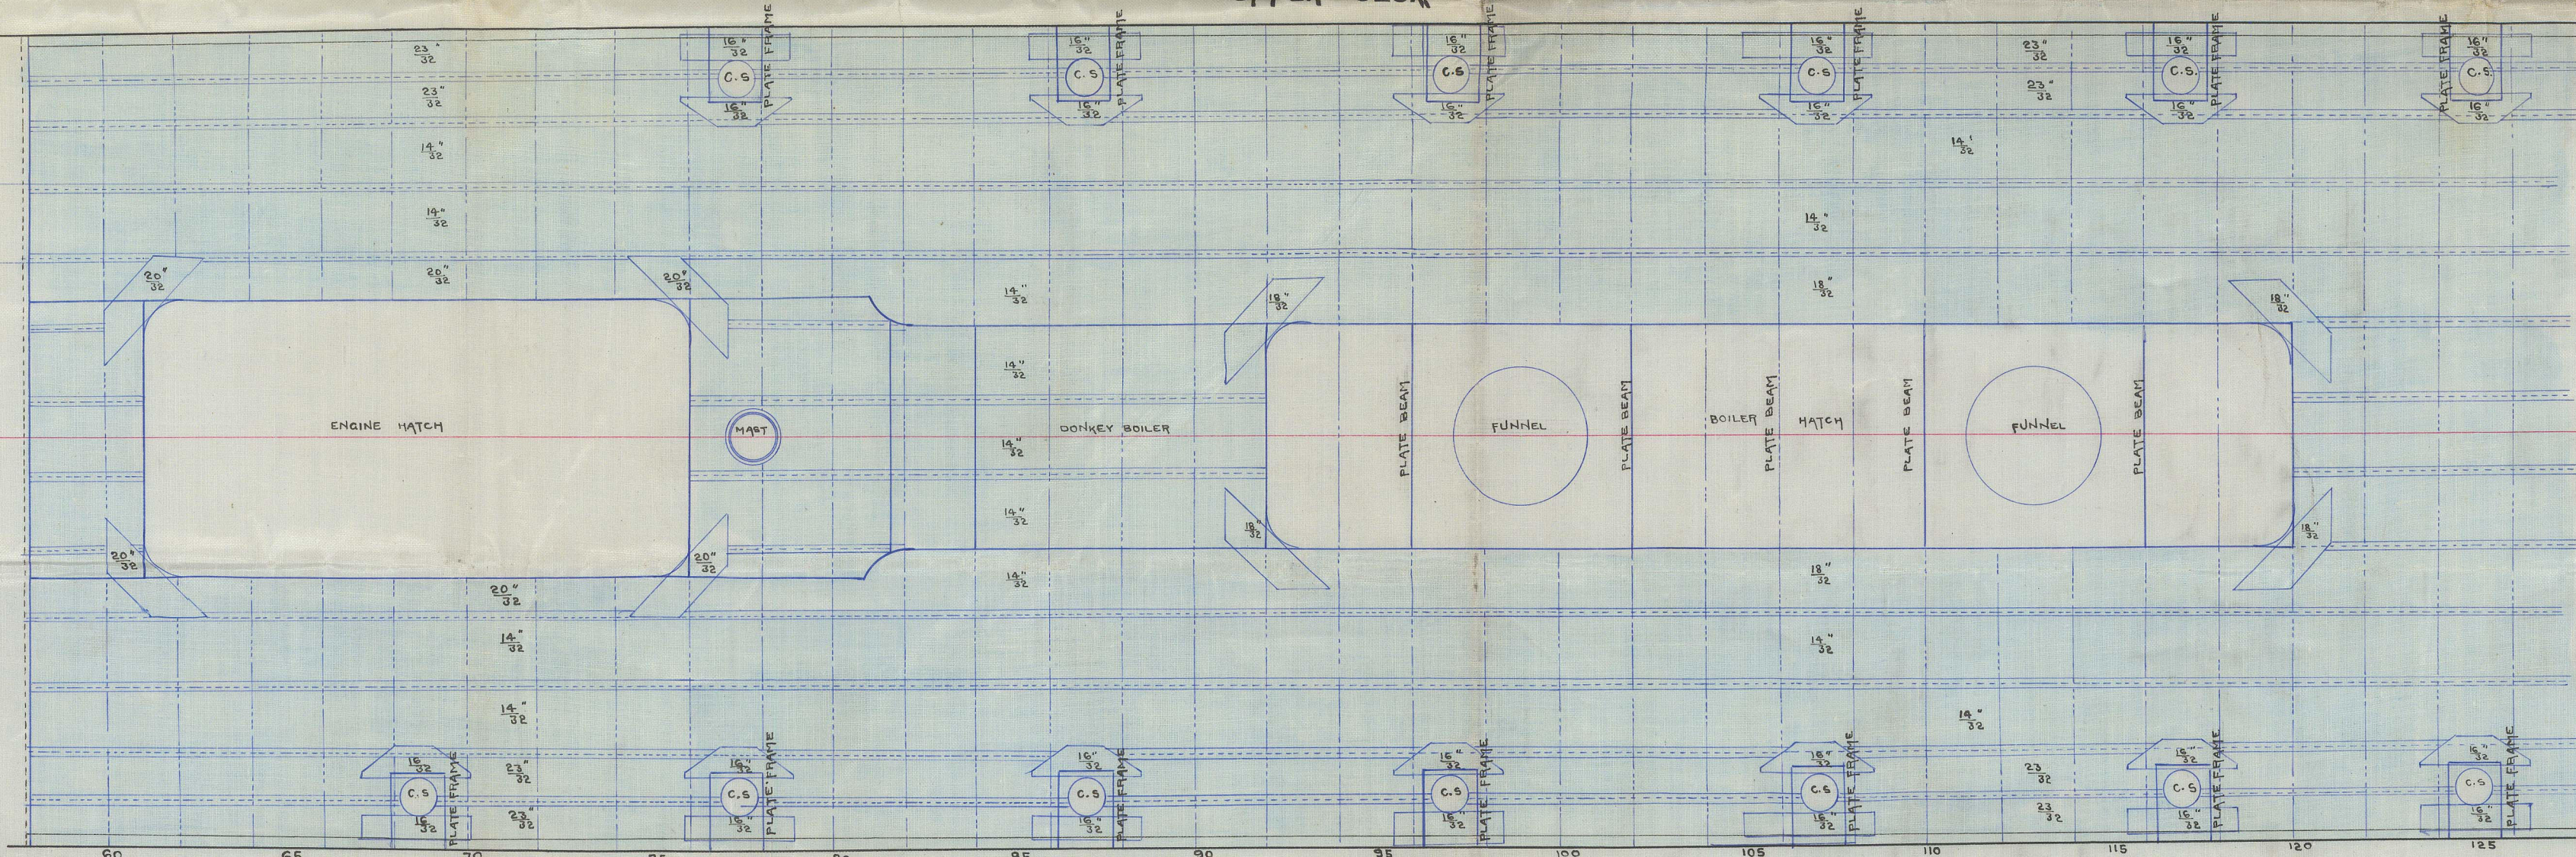


MAIN DECK

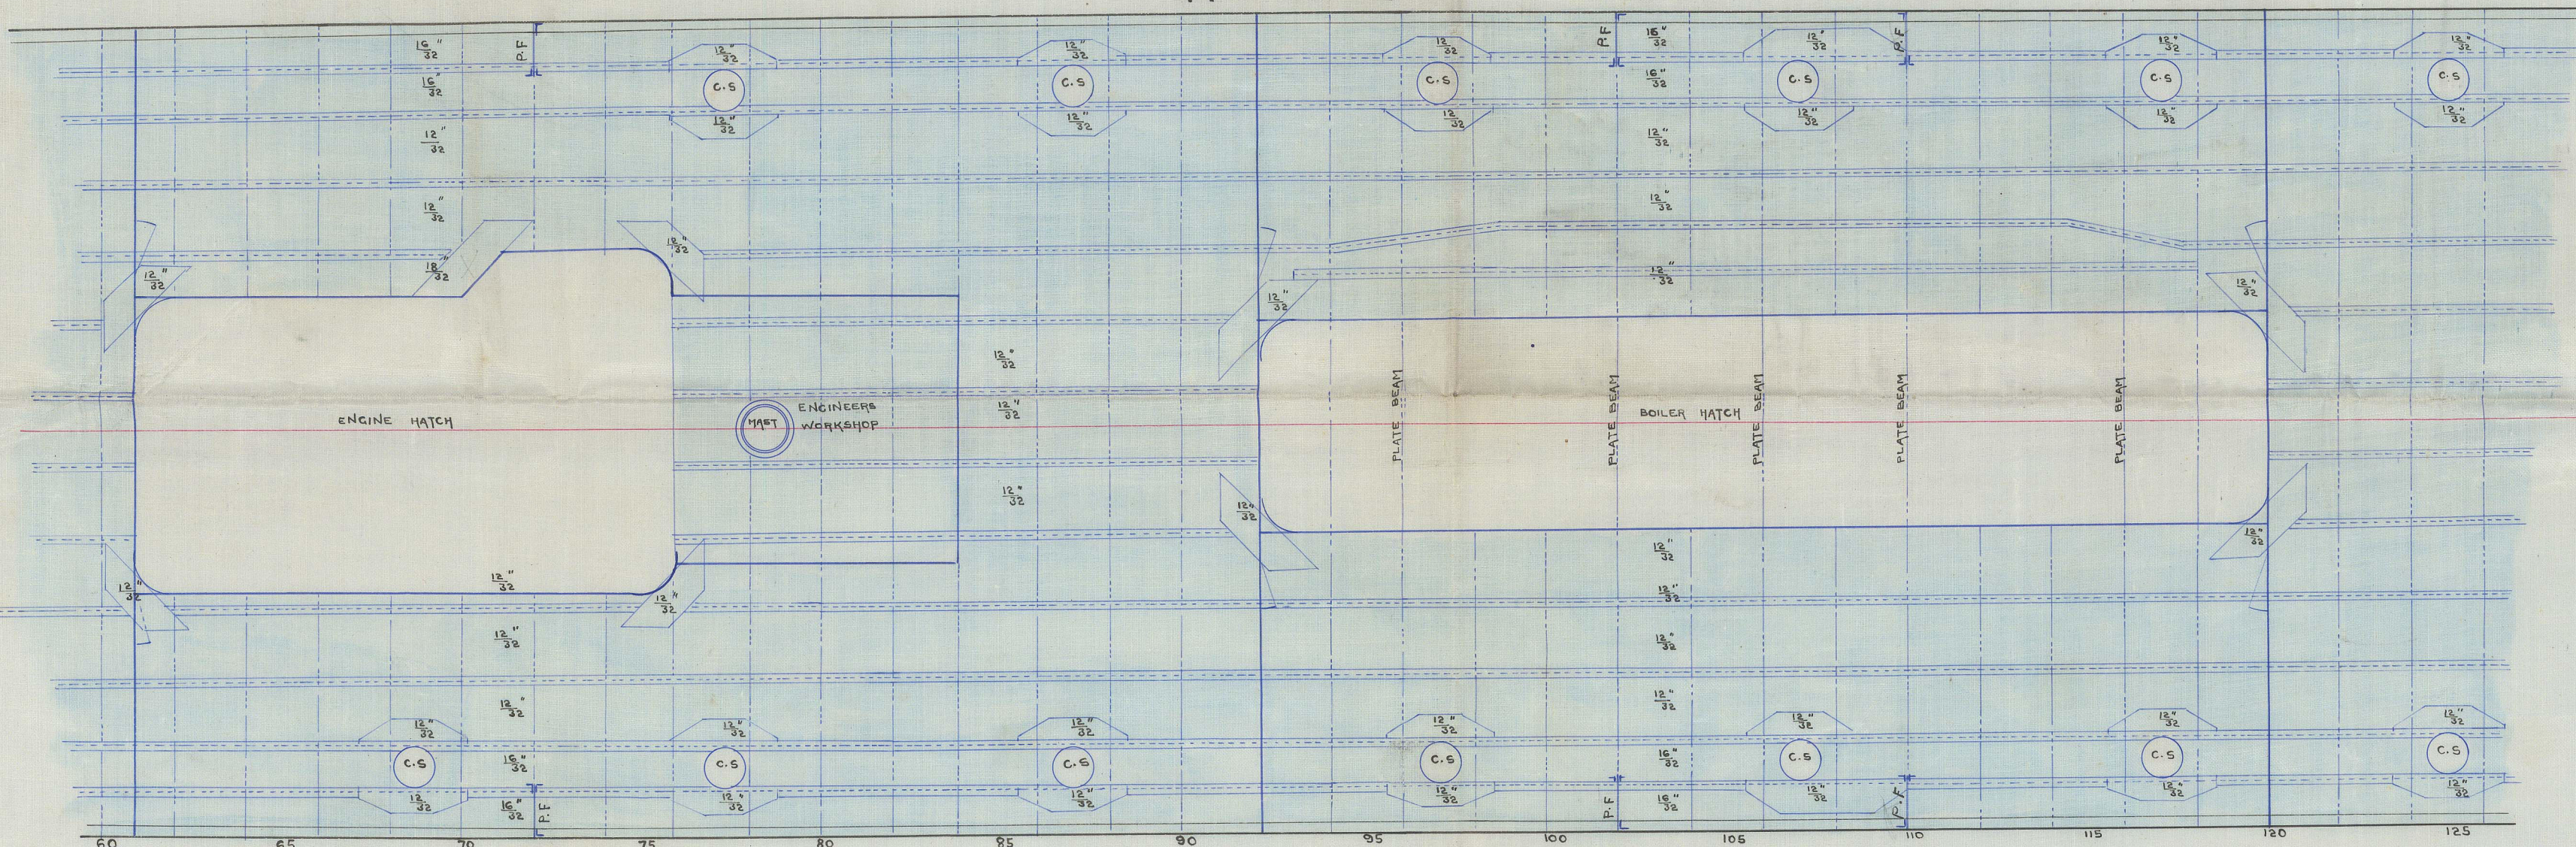

LOWER DECK

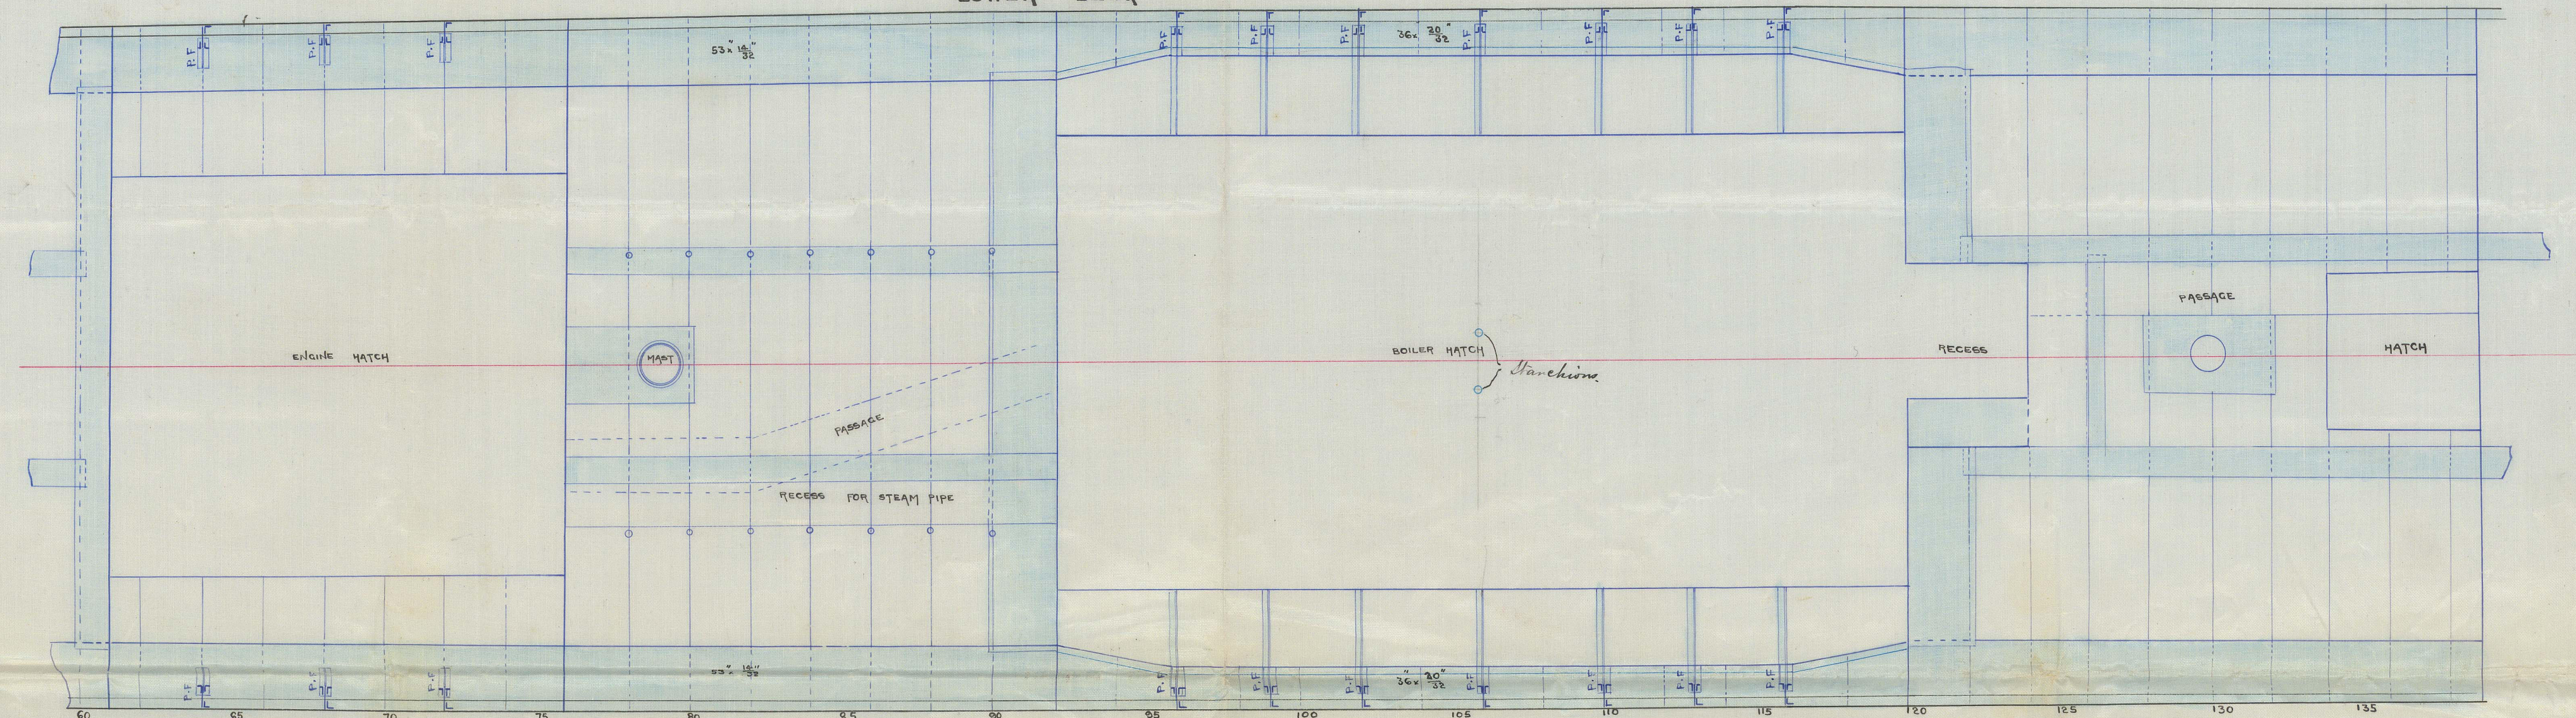

ELEVATION

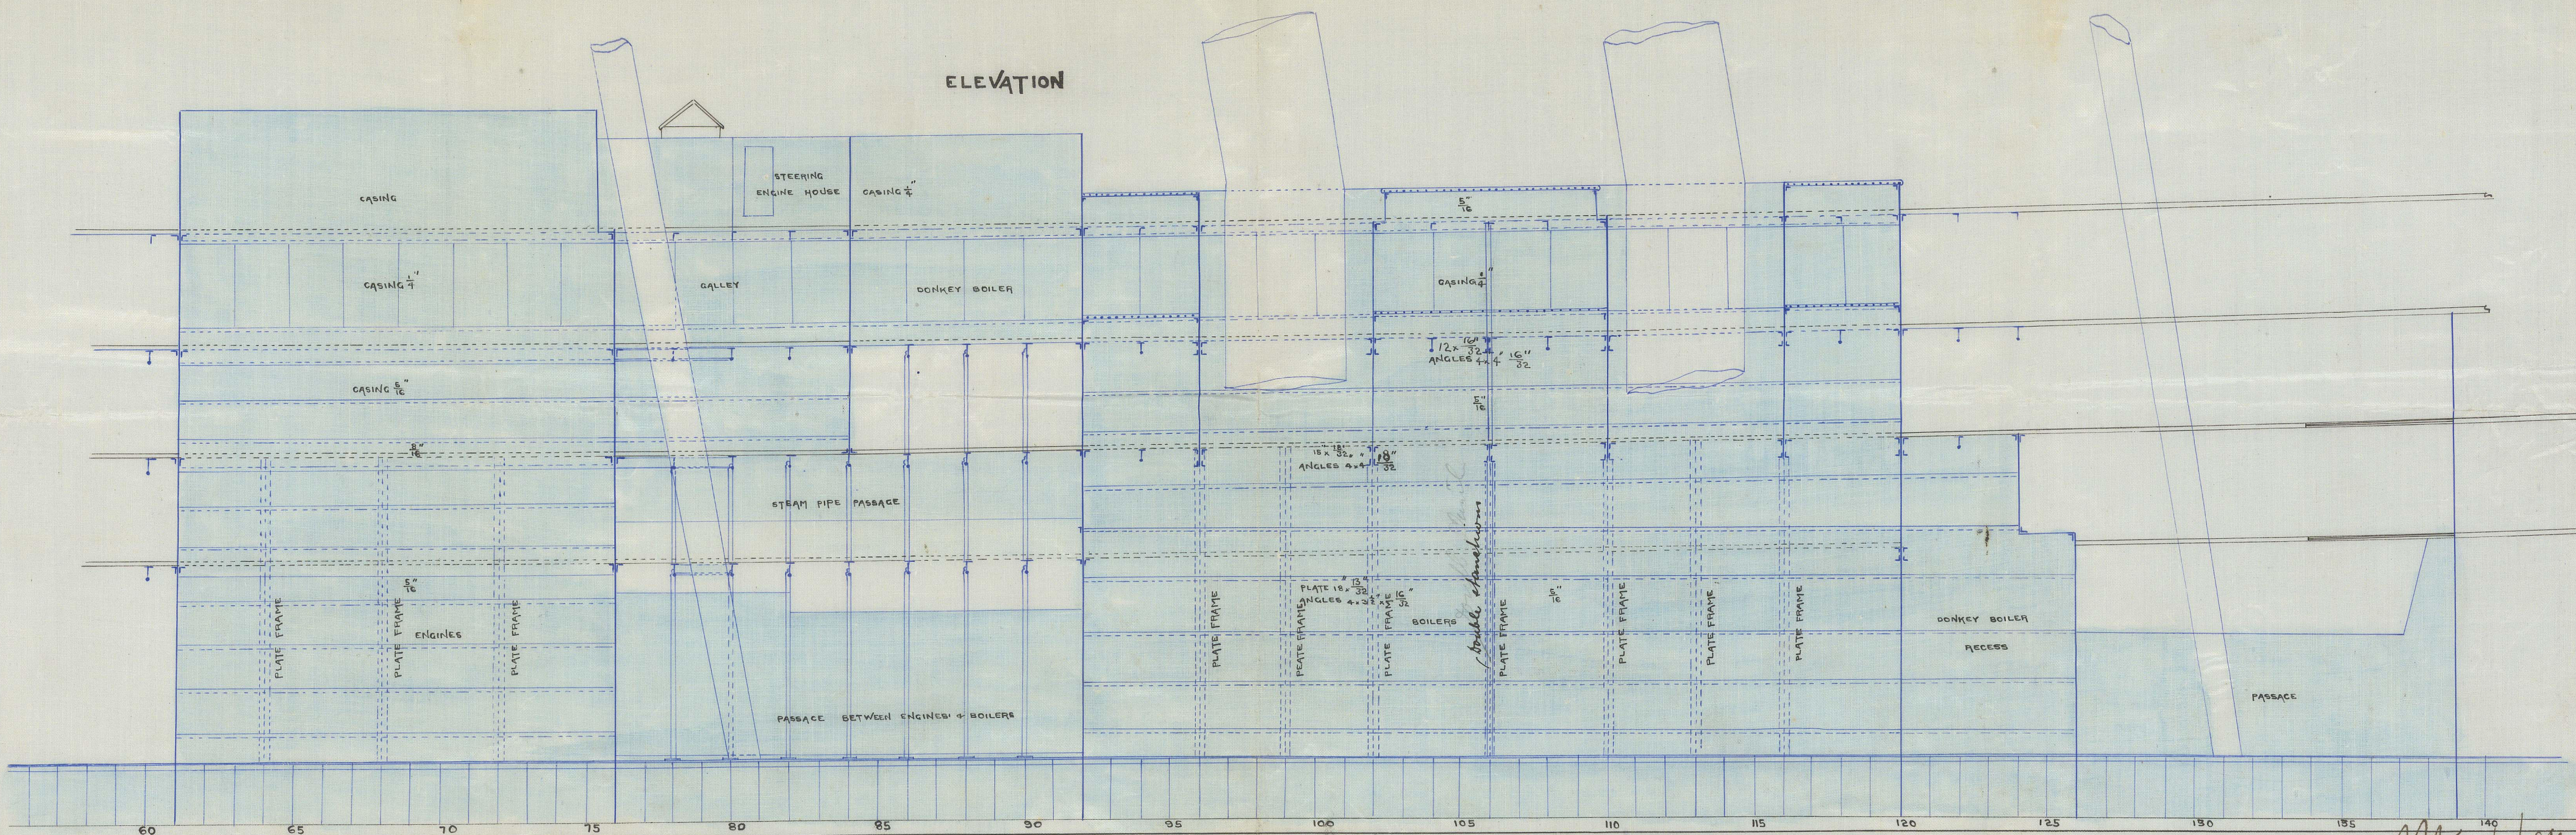

29/1/84