



10 SEP 83  
LONDON

# S. S. Tokio Maru Glasgow Report No. 6843.


Dr. S. G. S.  
13/9/83.

Sketch shewing arrangement of Engine Seat.  
Scale  $\frac{1}{4}$  inch = 1 ft.


## Profile & Deck Plans S.S. No. 26 Scale $\frac{1}{16}$ inch = 1 foot

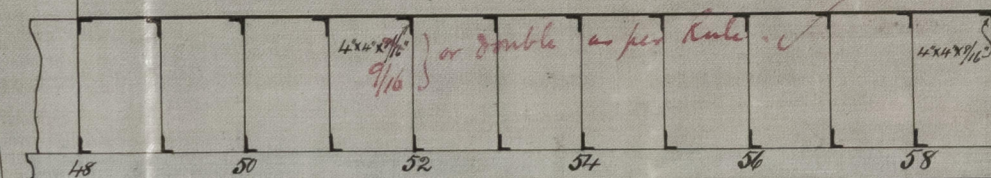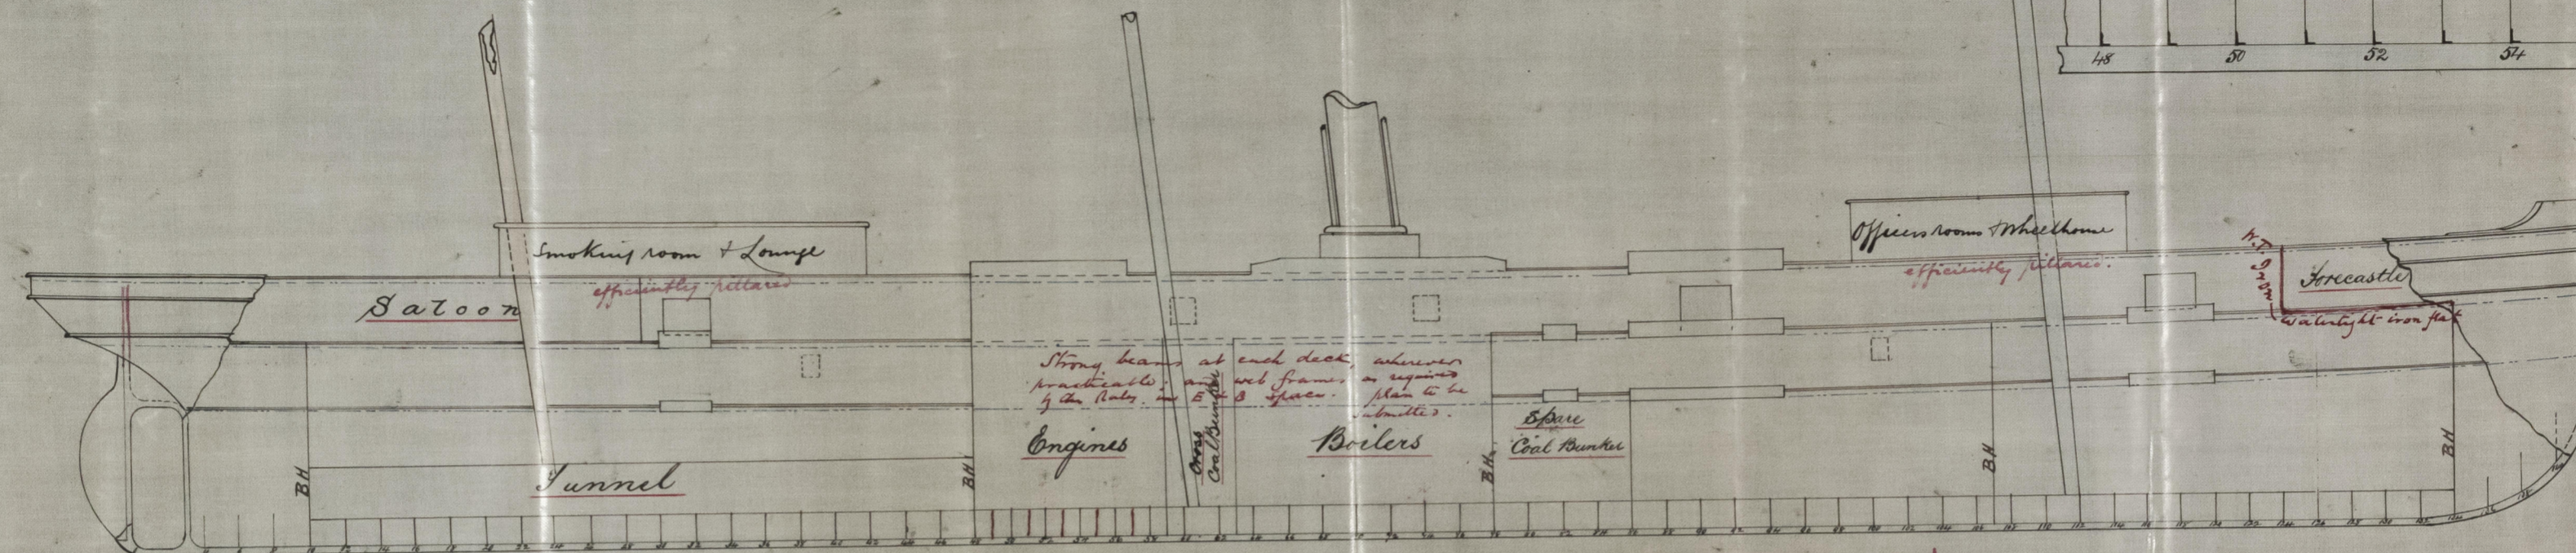

## Awning Deck

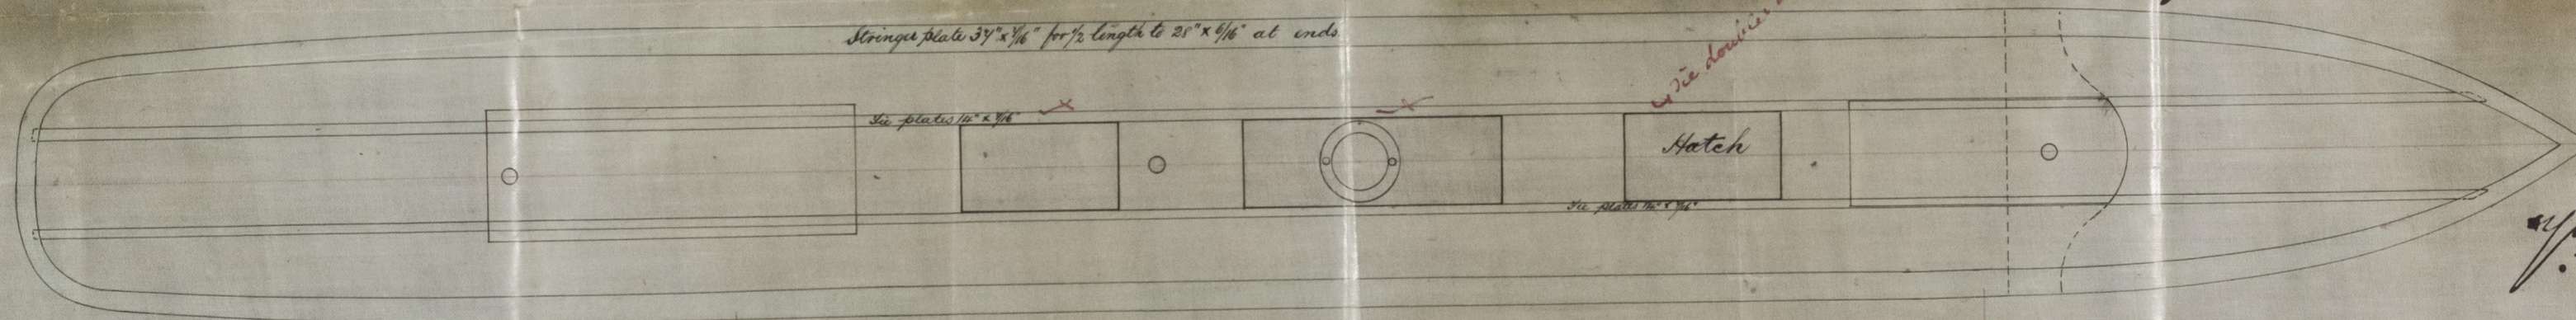

## $\frac{1}{2}$ Length Main Deck

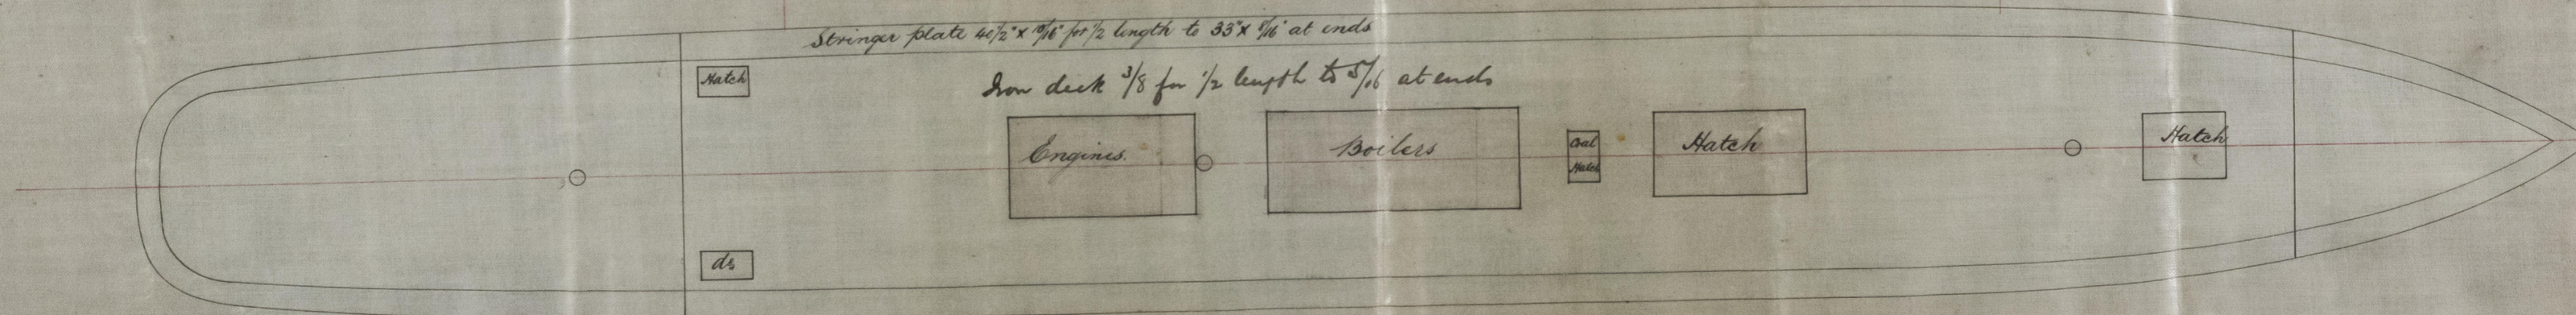

Napier Shanks & Bell  
Yoker

11/9/83

J. V. L.  
12/9/83



Glasgow C. 7. 8/9/83.  
© 2021

Lloyd's Register  
Foundation