


1677




Dr. to Geo.
7/4/84.

S.S. "Tokio Maru" Glasgow Report N^o 6843. —

S.S. N^o 26 *During Recked by Napier, Shank & Hill,
Joker, near Glasgow.*
Sketch showing Cargo & Coal Ports, Sidelights &c
on side of Ship
Scale $\frac{1}{2}$ inch = 1 foot

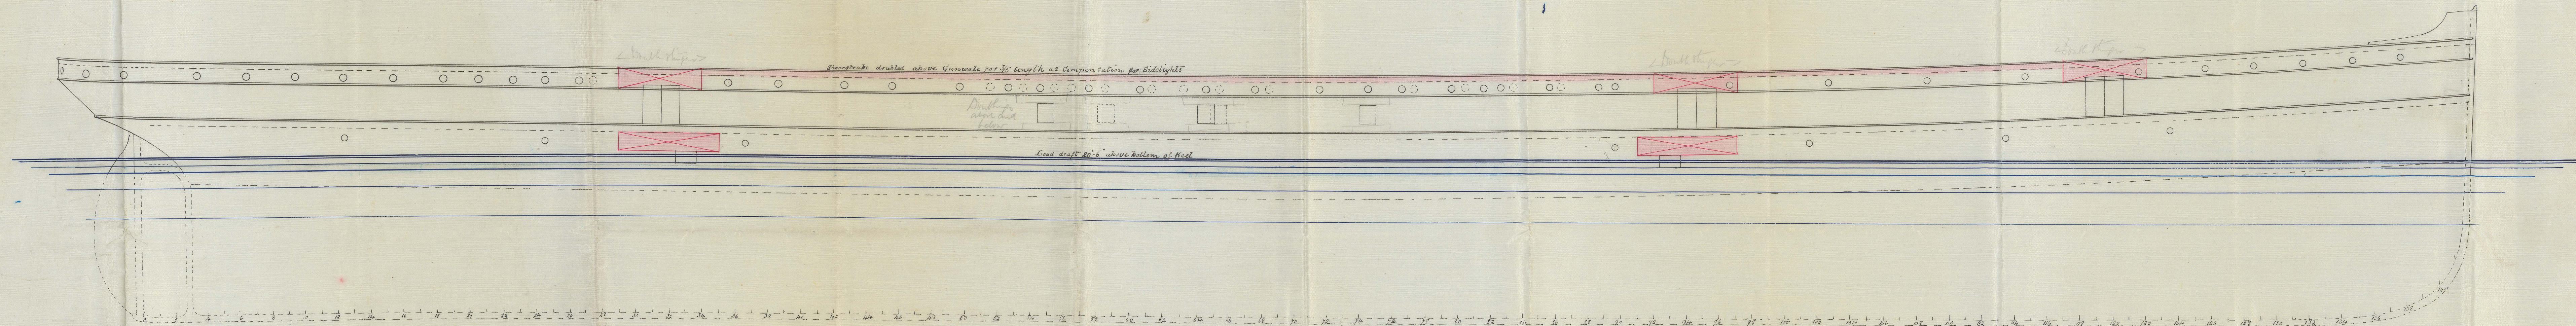

G-LS201-0147

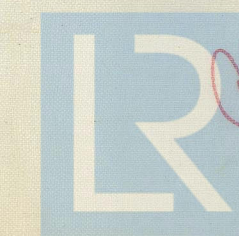

2021
Lloyd's Register
Foundation