

1894



Mr. to Glas 3/10/84

S.S. "Tokio Maru" Glasgow Report N. 6843.

Pumping Arrangement S.S. N. 26

Scale 1 inch = 1 Foot.


Napier Shanks & Bell

Yoker

1st Oct. 1884

M

3.10.84

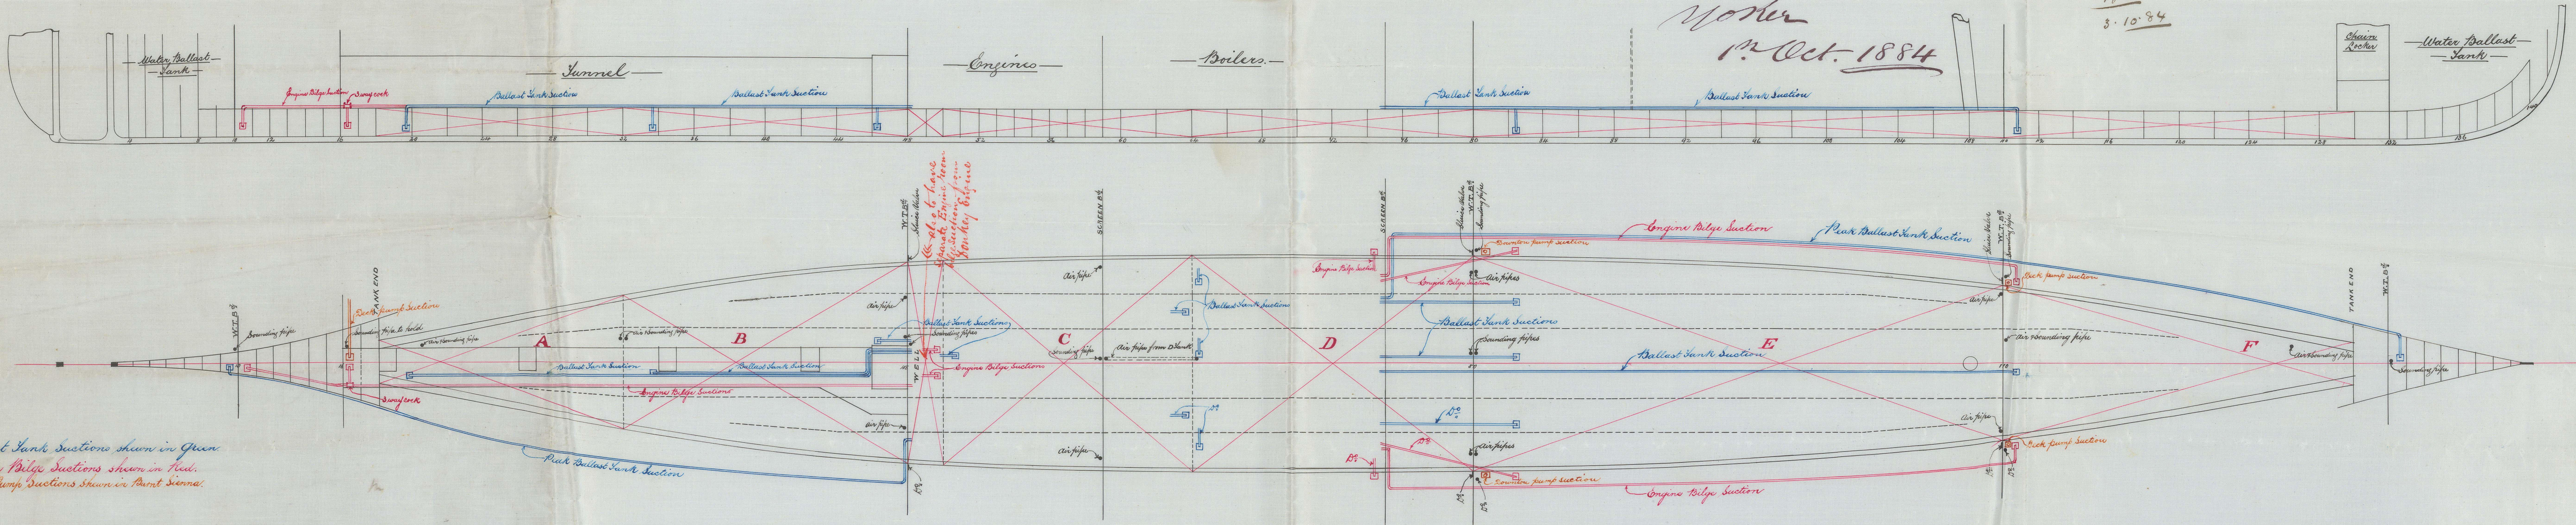

Ballast Tank Suctions shown in Green.
Engine Bilge Suctions shown in Red.
