



22 JAN 84

See: D.G.S.
26/1/84.

S.S. "Tokio Maru" Glasgow Report No. 6843.—
S.S. No. 26
Lower Deck Plan.
Scale $\frac{1}{4}$ inch = 1 foot.

1575

Apier Shanks & Bell
Yokohama. Glasgow
19 Jan. 1884

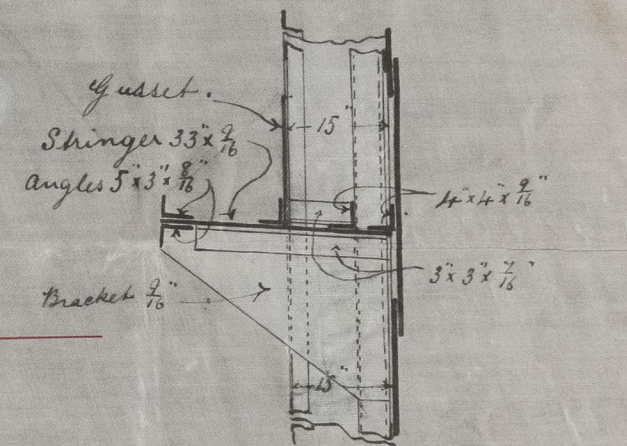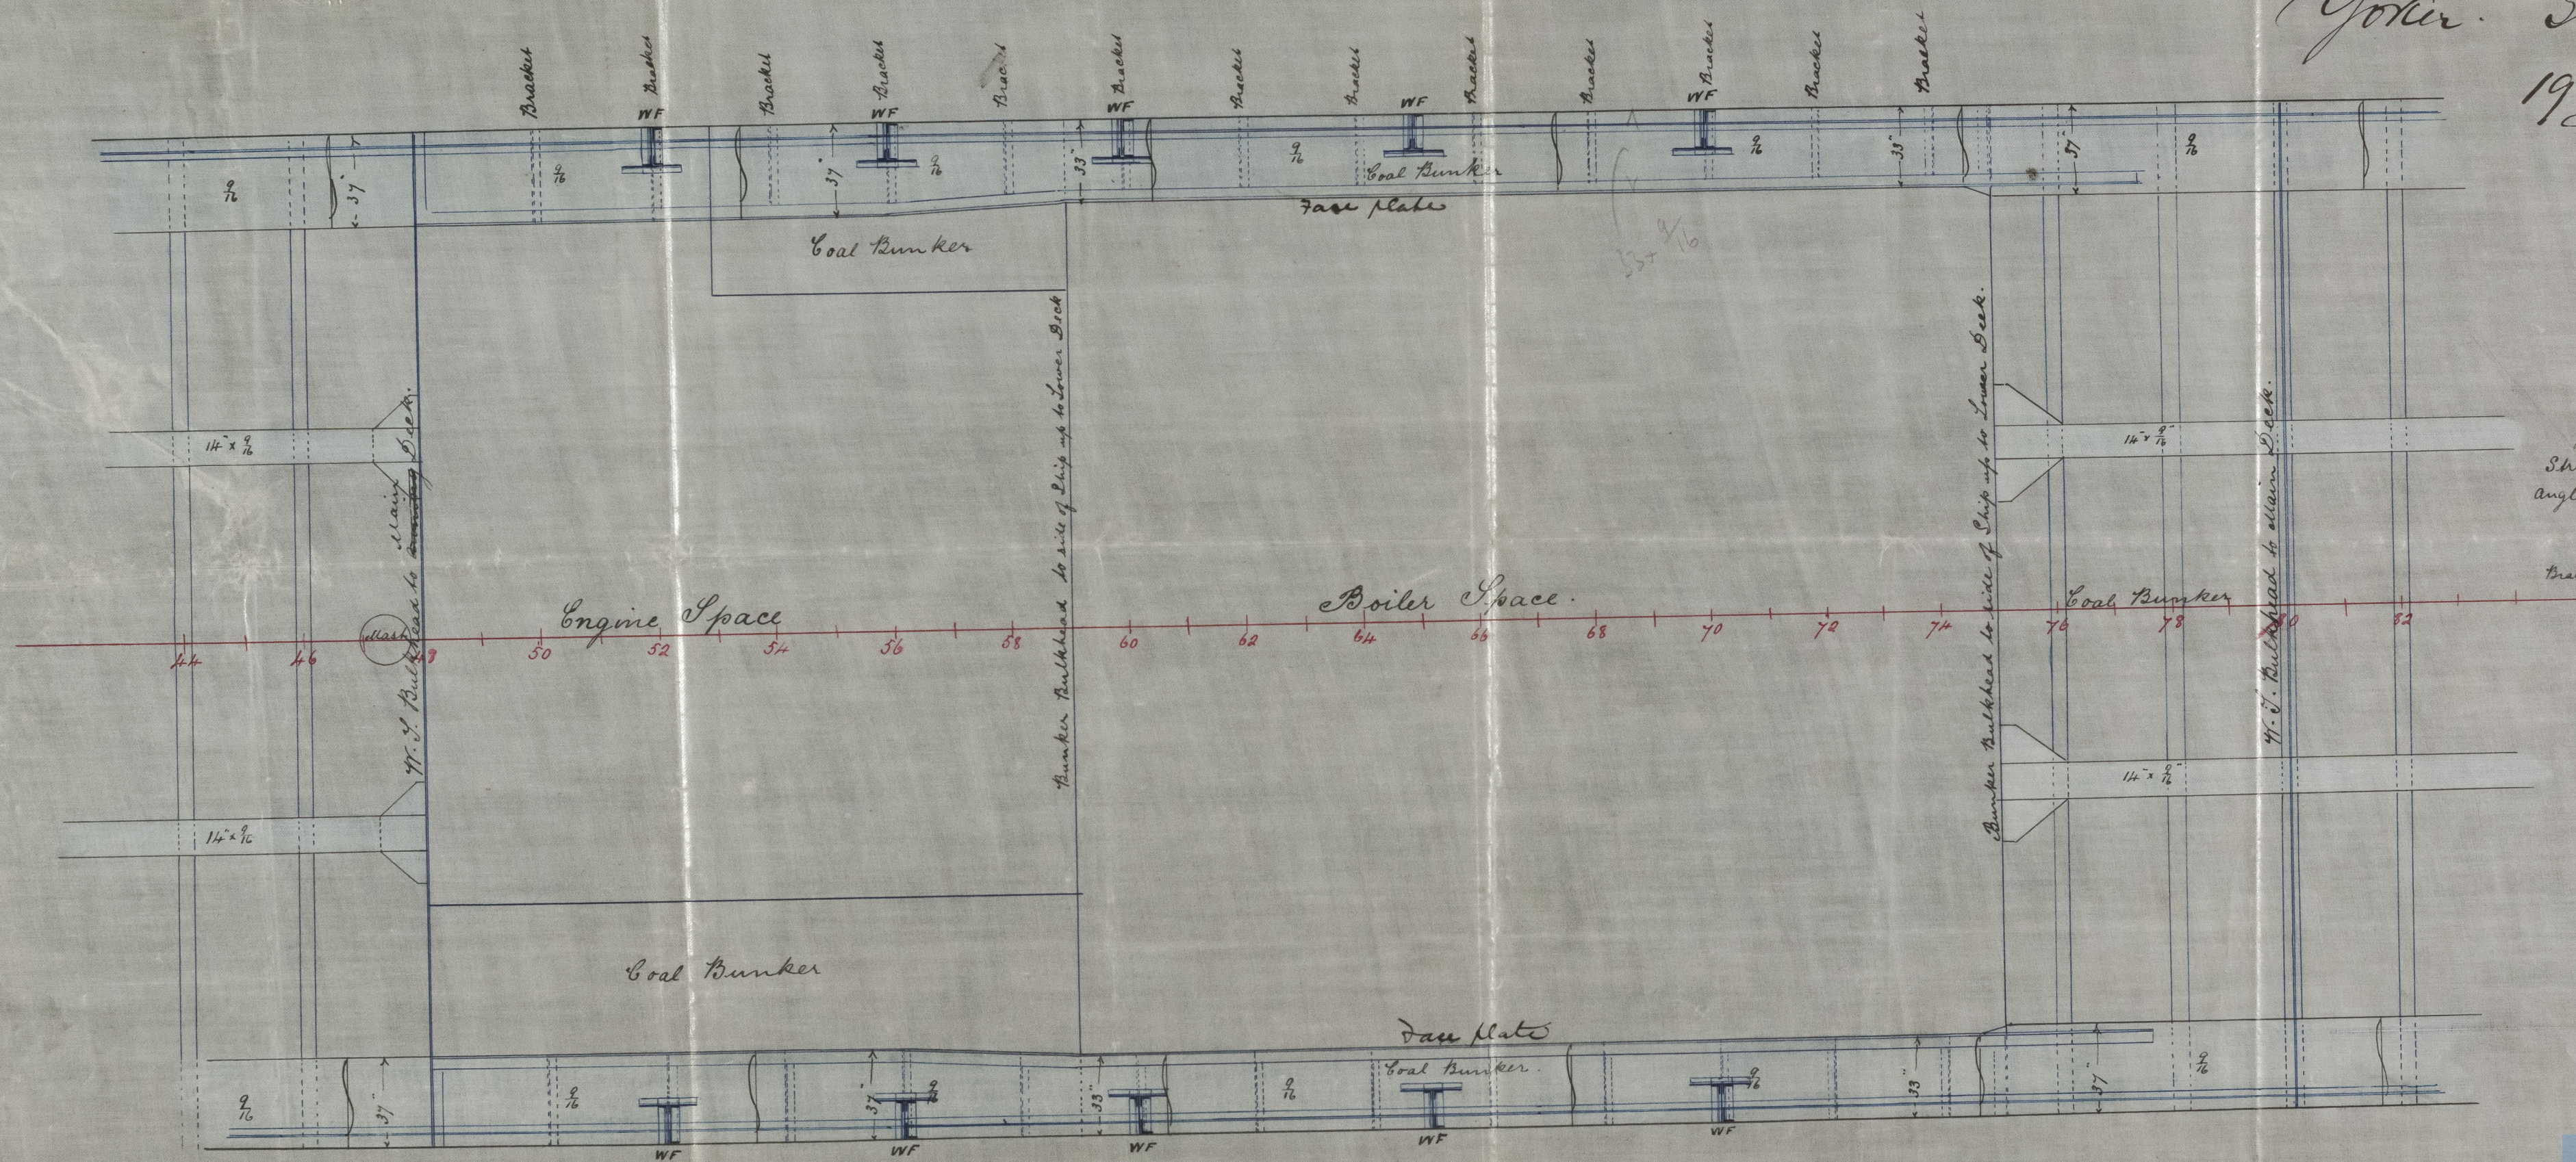

Section of Stringer Bracket.
Scale $\frac{1}{2}$ inch = 1 foot.