

Glasgow Report No. 6843.  
 Lloyd's Register of British and Foreign Shipping.

(Received in the London Office, .....

F.

No. 546

REPORT ON SHIP FORGINGS.

Sir,

I beg leave to report that the undermentioned Forgings, manufactured by  
*The Portland Forge Co* of *Kilmarnock*  
 for the Vessel No. *26*, being built by *Messrs Napier, Shanks & Bell*  
 of *Glasgow* have been inspected by me in course  
 of being forged and smithed, and found to be, so far as can be seen, *sound and*  
*efficient*

Mark on Forging.

Lloyd's  
 No. 546  
 G.N.

The Secretary,  
 London.

I am, Sir,


Your Obedient Servant,

*George Newcomb*  
*Glasgow*

21/2/84

|                        | STERN FRAME.  | RUDDER FRAME. | STEM. |
|------------------------|---|---------------|-------|
| Material*              | <i>Scrap iron</i>                                     | /             | /     |
| How made               | <i>Forged</i>   |               |       |
| Dimensions             | <i>9 1/2 x 5 1/2</i>                                  |               |       |
| Progress on Inspection | <i>Forged and smithed</i>                             |               |       |
| Dates when Inspected   | <i>8.18.26/12/83. 9.16.24.30/1/84.<br/>6.13/2/84.</i> |               |       |

SKETCHES OF FRAMES SHEWING POSITION AND DESCRIPTION OF WELDS.

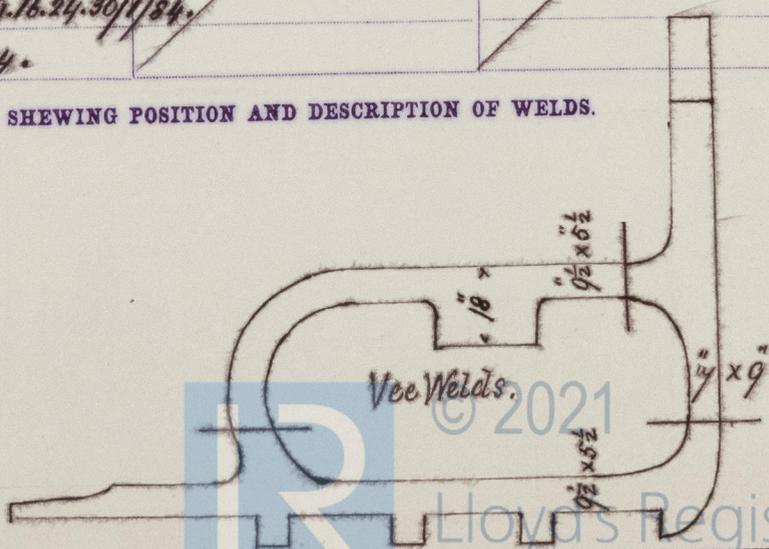

\* If of iron, state whether scrap or puddled iron.