

Lloyd's Register of British and Foreign Shipping.

(Report on Vessel No. 68743 Port Glasgow)

No. 576

SHIP FORGINGS OR CASTINGS.

The words FORGINGS or CASTINGS, IRON or STEEL, should be struck out as may be required.

I have to report that the undermentioned Iron ~~or Steel~~ Forgings ~~or Castings~~, manufactured by The Portland Forge Co of Kilmarnock for the Vessel No. 26, being built by Messrs Napier, Shanks & Bell of Glasgow have been inspected by me as set forth below, and found to be, so far as can be seen, sound and efficient

Mark on Forgings.

Lloyd's
No. 576
G. N.


George Newcomb

Glasgow

17/6/84.

	STERN FRAME.	RUDDER FRAME.	STEM.
Material*	/	Scrap iron	/
How made		Forged	
Dimensions		$7\frac{1}{2}$ to $3\frac{3}{4}$	
Progress on Inspection		Forged and smithed	
Dates when Inspected		16.24.31/1/84. 13.19.26/3/84. 4.17/4/84. 8.13/5/84.	

SKETCHES OF FRAMES SHEWING POSITION AND DESCRIPTION OF WELDS OF FORGINGS, OR PARTICULARS OF TESTS APPLIED TO CASTINGS.

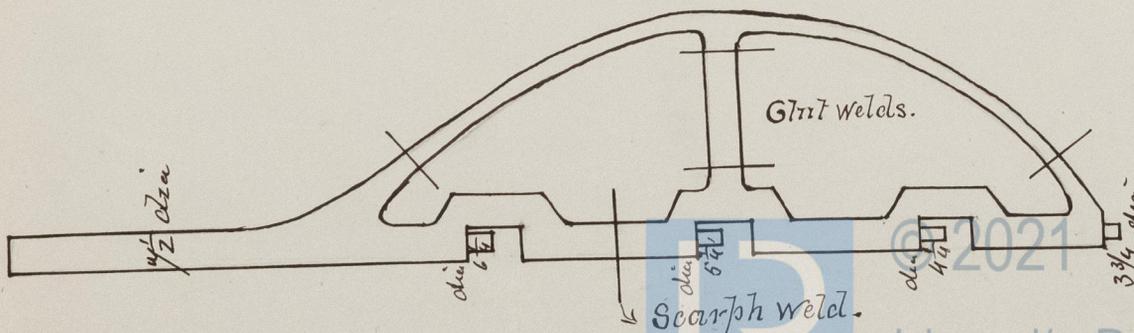

* If of Iron, state whether scrap or puddled iron.