


Bk "Marion Brosbie" Glasgow Report N. 6845.

Lt. L. L. L.
25/9/84.

Lower deck
laid at ends.

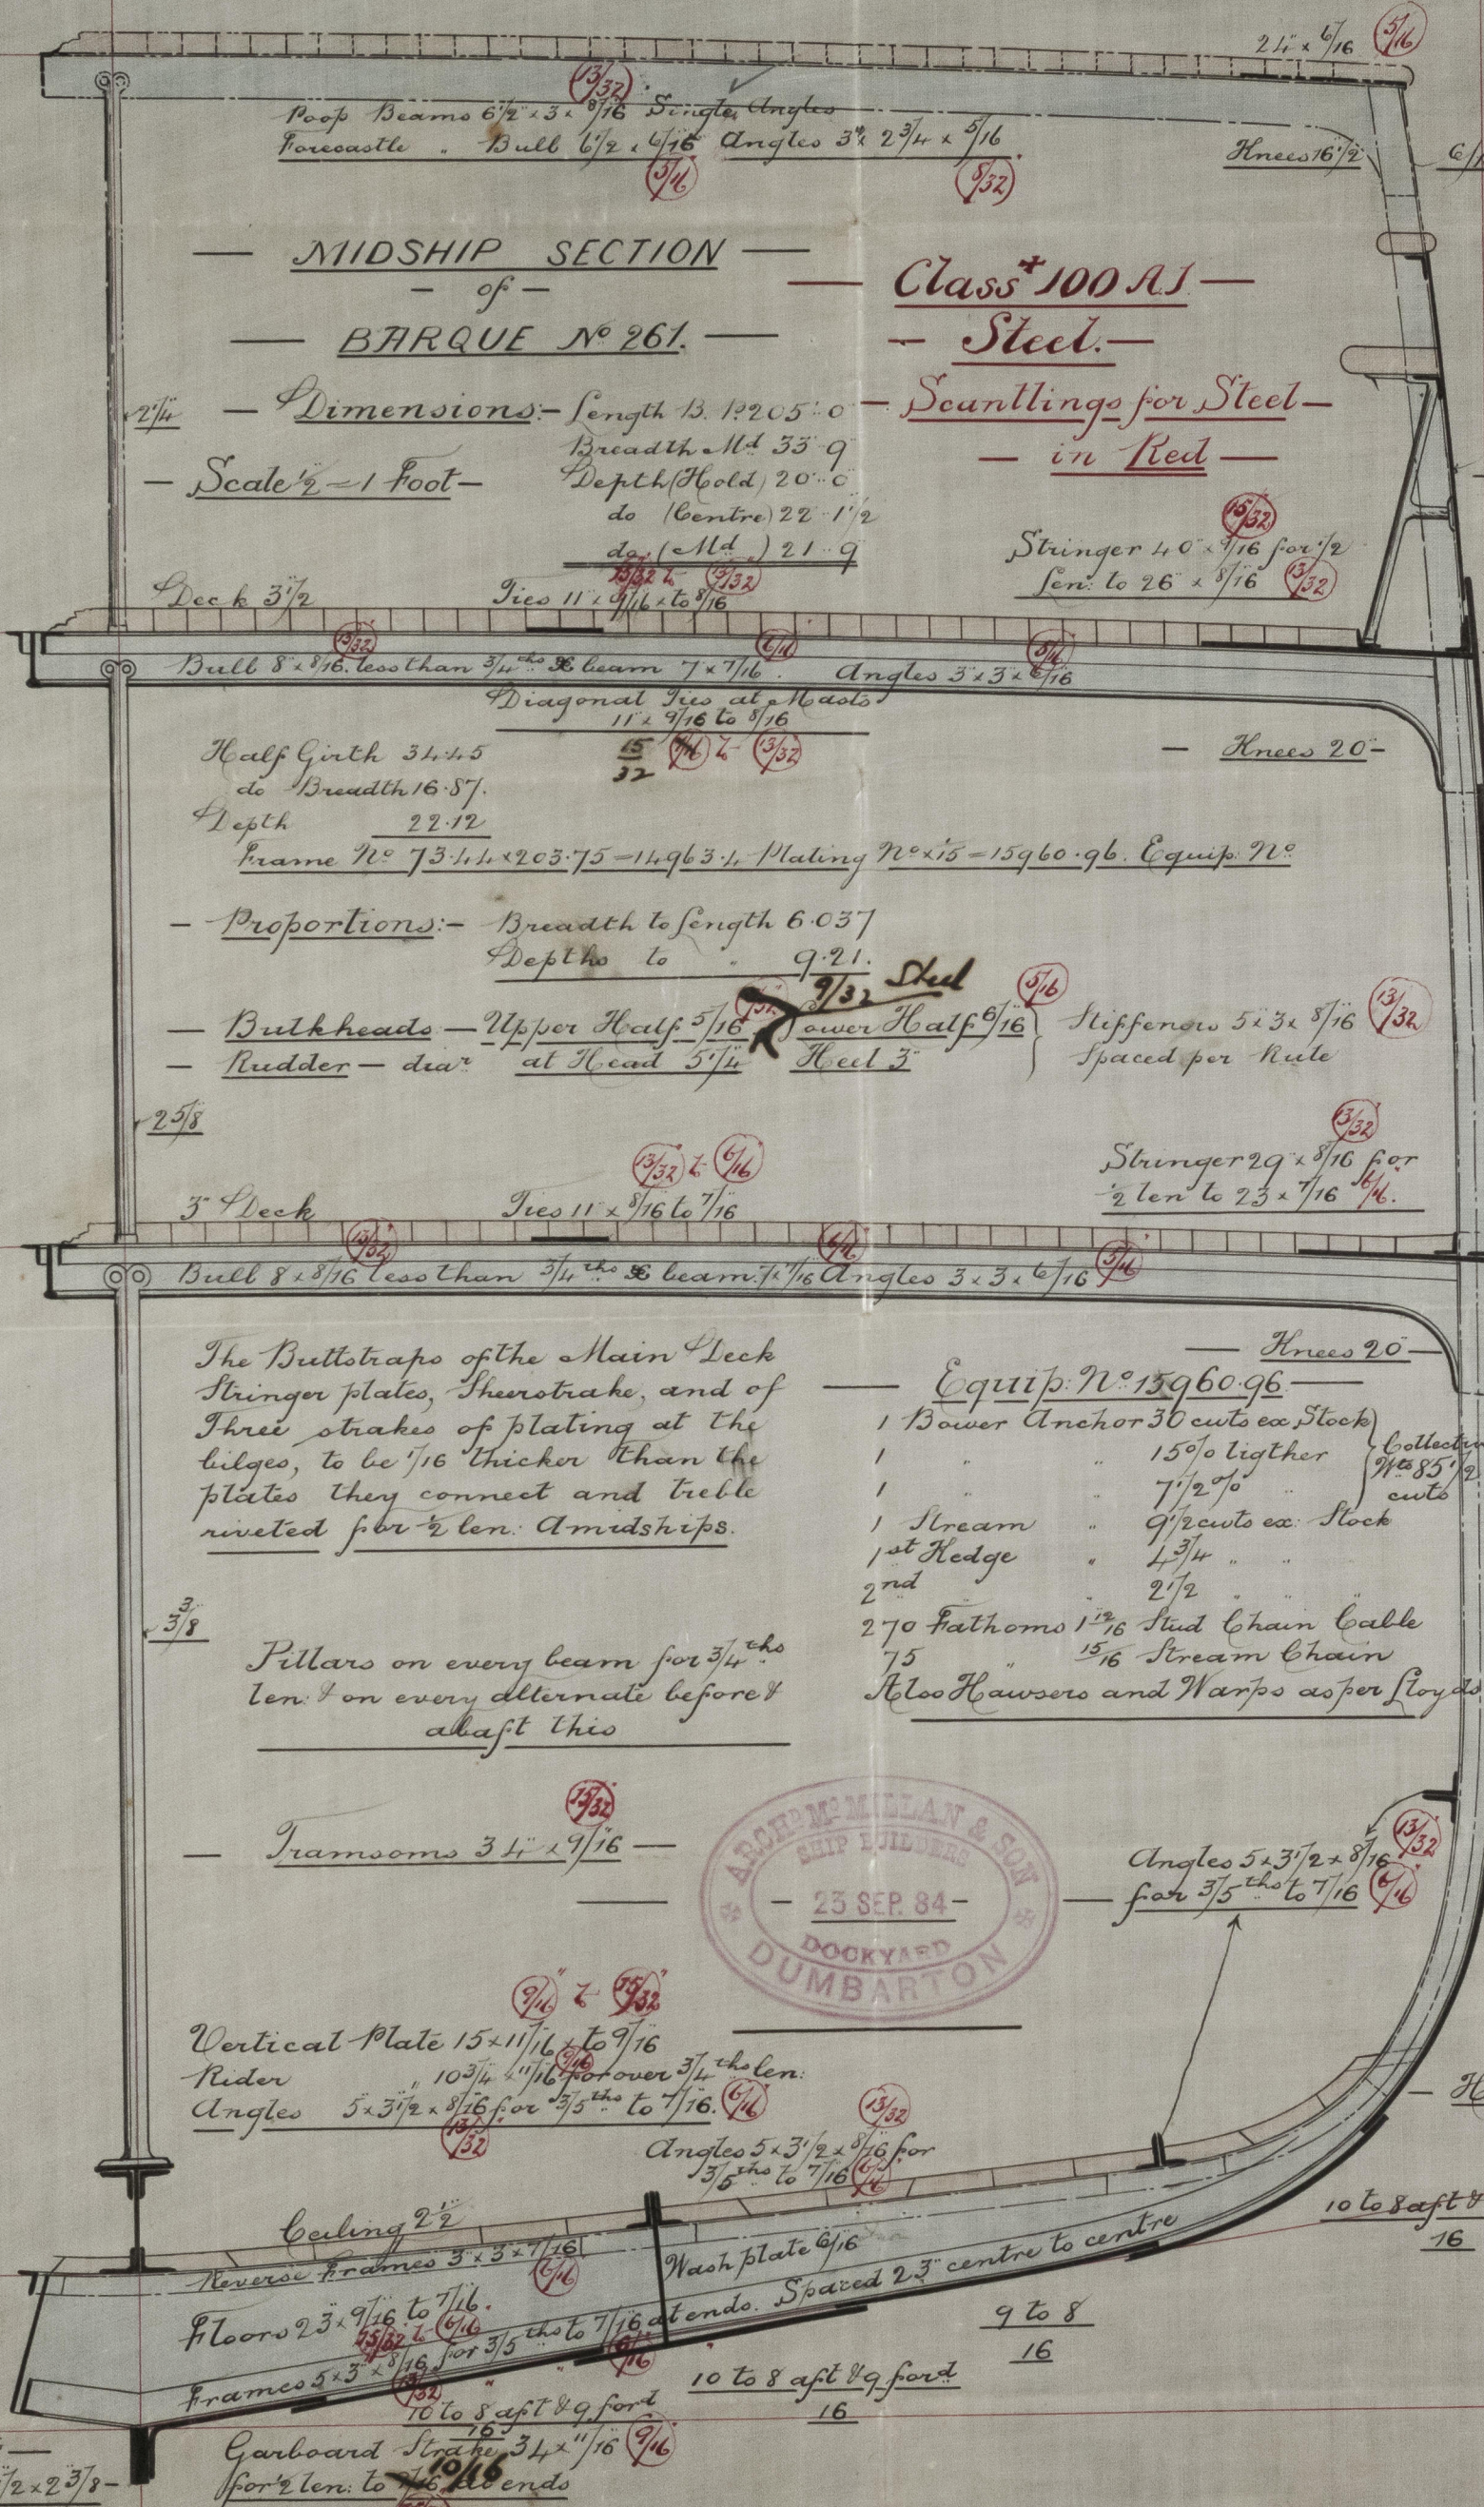

5 x 3 1/2 x 8/16 for 3/5 to 7/16
Height of Alternate Reverse -
Sheerstrake 36 x 1/16 for 1/2 len
to 9/16 aft 10/16 for d

9 to 8
16

10 to 8 aft 8 1/2 for d

Height of Alternate Reverse -
3 1/2 x 3 1/2 x 8/16 for 3/5 to 7/16

9 to 8
16

Outside strakes of shell plating
8/16 to 13/16 aft and 13/16 for d

Inside strakes of shell plating
15/32 to 1/2 for d and aft

10 to 8 aft 8 1/2 for d
16

9 to 8
16

Height of Floors

10 to 8 aft 8 1/2 for d
16

9 to 8
16

10 to 8 aft 8 1/2 for d
16

16 Steel.
32

Keel, stem, rudder, and stern frames, rivets, slips, sheerstrake timbers, pillars,
Fronts of Poop, and Forecastle, deckhouses, hatch comings, washplates, and waterway angles, to be of iron.

24/9/84. R.

1800
25/9/84

© 2021

Lloyd's Register
Foundation