

Lloyd's Register of British and Foreign Shipping.

(Report on Vessel No. 6845 Port Glasgow)

No. 165.a. SHIP FORGINGS OR CASTINGS.

I have to report that the undermentioned Iron or Steel Forgings or Castings, manufactured by

The Darlington Forge Co of Darlington
for the Vessel No. 261, being built by Capt. A W Millen Sons
of Dumbarton have been inspected by me as set forth below, and found
to be, so far as can be seen, sound.

Mark on Forgings.


Lloyd's
No. 165.a
100

H Cameron

Sunderland

	STERN FRAME. <i>Post</i>	RUDDER FRAME.	STEM.
Material* - - - -	<i>Scrap Iron</i>	<i>Scrap Iron</i>	<i>Scrap Iron</i>
How made - - - -	<i>Forged</i>	<i>Forged</i>	<i>Forged</i>
Dimensions - - - -	<i>4 1/2 x 2 3/8</i>	<i>5 1/4 - 3"</i>	<i>Keel 8 x 2 1/2" Stem 1 1/2 x 2 1/8</i>
Progress on Inspection -	<i>Forged & Smithed</i>	<i>Forged & Smithed</i>	<i>Forged</i>
Dates when Inspected	<i>Oct 6-10-15-18-24-28/84</i> <i>Nov 5-18-22-29 Dec 4/84</i>	<i>Oct 6-10-15-19-24-28</i>	<i>Oct 2-6/84</i>

SKETCHES OF FRAMES SHEWING POSITION AND DESCRIPTION OF WELDS OF FORGINGS, OR PARTICULARS OF TESTS APPLIED TO CASTINGS.

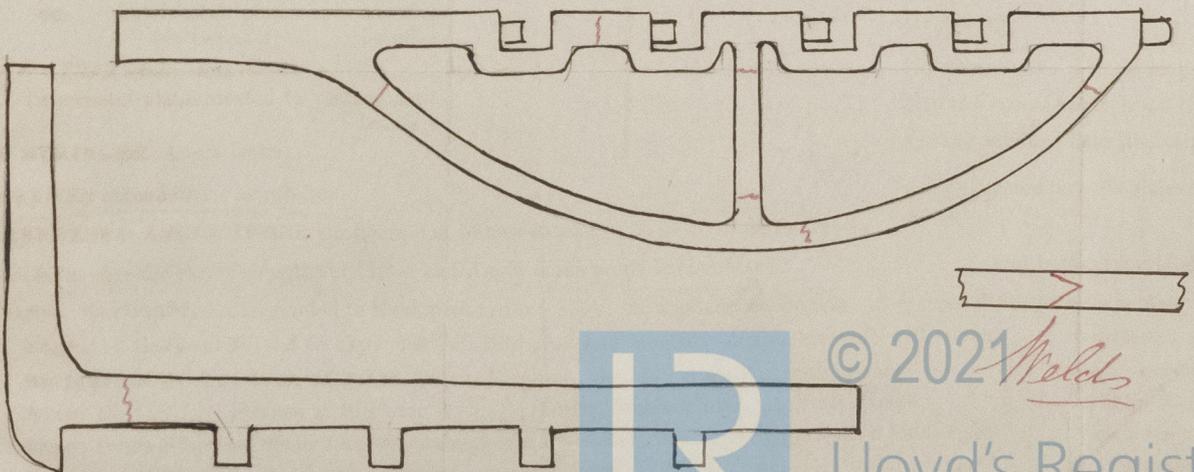

* If of Iron, state whether scrap or puddled Iron.



© 2021 *Welds*
Lloyd's Register
Foundation