
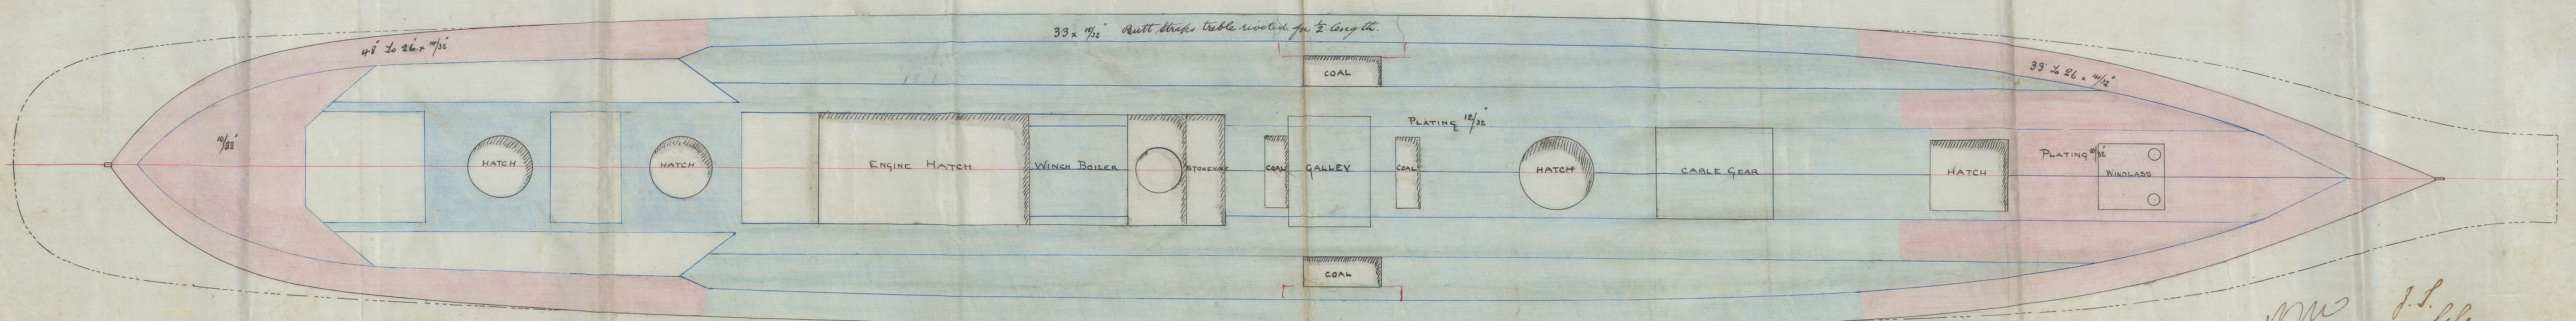
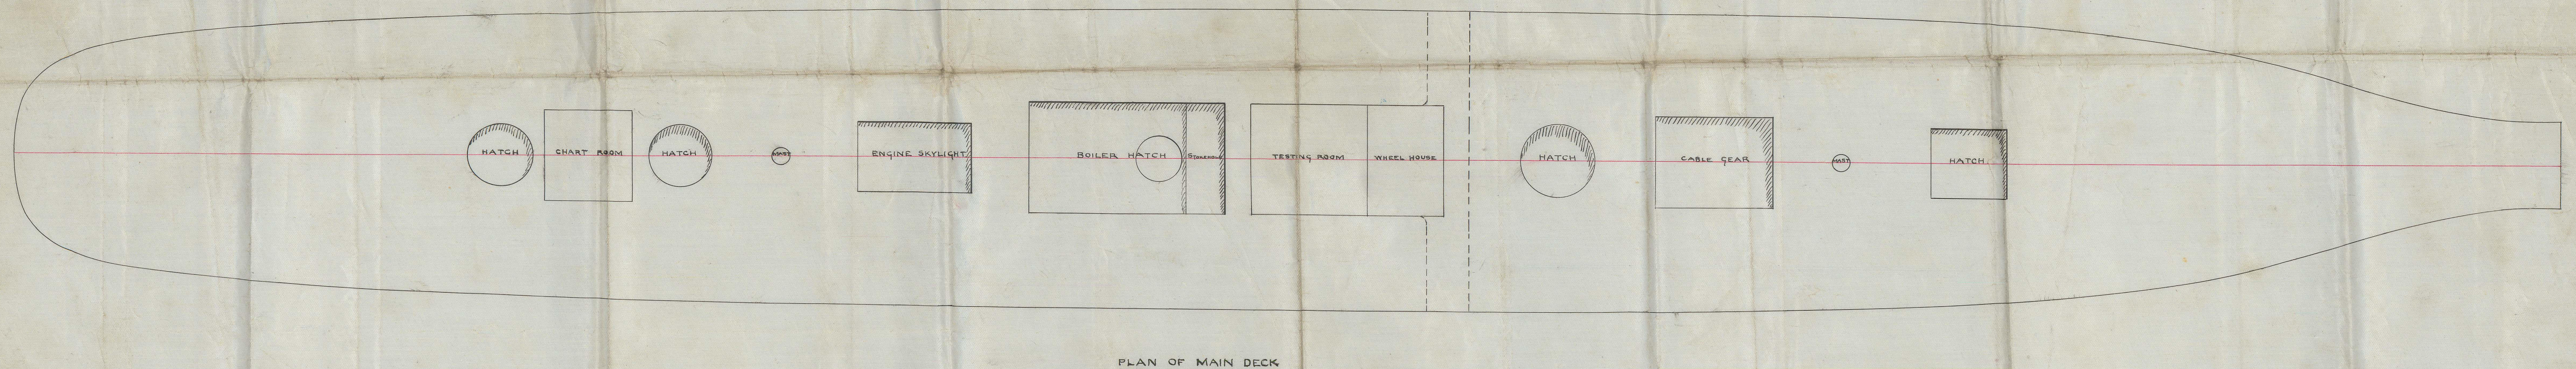


14094  
No 395

Lk. N. L. L.  
14/8/84.  
21/8/84 - 30/10/84.

Scale  $\frac{1}{8}$  inch = 1 foot - S. S. "Electra" Glasgow Report No. 6844.

W. H. Raper & Co.  
2. Aug. 1884

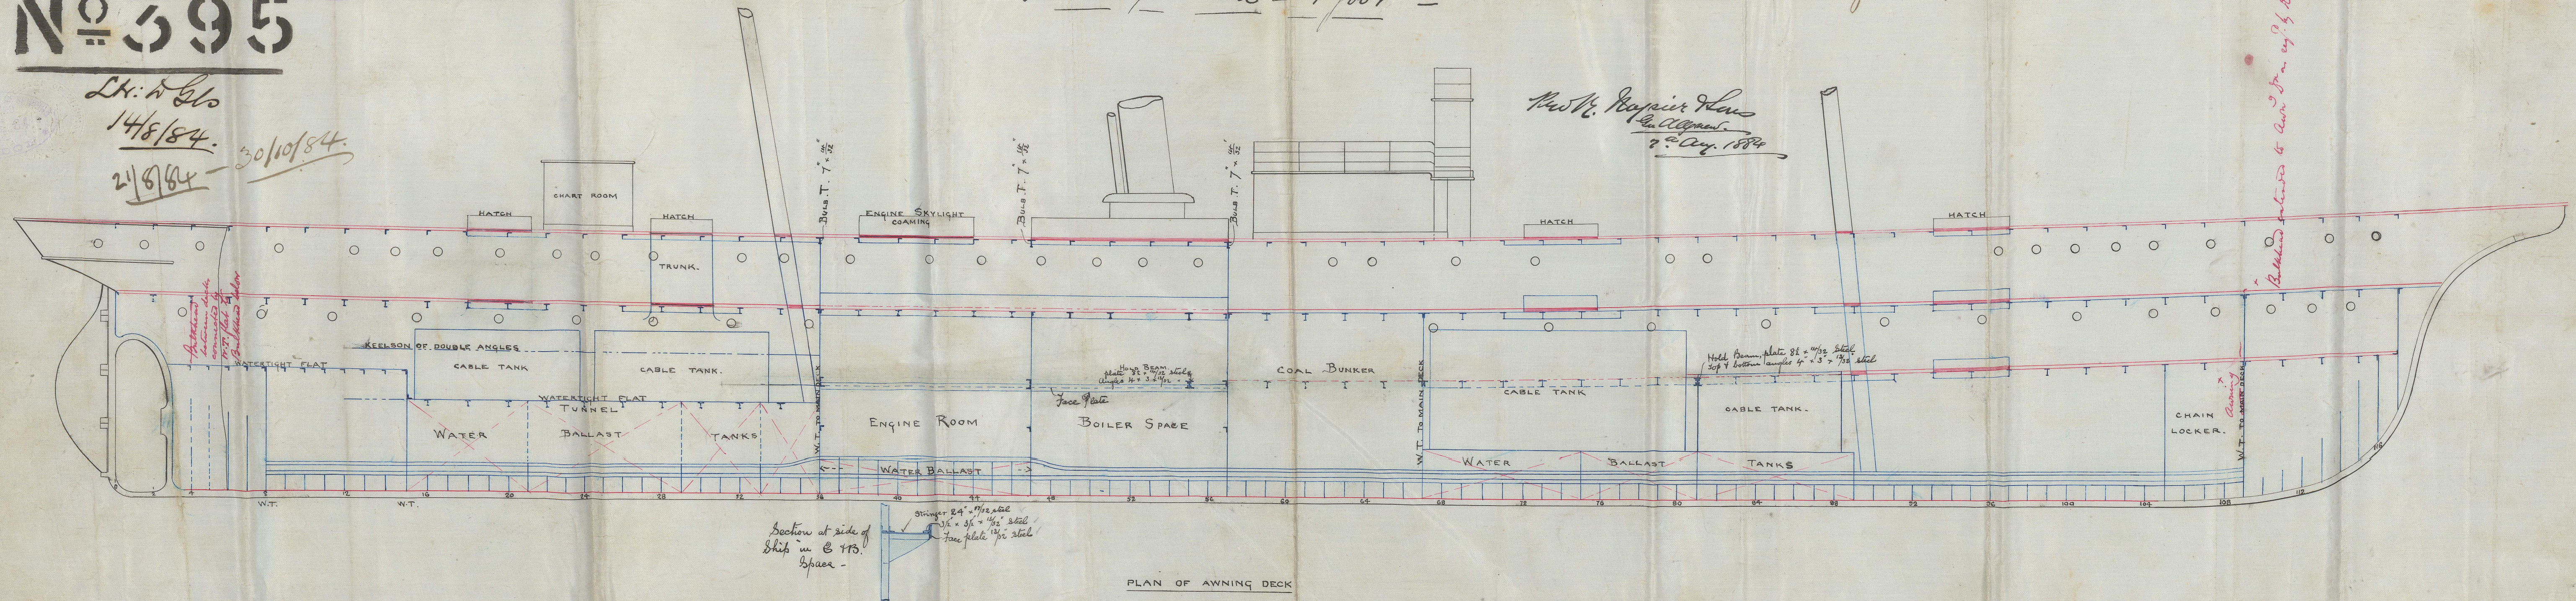

W. H. Raper & Co.  
13/8/84