

# Lloyd's Register of British and Foreign Shipping.

(Report on Vessel No. 6844 Port Glasgow)

## No. 848 SHIP FORGINGS OR CASTINGS.

I have to report that the undermentioned Iron or ~~Steel~~ Forgings or Castings, manufactured by The Lancefield Forge Co of Glasgow for the Vessel No. 395, being built by Messrs R. Napier & Sons of Glasgow have been inspected by me as set forth below, and found to be, so far as can be seen, sound and efficient

The words FORGINGS or CASTINGS, IRON or STEEL, should be struck out as may be required.

Mark on Forgings.

Lloyd's  
No. 848  
G. N.


George Newcomb

Glasgow

29/11/84.

	STERN FRAME.	RUDDER FRAME.	STEM.
Material* - - - -	/	Scrap iron	/
How made - - - -		Forged	
Dimensions - - - -		6 1/2 and 3 1/2	
Progress on Inspection -		Forged and smithed	
Dates when Inspected		9.13.21.24/10/84. 3.14.19.28/11/84.	

SKETCHES OF FRAMES SHEWING POSITION AND DESCRIPTION OF WELDS OF FORGINGS, OR PARTICULARS OF TESTS APPLIED TO CASTINGS.

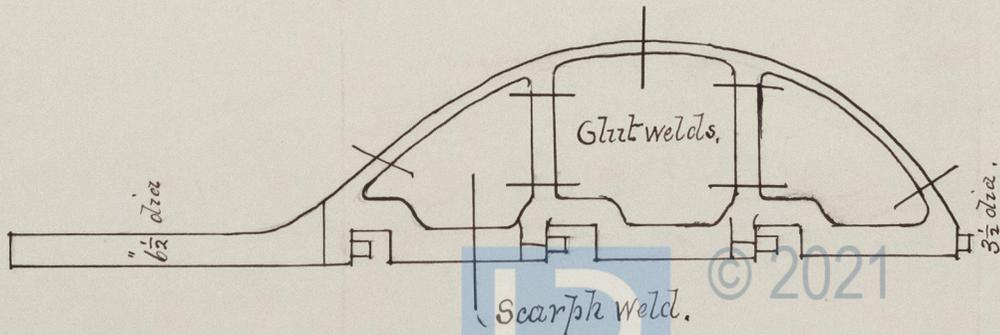

\* If of Iron, state whether scrap or puddled Iron.