


LLOYD'S REGISTER OF SHIPPING
RECEIVED
1 DEC 84
LONDON

Letter Gls:
4/12/84

Elevation & Deck Plans of S.S. No 119
Scale 1/4" = one foot


S.S. "Northward" Glasgow Report
No 6892.

H. MONTYRE & CO
SHIPBUILDERS
1 DEC 84

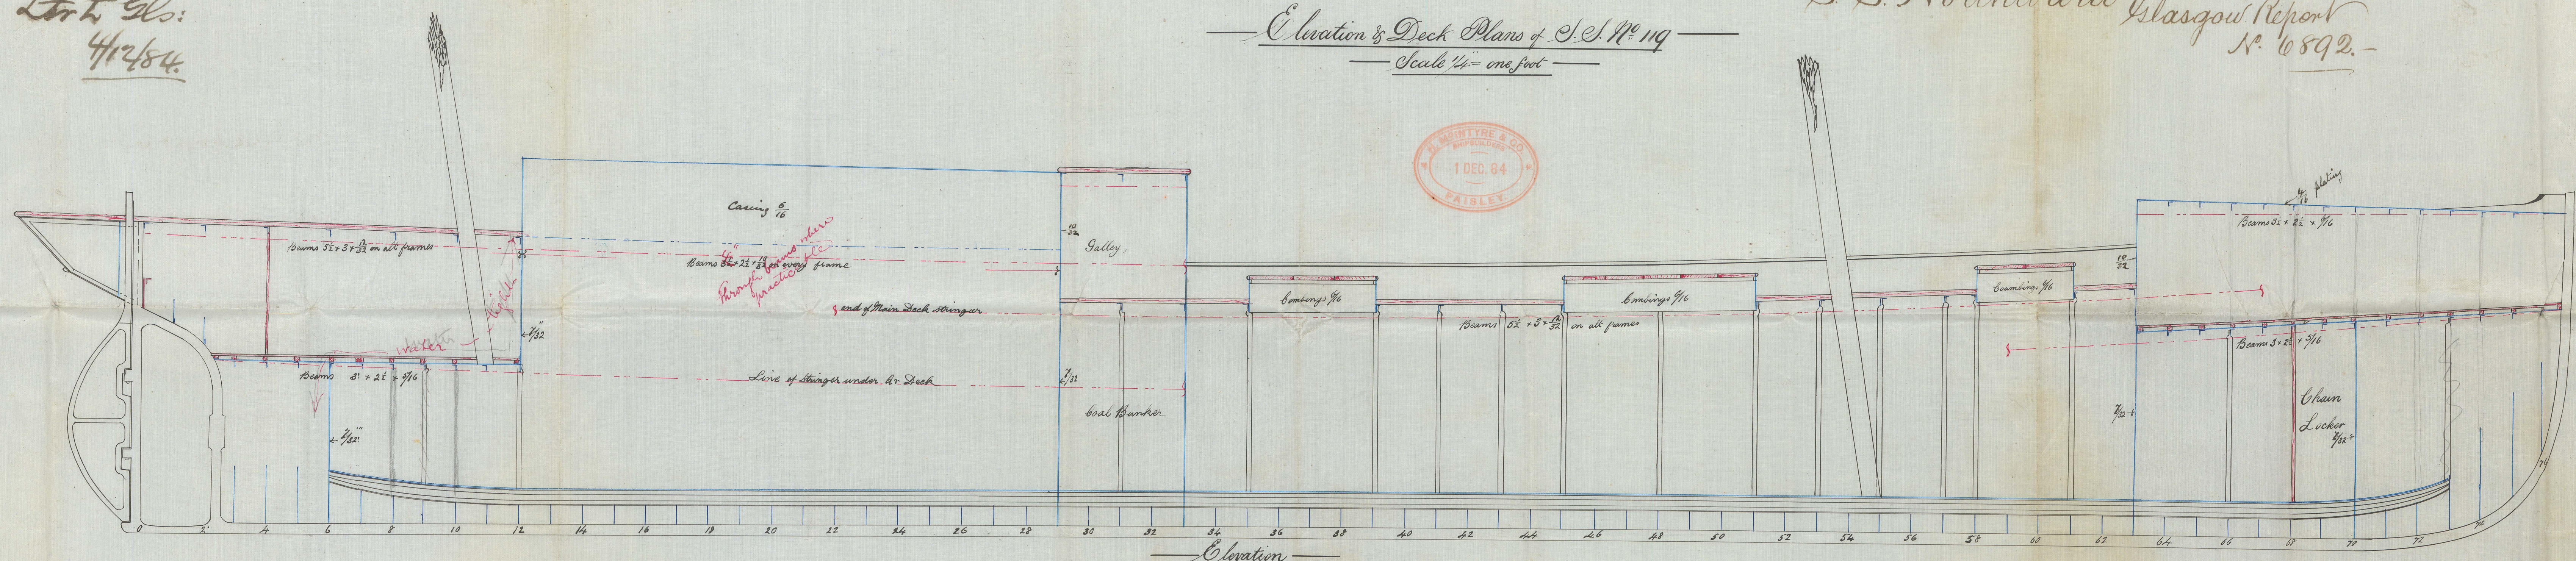

Quarter Deck

Main Deck

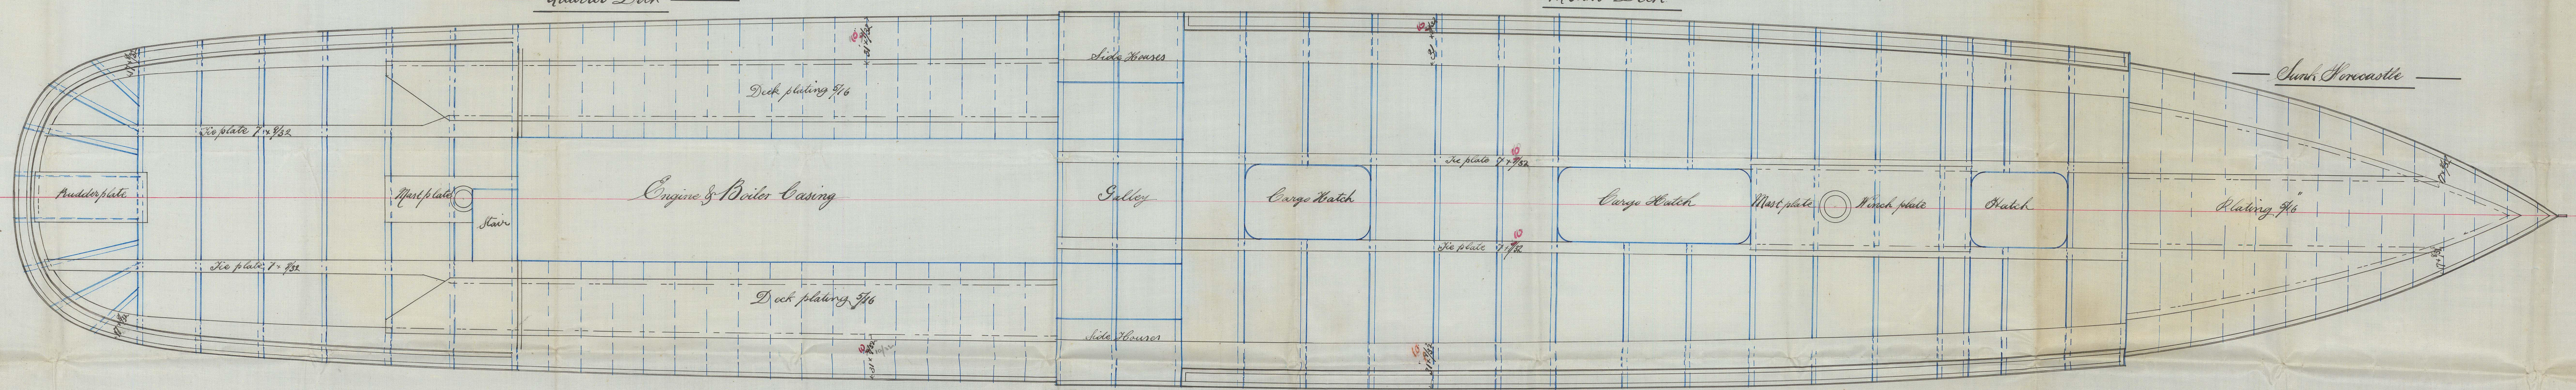

4/12/84