

S.S. "John Strachan" Glasgow Report No. 6893.

No. 37.
S.S. 65'-6" x 17'-6" x 8'-0".

Scale 1" = one foot.

To Clap at Lloyds 90 A.


By Wm Swan of Maryhill, Glasgow.

Let to S.S.

1/11/84.

18/11/84.

30.1.85.

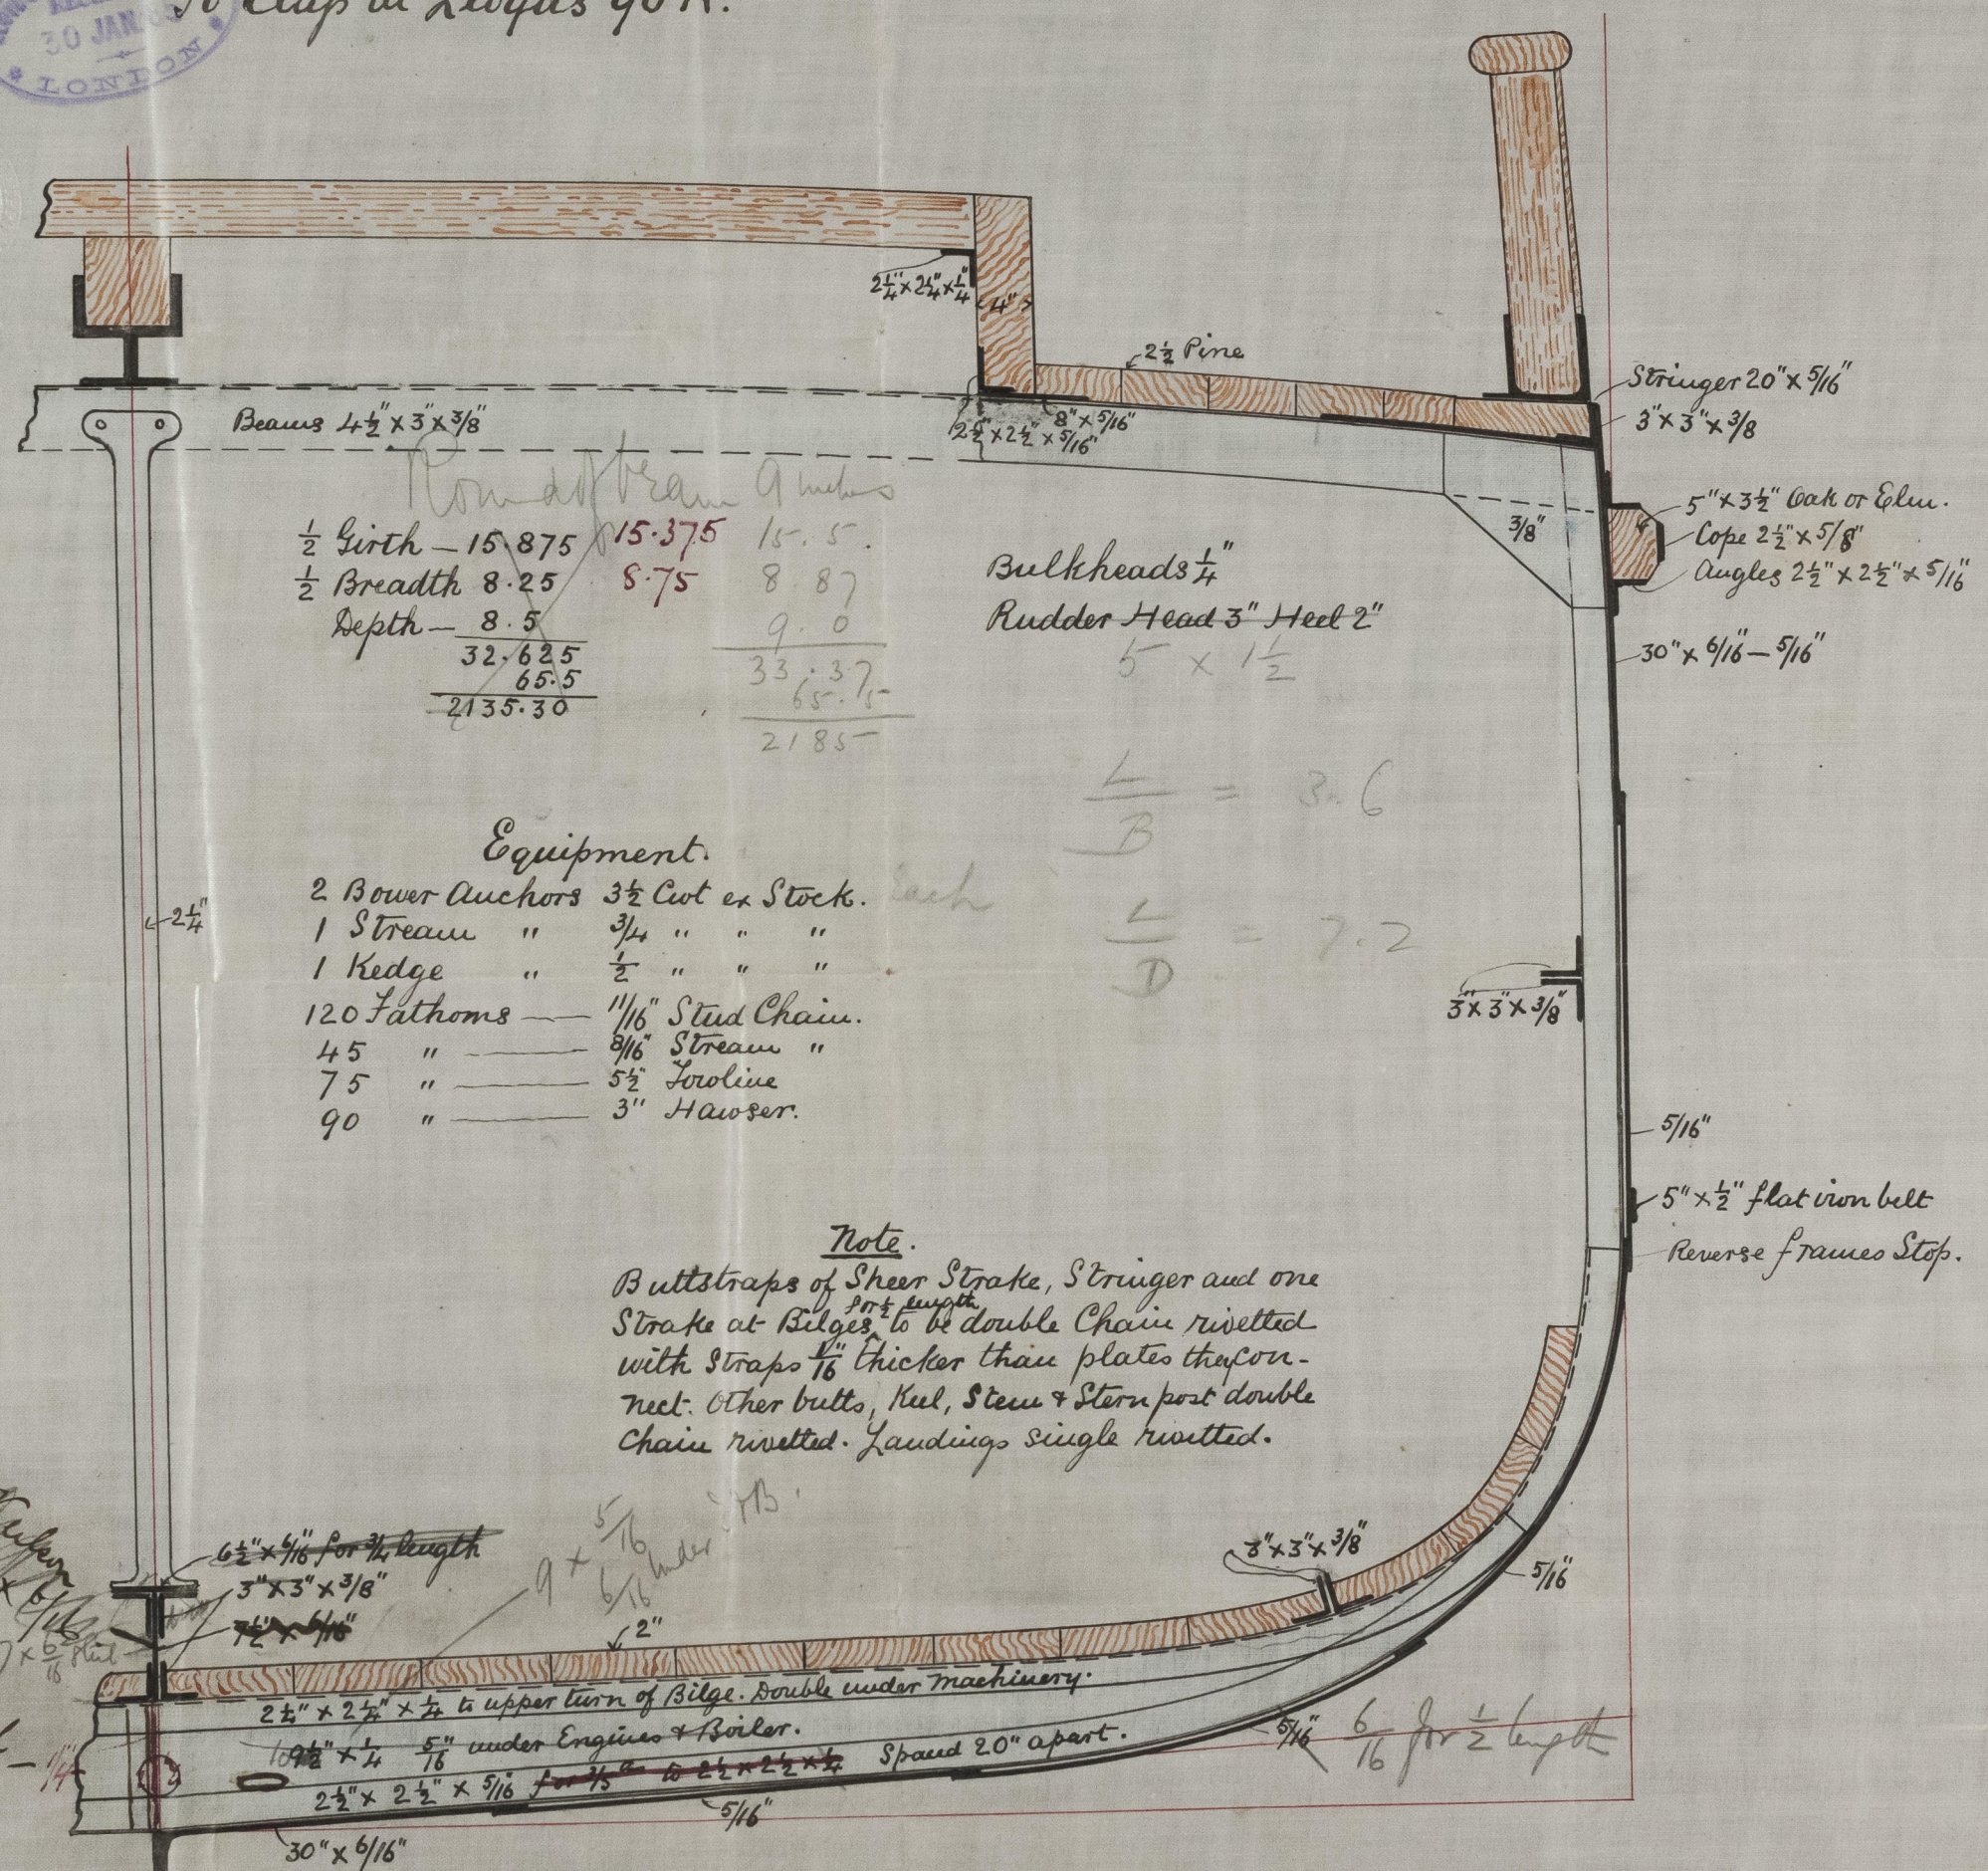

Round beam 9 inches

1/2 Girth	15.875	15.375	15.5
1/2 Breadth	8.25	8.75	8.87
Depth	8.5		9.0
	32.625		33.37
	65.5		65.5
	2135.30		2185

Bulkheads 1/4
Rudder Head 3" Heel 2"
5 x 1 1/2

Equipment.

2 Bower Anchors	3 1/2 Cwt ex Stock.
1 Stream "	3/4 " " "
1 Kedge "	1/2 " " "
120 Fathoms	1/16" Stud Chain.
45 "	3/16" Stream "
75 "	5/16" Trolley
90 "	3" Hawser.

Note.

Buttstraps of Sheer Strake, Stringer and one Strake at Bilges to be double Chain rivetted with Straps 1/16" thicker than plates they connect. Other butts, Keel, Stem & Stern post double Chain rivetted. Landings single rivetted.

Crabtree & Co.
6 x 9/16
7 x 5/8
Intermetal plates - 1/4"

Keel to 1 1/8" 5 x 1 3/8
Stern post 5 1/2 x 2 1/4
Stem 5 1/2 x 1 1/8 5 x 1 3/8

J.T.L.
1/11/84



© 2021
Glasgow
Lloyd's Register
Foundation
28/10/84.