


Dr. & Gls. 24/1/84


S. S. Lake Superior Glasgow Report No 6905.

See amended sketch
S. S. No 222
ELEVATION AND SPAR DECK
SCALE 1/4" = 1'00"

 

Frames 24 inches apart * 20 inches apart 16 inches apart

Part of B. No between Spar & Bridge deck 5/16" Stiffening bars 3x3x5/16

 


1/3 M
24/1/84

Glasgow
24/1/84


GLS202-0056

6905 Glasgow
~~12 D. Lake Superior~~
" "
Lake Superior

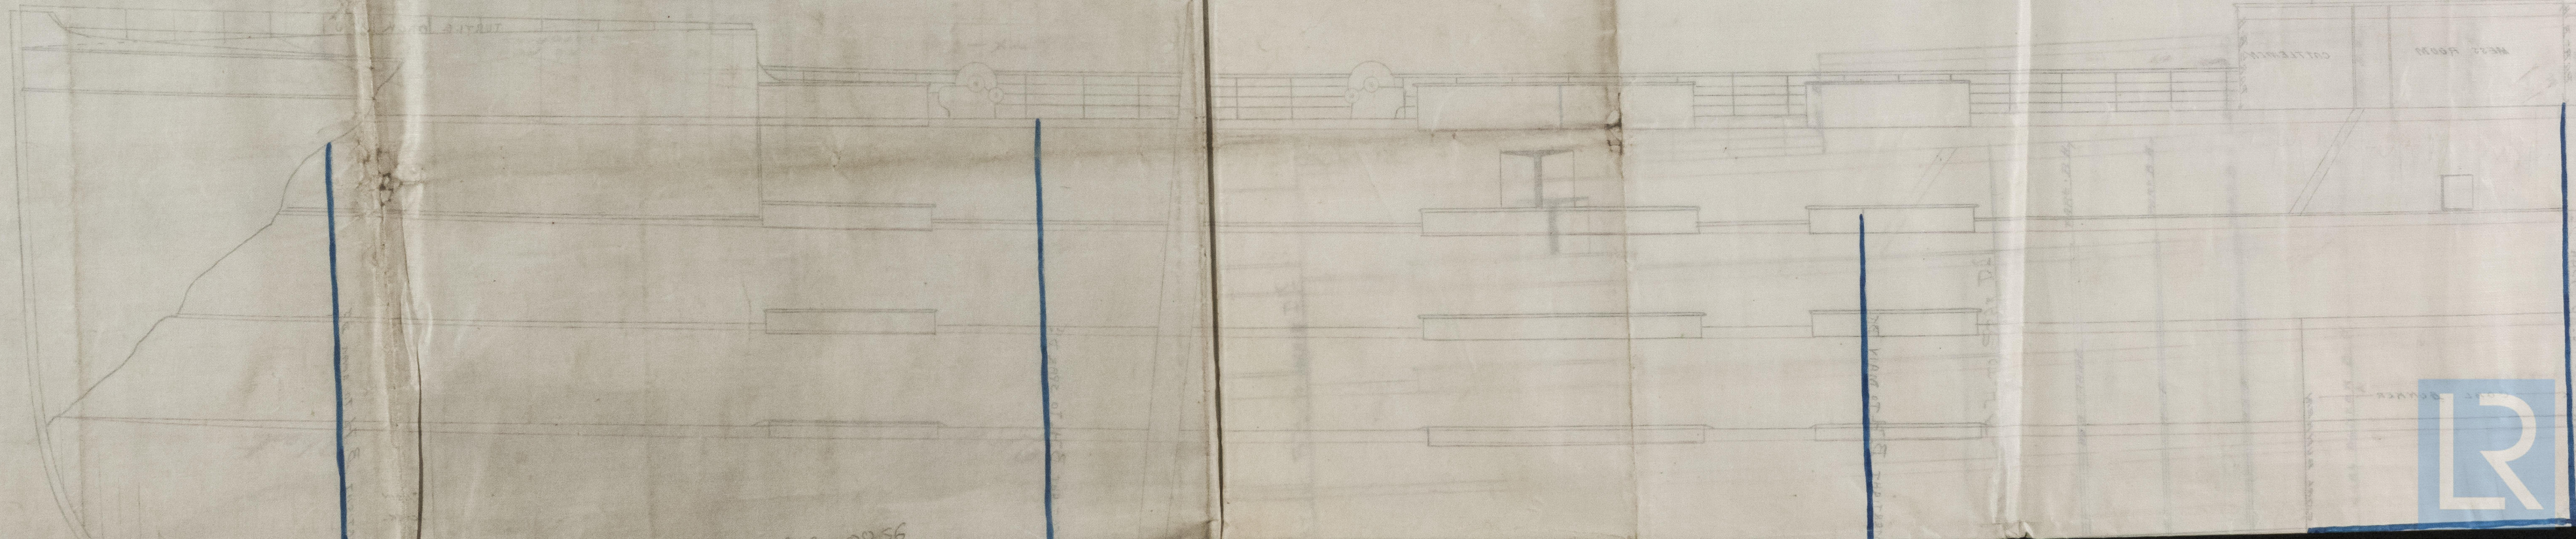

GLS202-0056

6905 Glasgow
~~12 D. Lake Superior~~
" "
Lake Superior

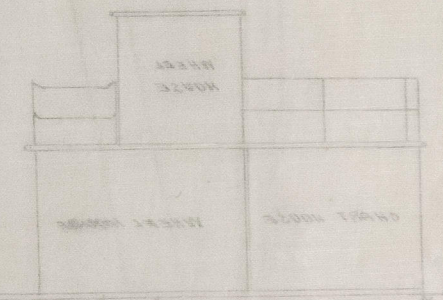

© 2021

Lloyd's Register
Foundation