


20.6 gls
17/7/84

MP
16.7.84

SS. N° 222
ARRANGEMENT OF BILGE PUMP, SLUICE VALVES &
SCALE 1/2" = 1 FOOT

JAMES & GEORGE THOMSON
SHIPBUILDING DEPARTMENT
MADE BY
EXAMINED BY
DATE 12 JUL 1905
CLYDE

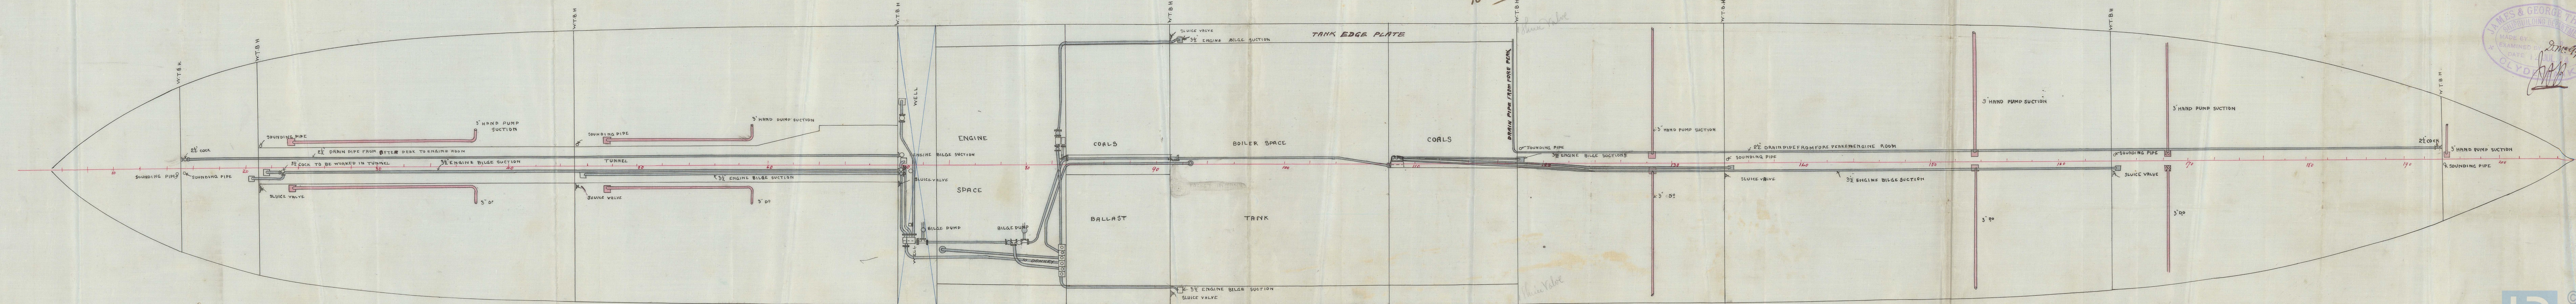

