


*Dr. Arrangement of Lateral Plating. See Amended Midship Section*  
*Iron S.S. No. 222.*

*Ans: to L.S. 2/2/84.*  
*Lake Superior*

*S. S. No 222*  
*SCALE 1/2" = ONE FOOT*

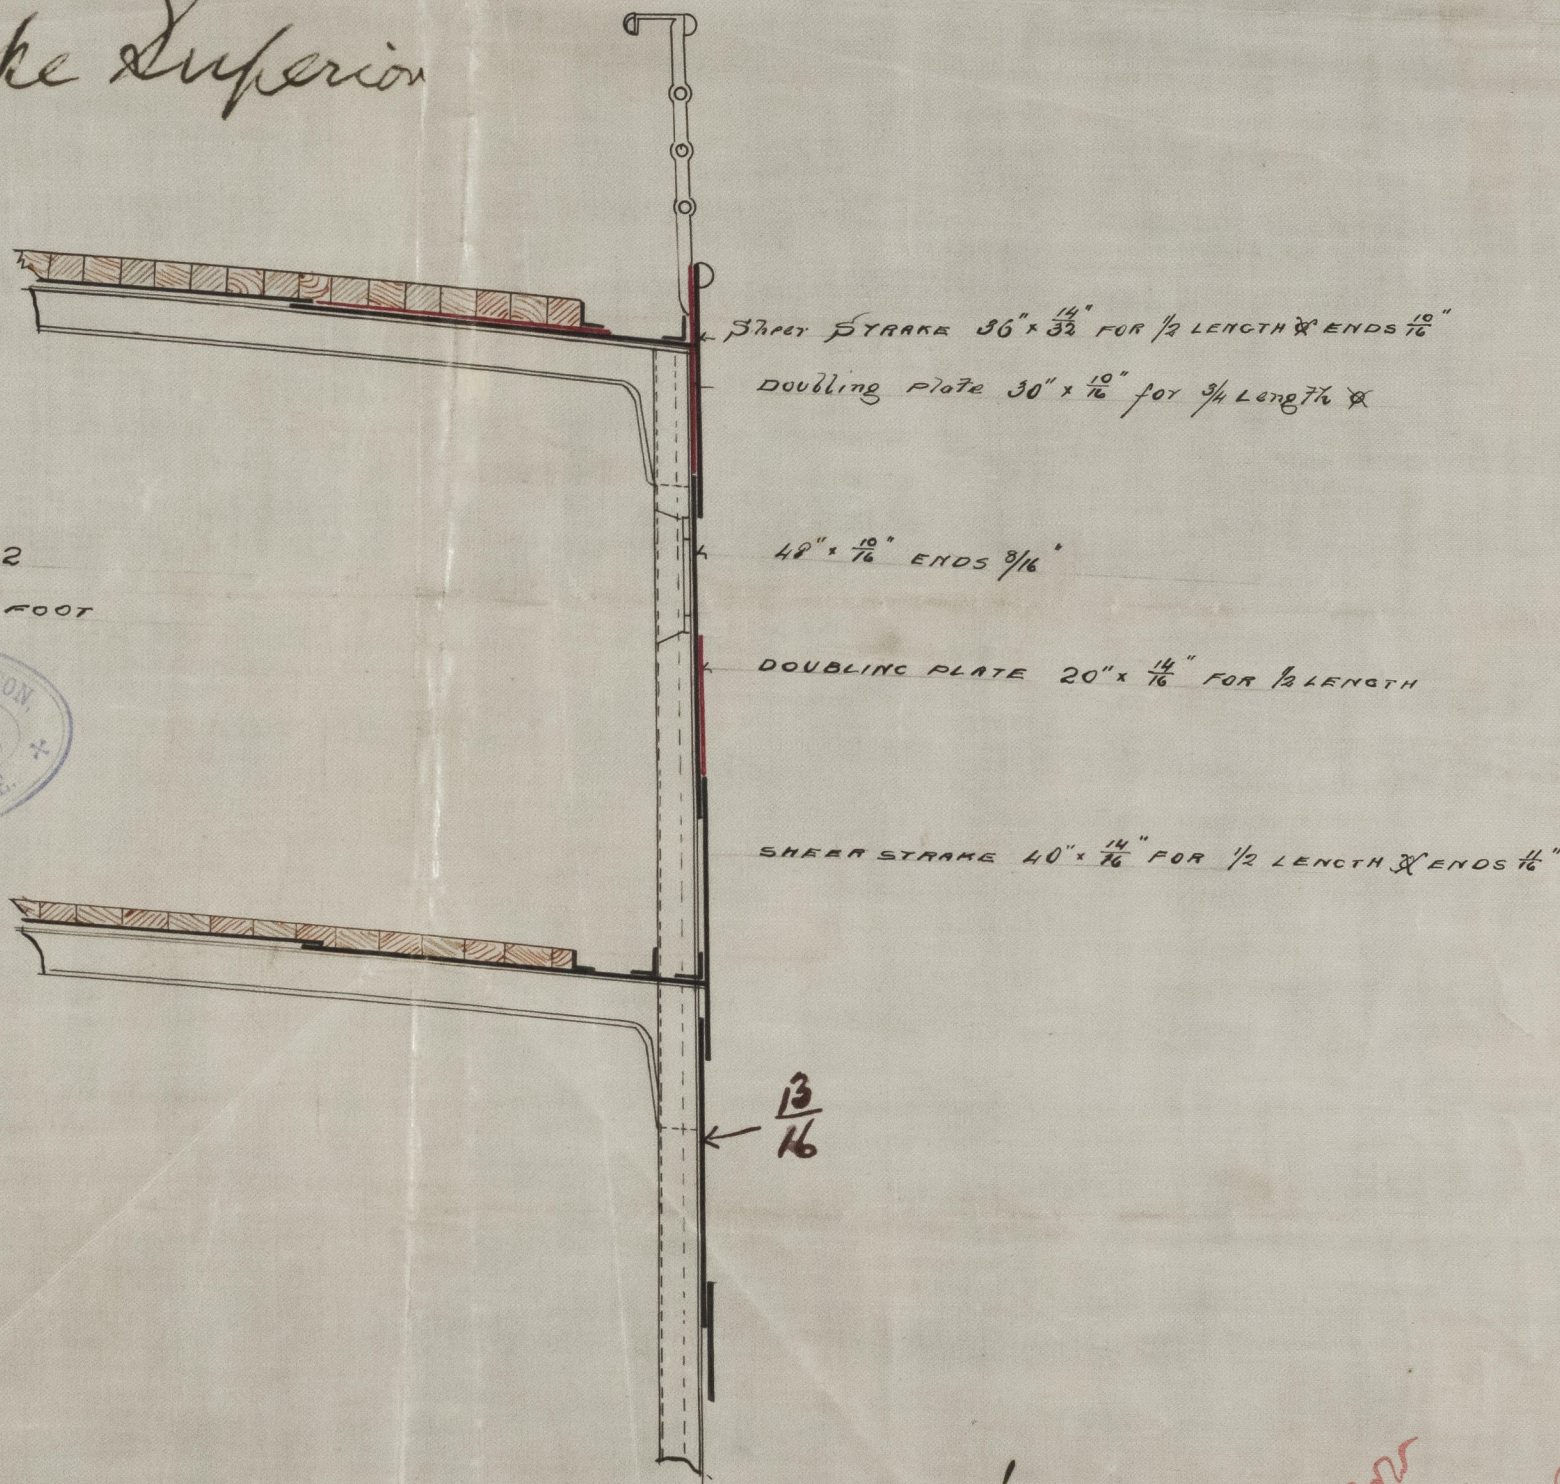

*J.H.L.*  
*2/2/84*