


S. S. "Lake Superior" Glasgow Report No. 6905. Mr. Furling


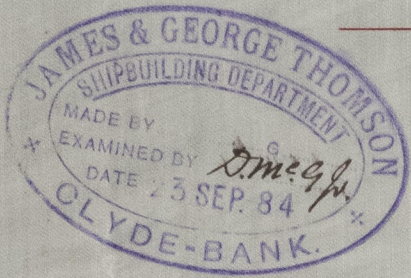


EXTRA BEAMS IN BOILER SPACE

S. S. "LAKE SUPERIOR"

No 222

SCALE 1/4" = ONE FOOT

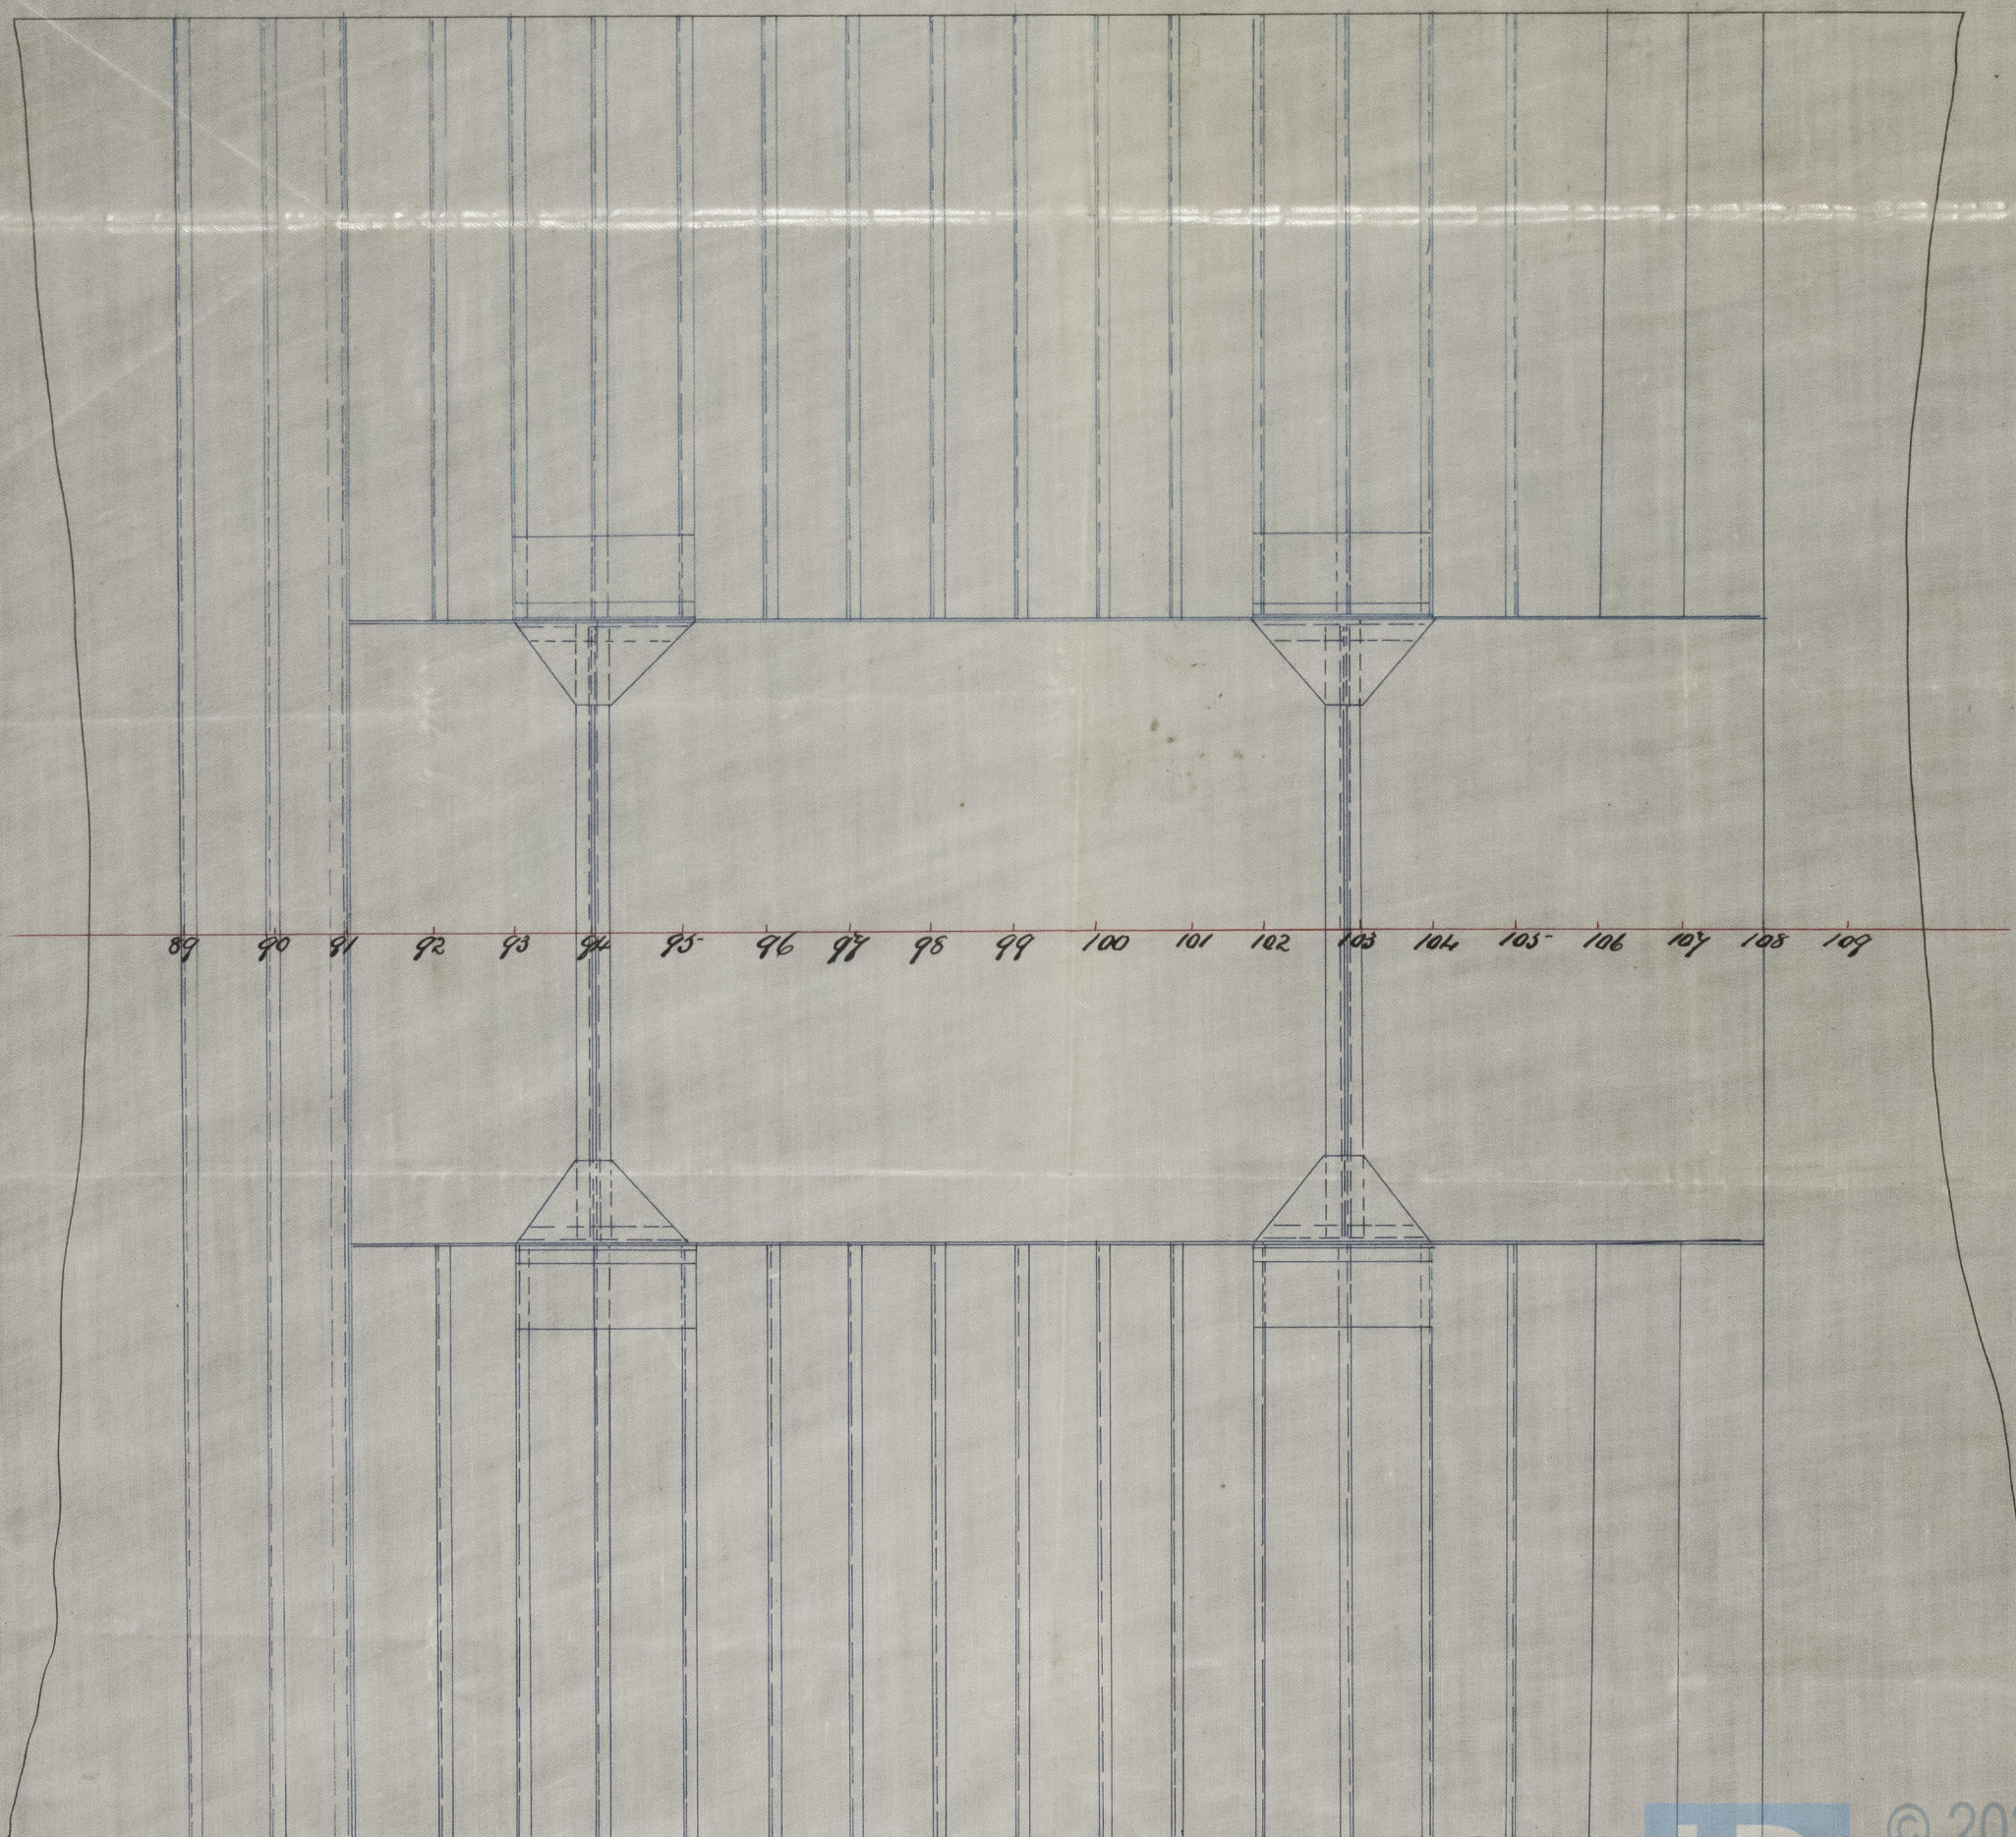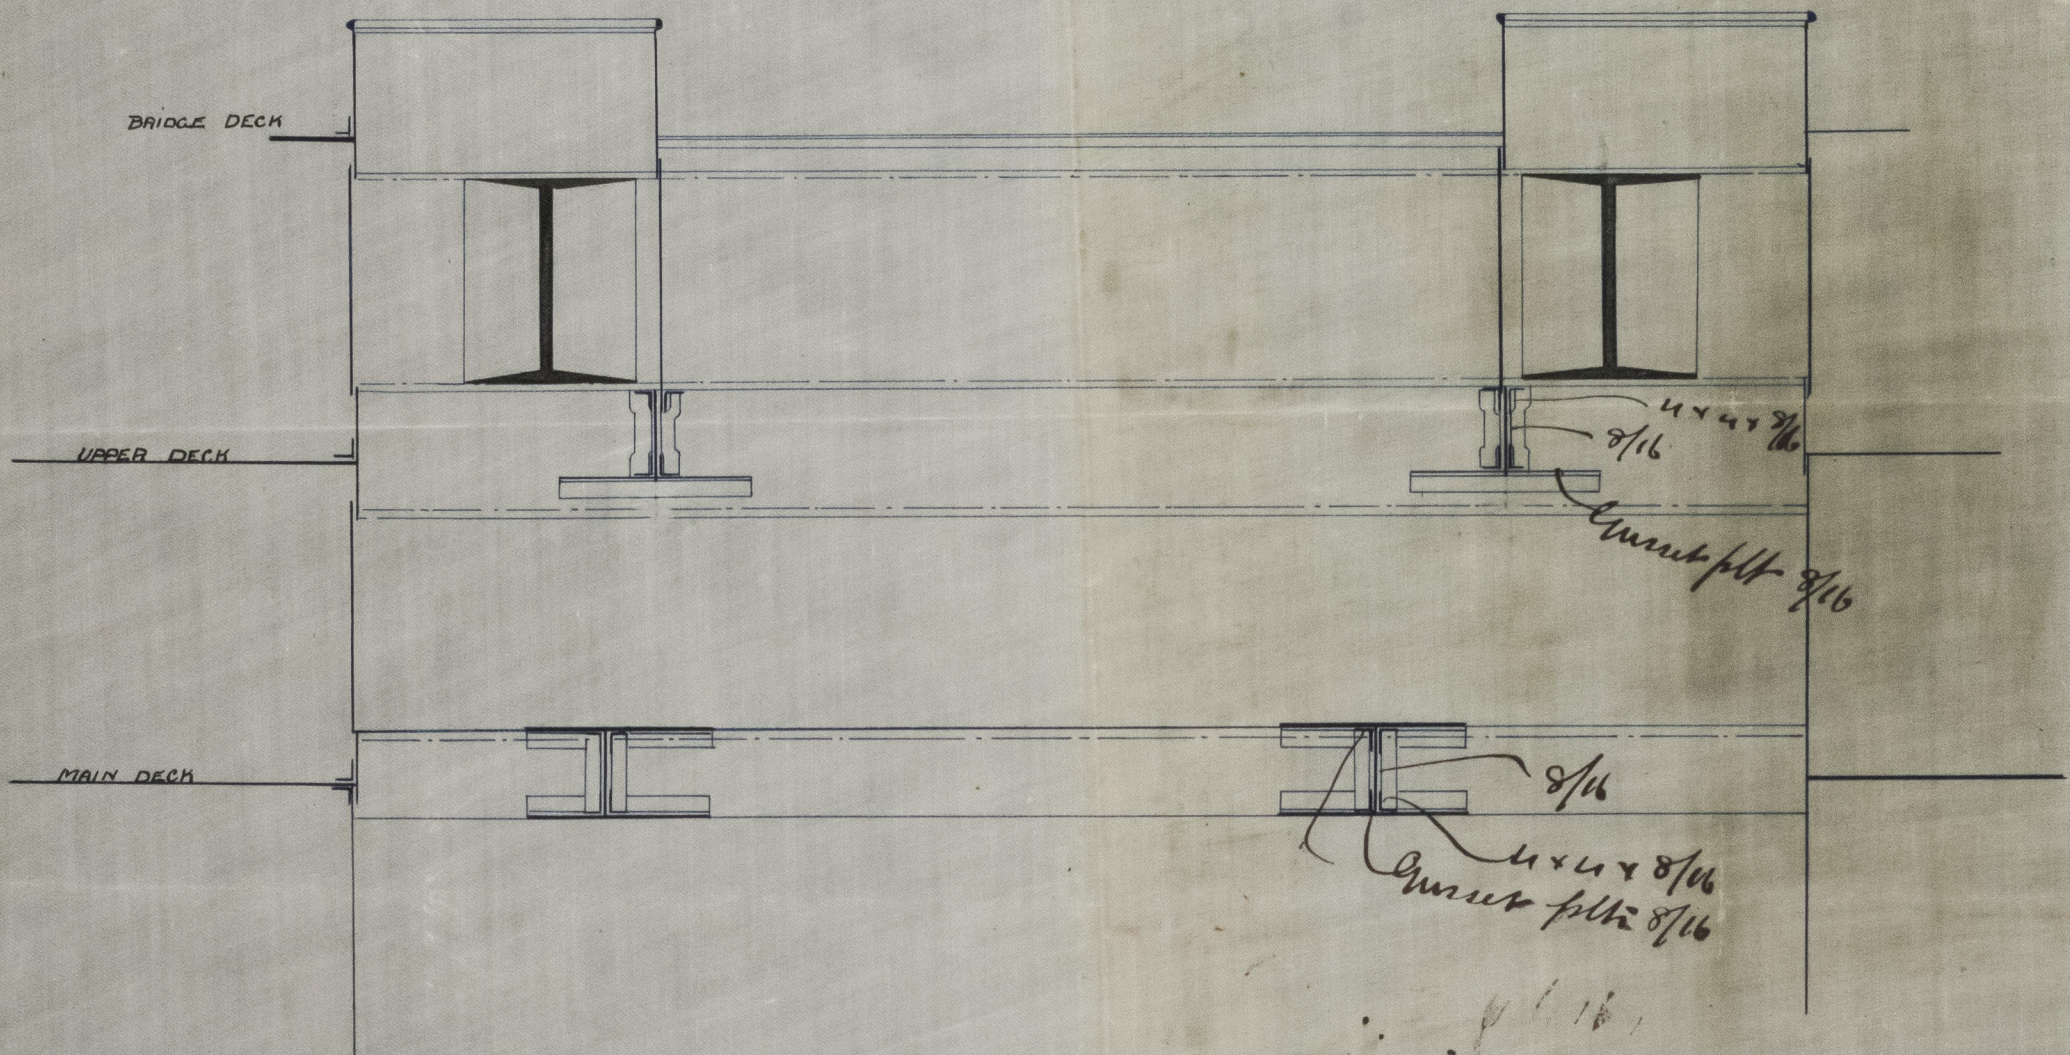

© 2021

Lloyd's Register Foundation

GLS202-0062

Handwritten signature and date 3/11/84.