


LLOYD'S REGISTER OF SHIPPING
RECEIVED
30 JAN. 84
LONDON


Iron S.S. No. 222.

S.S. "Lake Superior" Glasgow Report No. 6905.


PLAN OF TANK TOP UNDER ENGINE SEAT
SCALE 1/4" = ONE FOOT

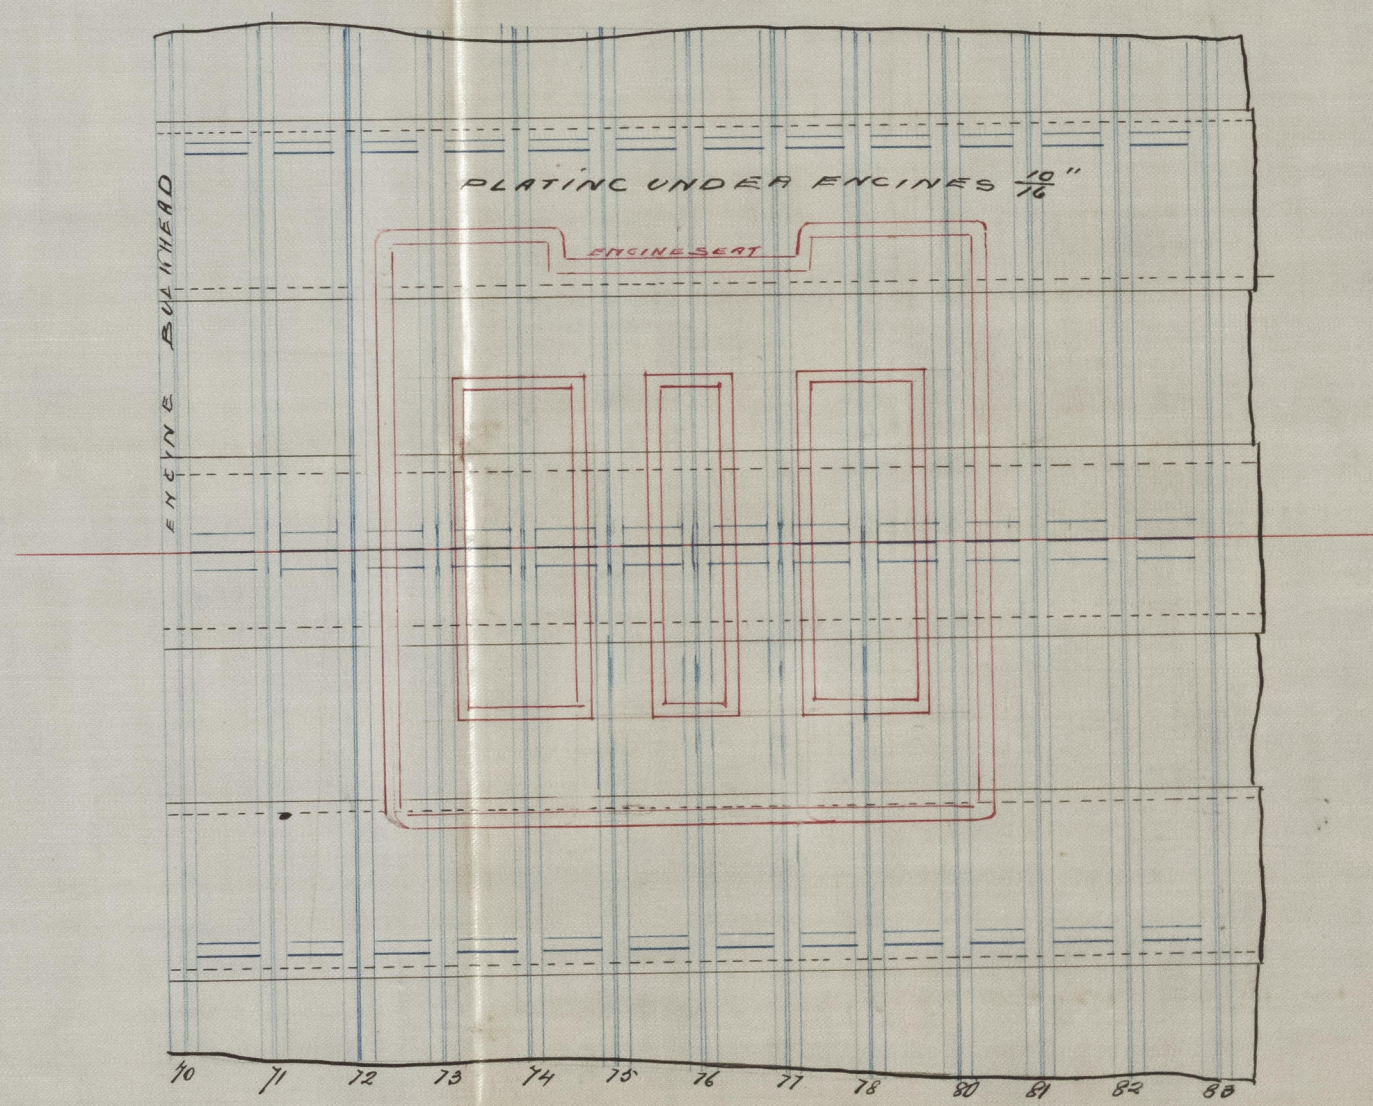

Cast-Steel Engine Rating

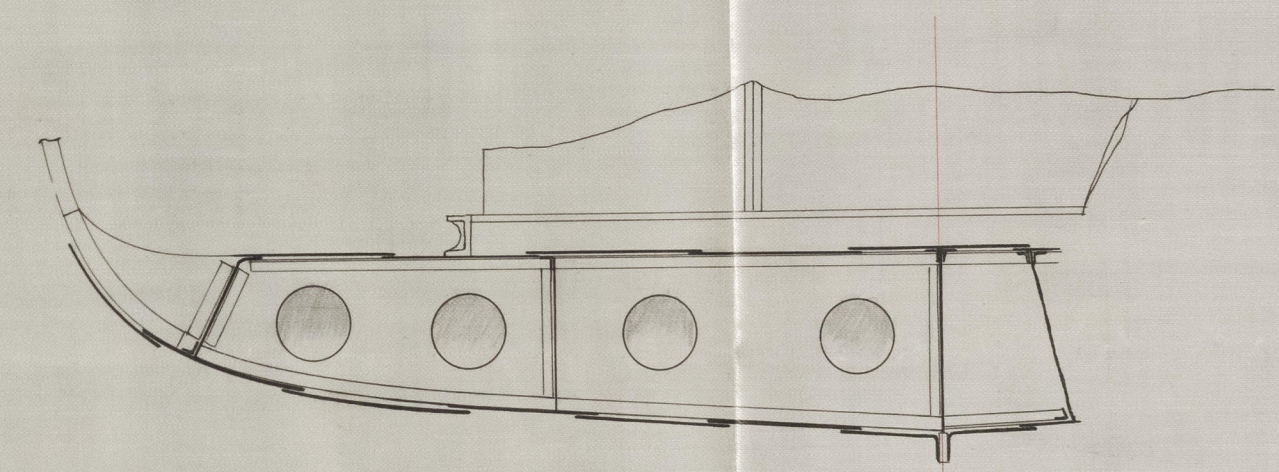

JAMES GEORGE THOMSON,
28-1-84
IRONWORKERS,
GLASGOW & LONDON.

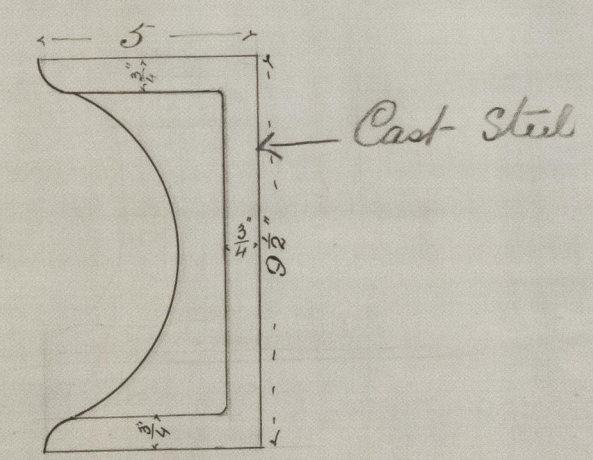

For: 2/1/84

Not now fitted

Glasgow
© 2021
Lloyd's Register
Foundation

GLS202-2066